

MAKING APPROVED ZONING
DATE 1/16/03
FOR
JEFF & LESLIE SMITH

KNOWN AS BEING SUBLT 11 AND PART OF
SUBLT 12 IN THE MOORE'S LANDING
SUBDIVISION AS RECORDED IN VOLUME 35
PAGE 16 OF THE LAKE COUNTY PLAT RECORDS

TOWNSHIP OF MADISON
COUNTY OF LAKE - STATE OF OHIO

"I, THE UNDERSIGNED HEREBY CERTIFY THAT THE
TOPOGRAPHY SHOWN HEREON, INDICATED BY 1
FOOT CONTOURS AND ELEVATIONS REPRESENTS
AN ACTUAL FIELD TOPOGRAPHIC SURVEY MADE
BY ME ON THE 7th DAY OF NOVEMBER, 2003 AND
THAT THE ELEVATIONS WERE TAKEN AT APPROPRIATE
INTERVALS AND THAT AS OF THAT DATE THEY EXISTED
AS INDICATED HEREON."

James A. Ziemba
JAMES A. ZIEMBA, PROFESSIONAL SURVEYOR #7094



DISTURBED AREAS ARE
TO BE RE-SEEDED.
TEMPORARY STONE TO BE
INSTALLED AT DRIVE ENTRANCE.
SEWER AND WATER
CONNECTIONS TO BE VERIFIED
AT TIME OF CONSTRUCTION.

Stormwater Management Plan

Approved as shown and/or noted
JAMES R. GILES, P.E.


County Drainage Engineer

By *6/1/03* Date *6-1-03*

*Install yard drain
Lower finished grades as
shown*

Subject to approval by:

- ☐ Zoning Department
- ☐ LC General Health District
- ☒ LC Soil & Water Conservation District
- ☐ LC Building Department (final approval)

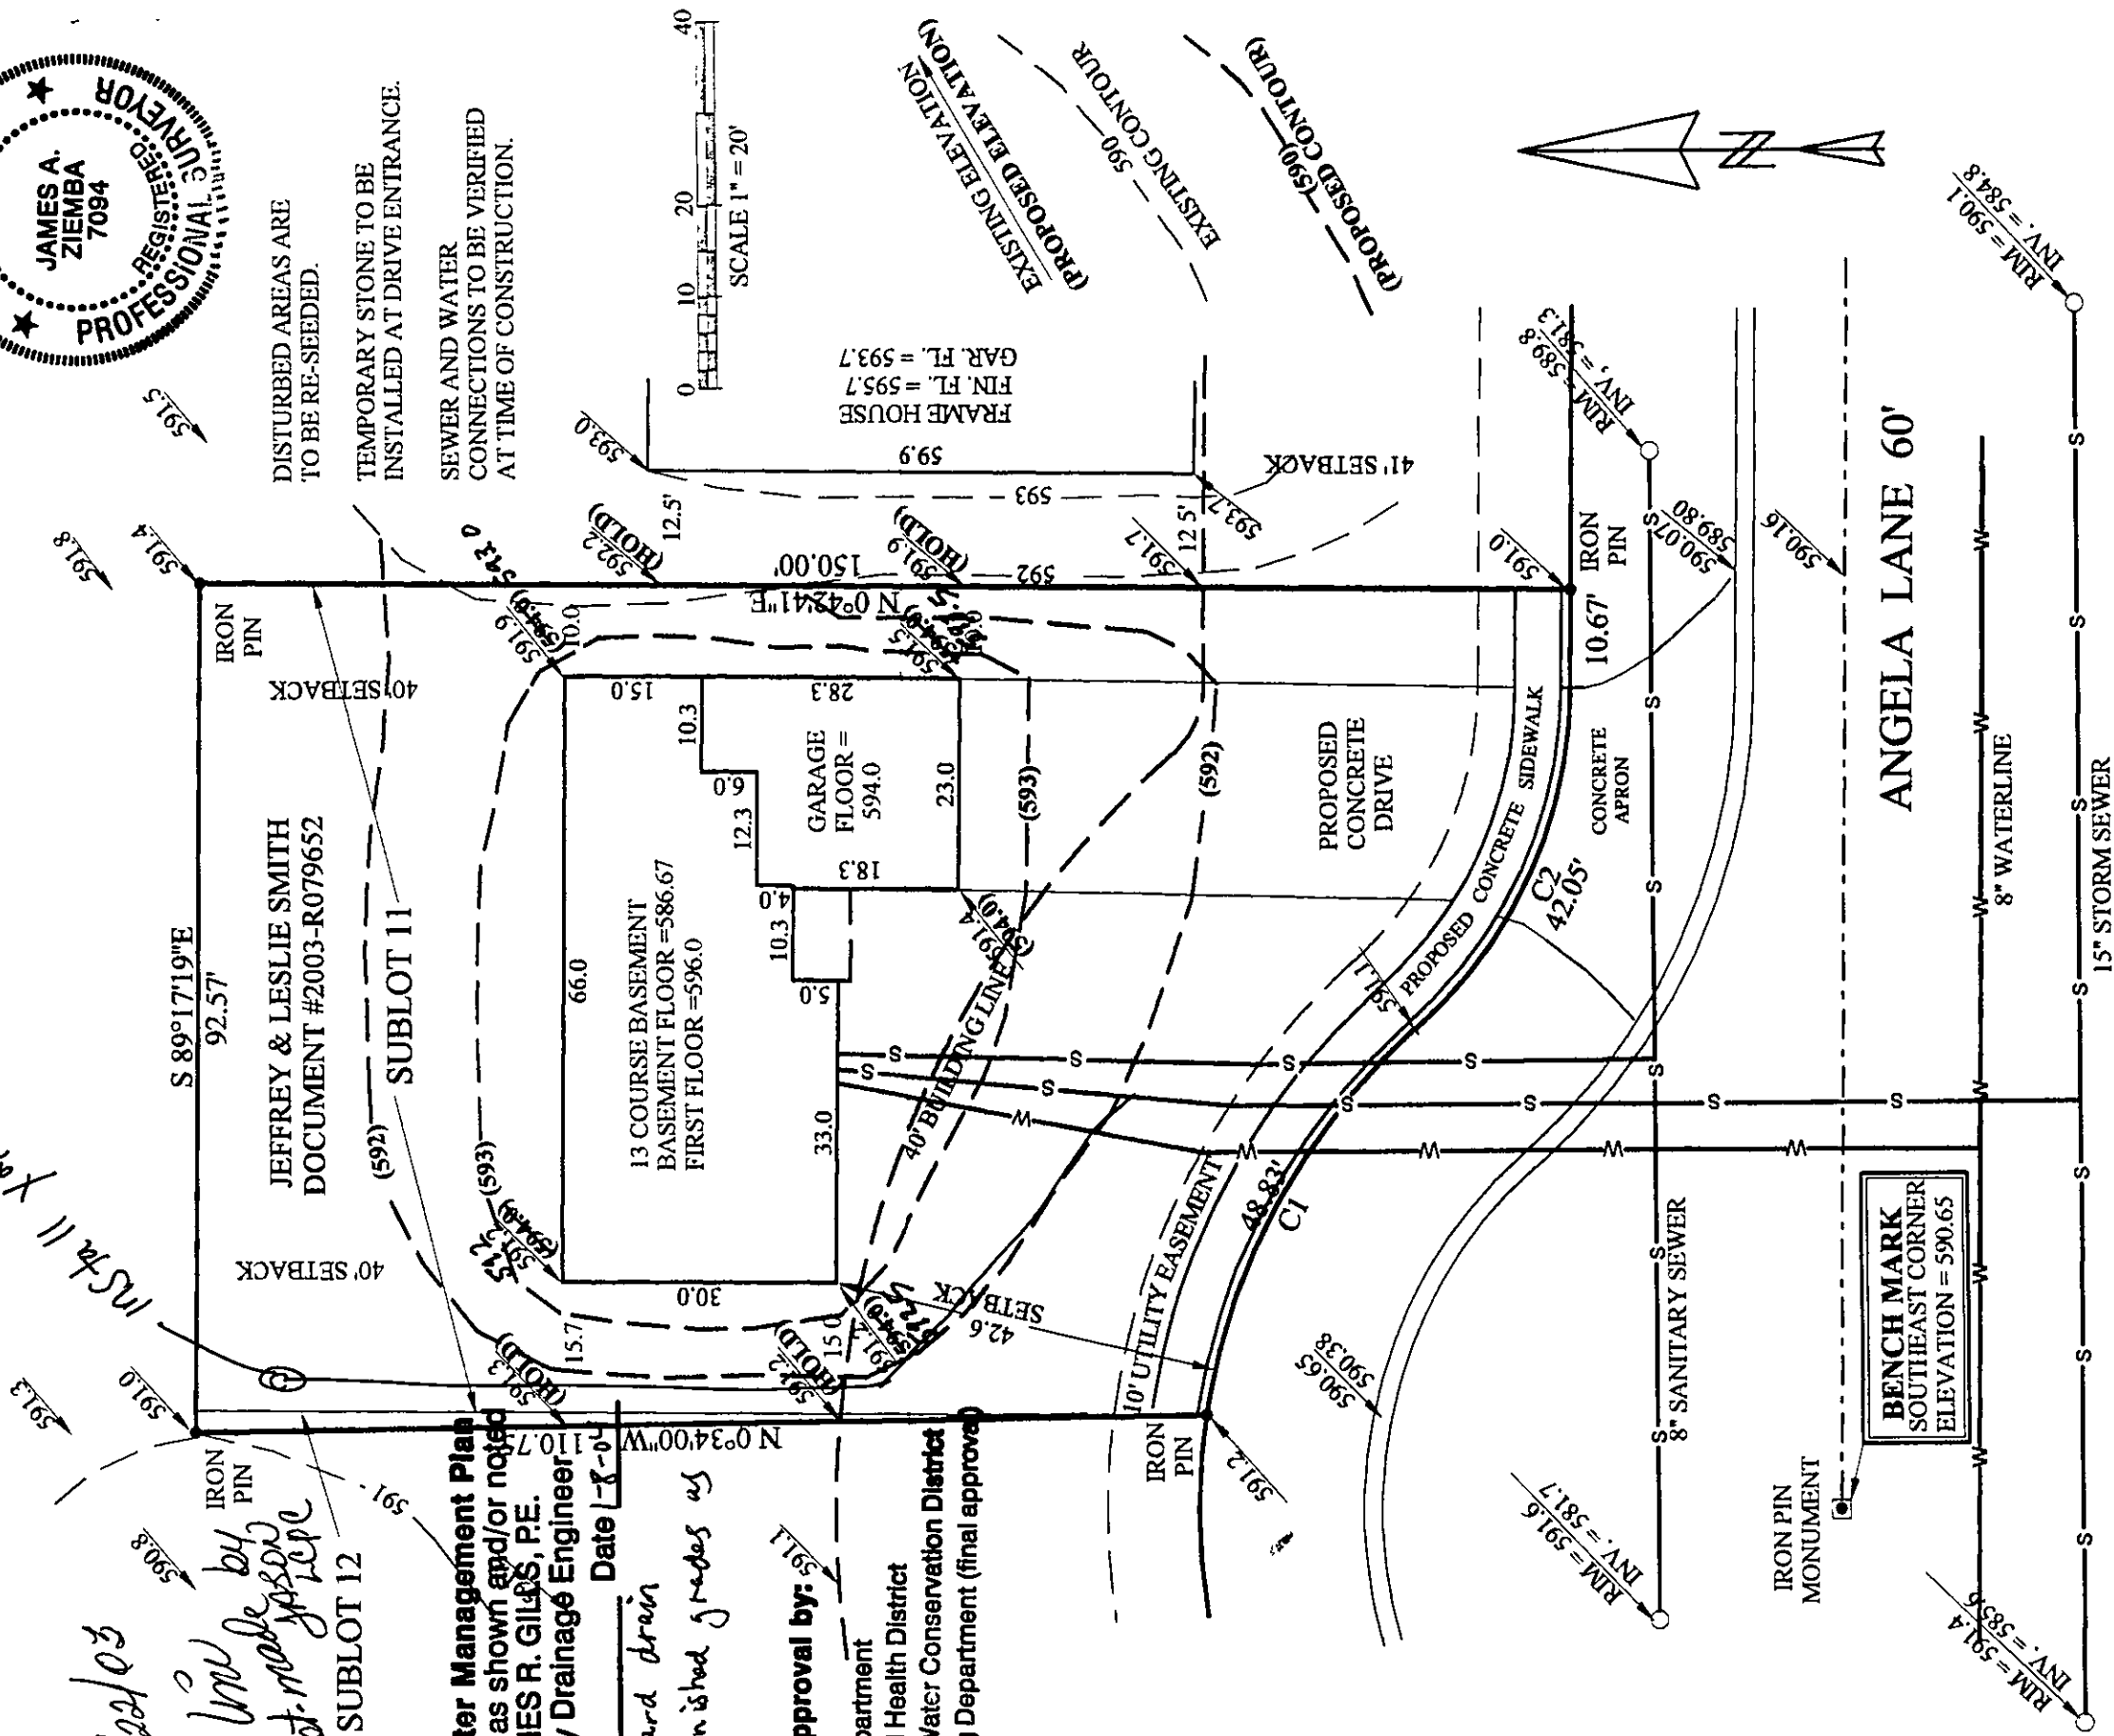

Curve	Delta Angle	Radius	Arc	Chord	Chord Bearing
1	39°58'05"	70.00	48.83	47.85	S.61°-04'-58"E
2	48°11'25"	50.00	42.05	40.82	S.65°-11'-37"E

BENCHMARK SURVEY COMPANY
5964 SOUTH RIDGE ROAD
MADISON, OHIO 44057-9741
NOVEMBER 10, 2003
1-440-428-8599