

NOTES

1. PROPOSED EXISTING GROUND GRADES
2. OVERLAND DRAINAGE FLOW
3. BEUCH MARK TOP OF HVD FRONT OF SUBLOT NO 9 ELEV 592.91
4. --- 590 --- EXISTING CONTOURS
5. --- 590 --- PROPOSED CONTOURS
6. * IPS = 518" IRON P.U. SET WITH CAP.
7. ROOF DRAINS SHALL DISCHARGE TO SPASH BLOCKS SIL 9
8. SUMP PUMP TO BE INSTALLED FOR FOOTER DRAINS
9. CONTACT GUYS TWO WORKING DAYS BEFORE DIGGING - 1-800-362-2764

I CERTIFY THAT THE BOUNDARY SURVEY IS IN ACCORDANCE WITH CURRENT MINIMUM STANDARDS FOR BOUNDARY SURVEYS IN THE STATE OF OHIO

Ralph W. Kempke P.S. 6257

I HEREBY CERTIFY THAT ACTUAL FIELD OBSERVATION OF ELEVATIONS HAVE BEEN MADE BY ME ON OCT. 7, 2002 THE CIRCLED GRADES ACCURATELY DEPICT THE AS-BUILT CONDITIONS OBSERVED BY ME ON

Ralph W. Kempke P.S. 6257





FINISH FLOOR GRADES

GARAGE FLOOR 591.08
1ST FLOOR 593.33
BASEMENT FLOOR 594.67
BOTTOM OF FOOTER 593.67

SIL 9
VACANT LOT
589.8 F.G. - 591.4
PROPOSED



Ralph W. Kempke

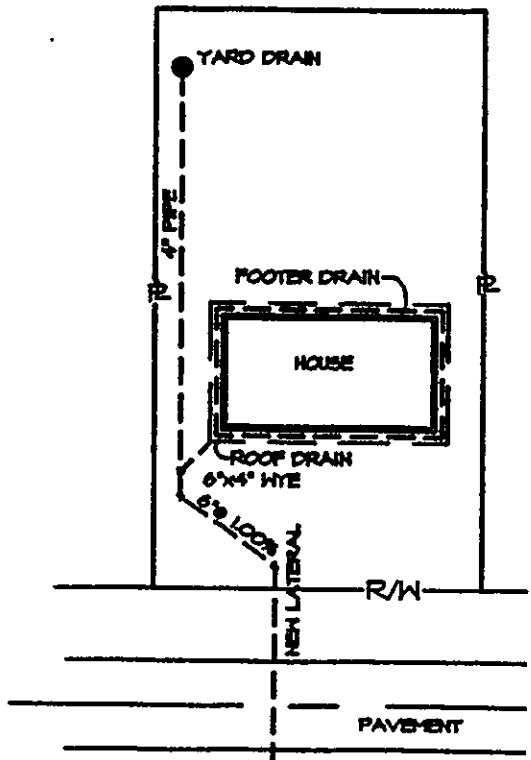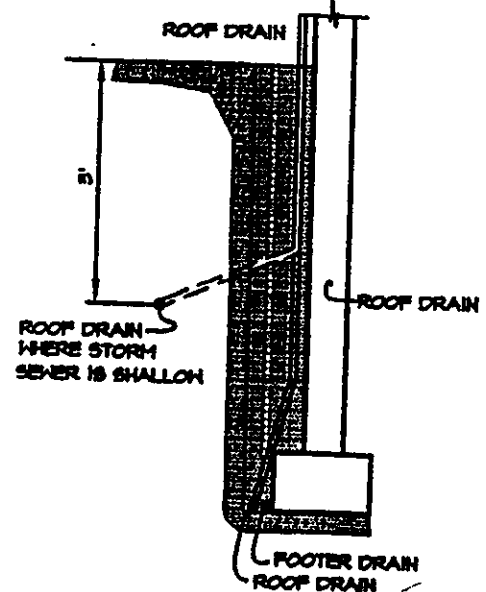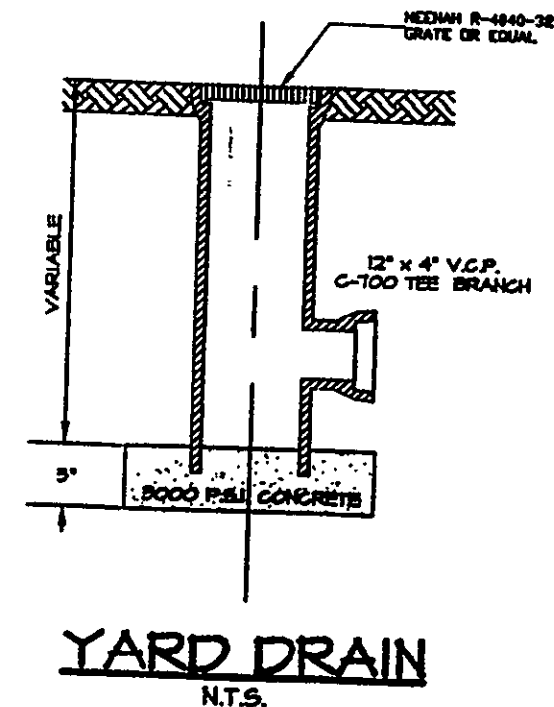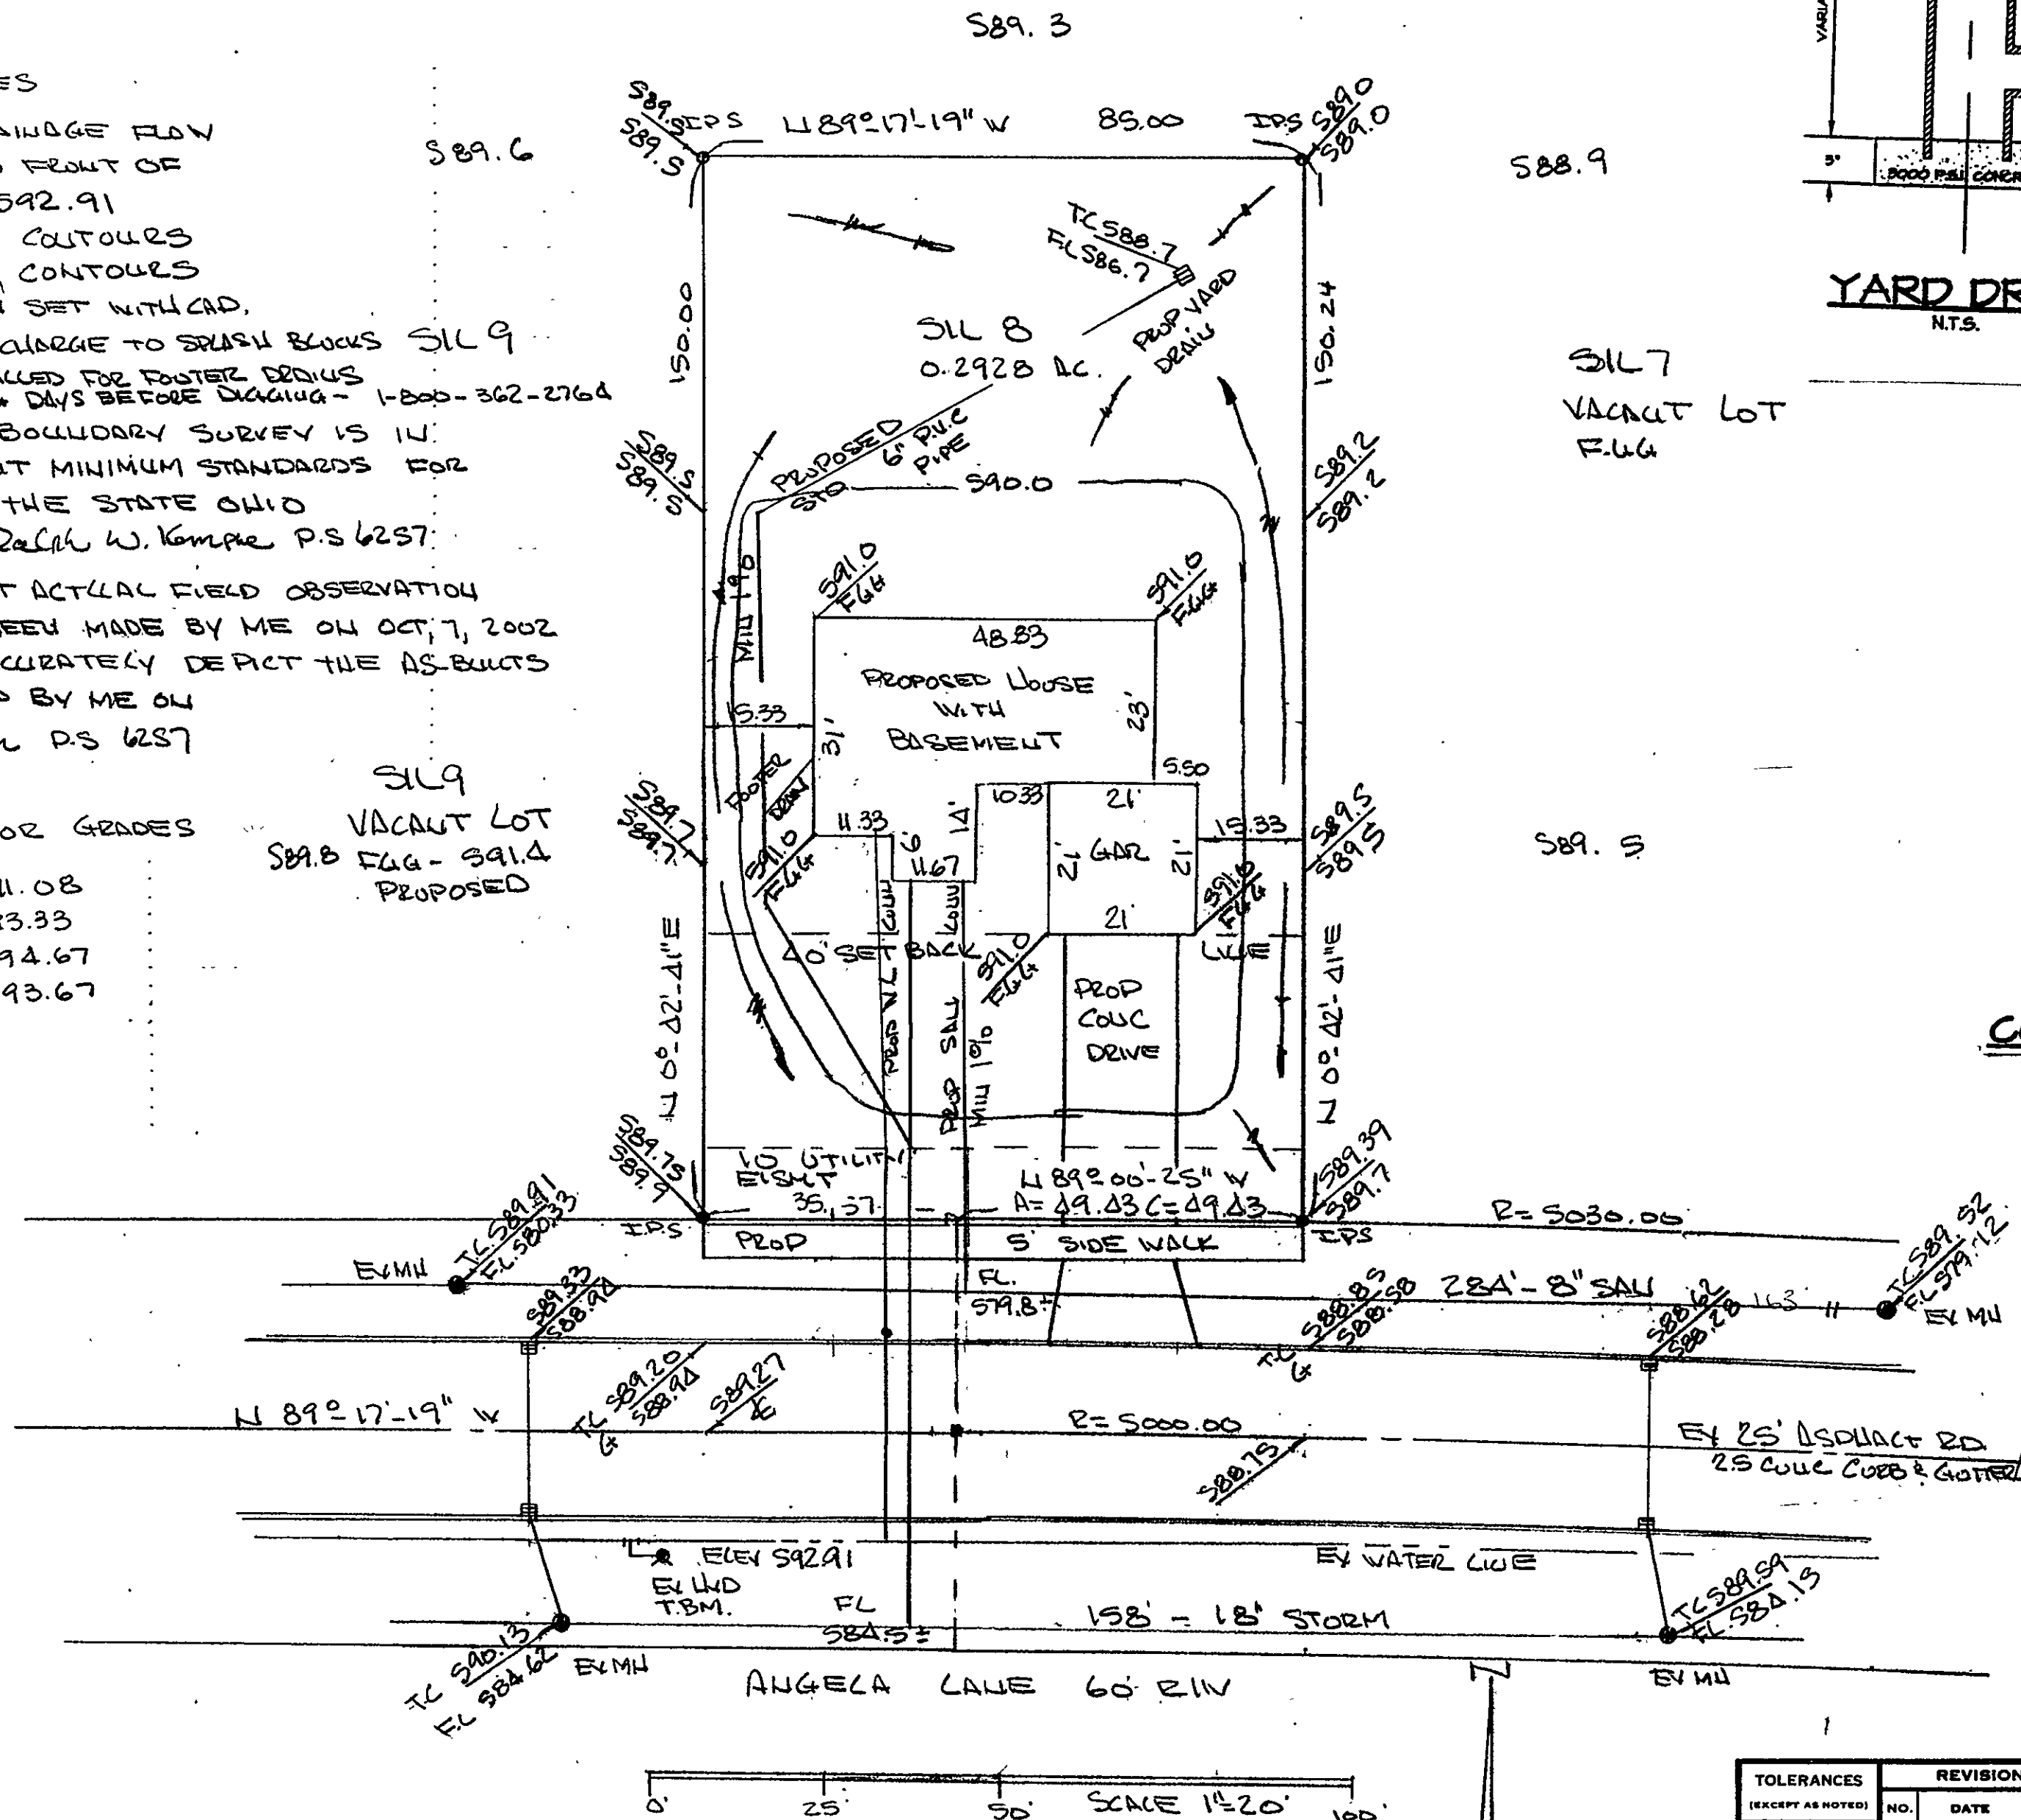

CONSTRUCTION DETAIL

Grading Plan Approved as shown and/or noted by J. GILLES, P.E. Lake County Engineer
By GJH Date 10/21/02

APPROVED MADISON TOWNSHIP ZONING
DATE 10/17/02
BY DM 21147

TOLERANCES (EXCEPT AS NOTED)		REVISIONS			SITE PLAN FOR CUSTOM CRAFTED HOMES		
DECIMAL	±	NO.	DATE	BY	OF SUBLOT NO 8 IN MOORE'S CADDWG SUBD VOL 35 PAGE 16		
FRACTIONAL	±	1			DRAWN BY	SCALE 1/4"=20'	MATERIAL
ANGULAR	±	2			CHK'D	DATE 10-07-02	DRAWING NO.
		3			TRACED	APP'D	
		4					
		5					