

NOTES




1. PROPOSED EXISTING GROUND GRADES
2. OVERLAND DRAINAGE FLOW
3. BENCH MARK TOP OF H&D FRONT OF SUBLOT NO 9 ELEV 592.91
4. -S90- EXISTING CONTOURS
5. -S90- PROPOSED CONTOURS
6. *I.P.S. = 5/8" IRON PIN SET WITH CAP.
7. ROOF DRAINS SHALL DISCHARGE TO SPLASH BLOCKS
8. CONTACT OLPS TWO WORKING DAYS BEFORE DRAINAGE 1-800-362-2764

I CERTIFY THAT THE BOUNDARY SURVEY IS IN ACCORDANCE WITH CURRENT MINIMUM STANDARDS FOR BOUNDARY SURVEYS IN THE STATE OF OHIO
 Ralph W. Kempke P.S.# 6257

I HEREBY CERTIFY THAT ACTUAL FIELD OBSERVATION OF ELEVATIONS HAVE BEEN MADE BY ME ON OCT 7, 2002 THE CIRCLED GRADES ACCURATELY DEDICT THE AS-BUILT CONDITIONS OBSERVED BY ME ON


Ralph W. Kempke P.S.# 6257
 FINISH FLOOR GRADES

GARAGE FLOOR S90.68
 1ST FLOOR S91.93

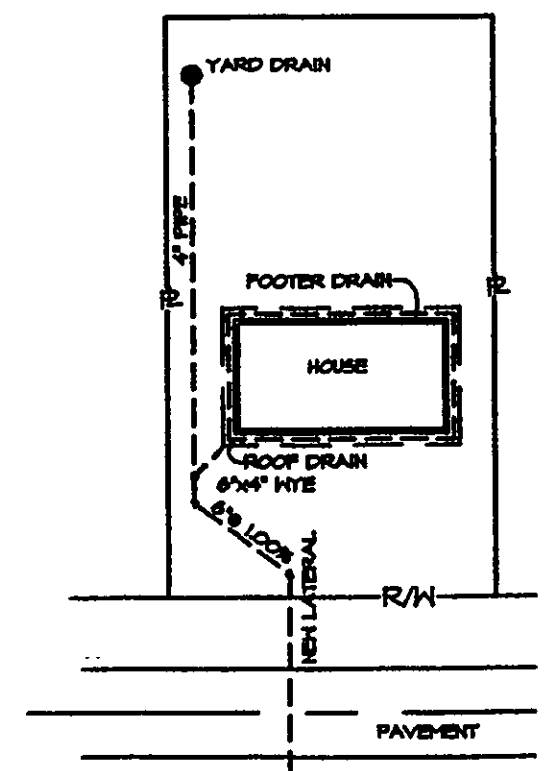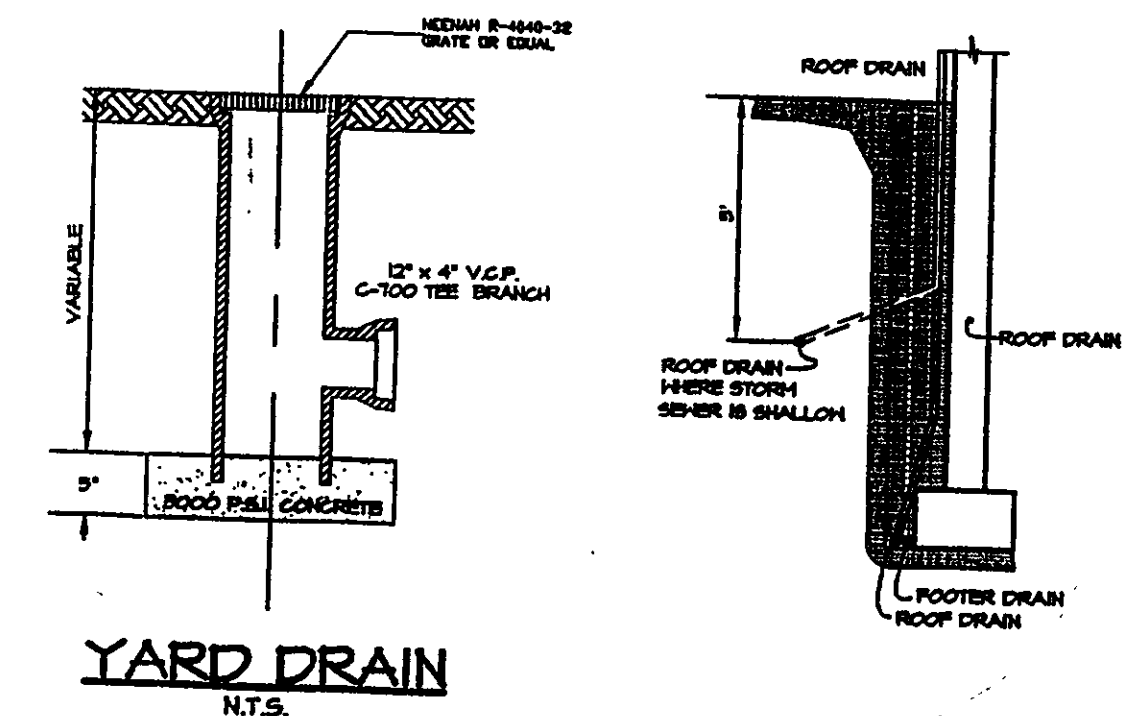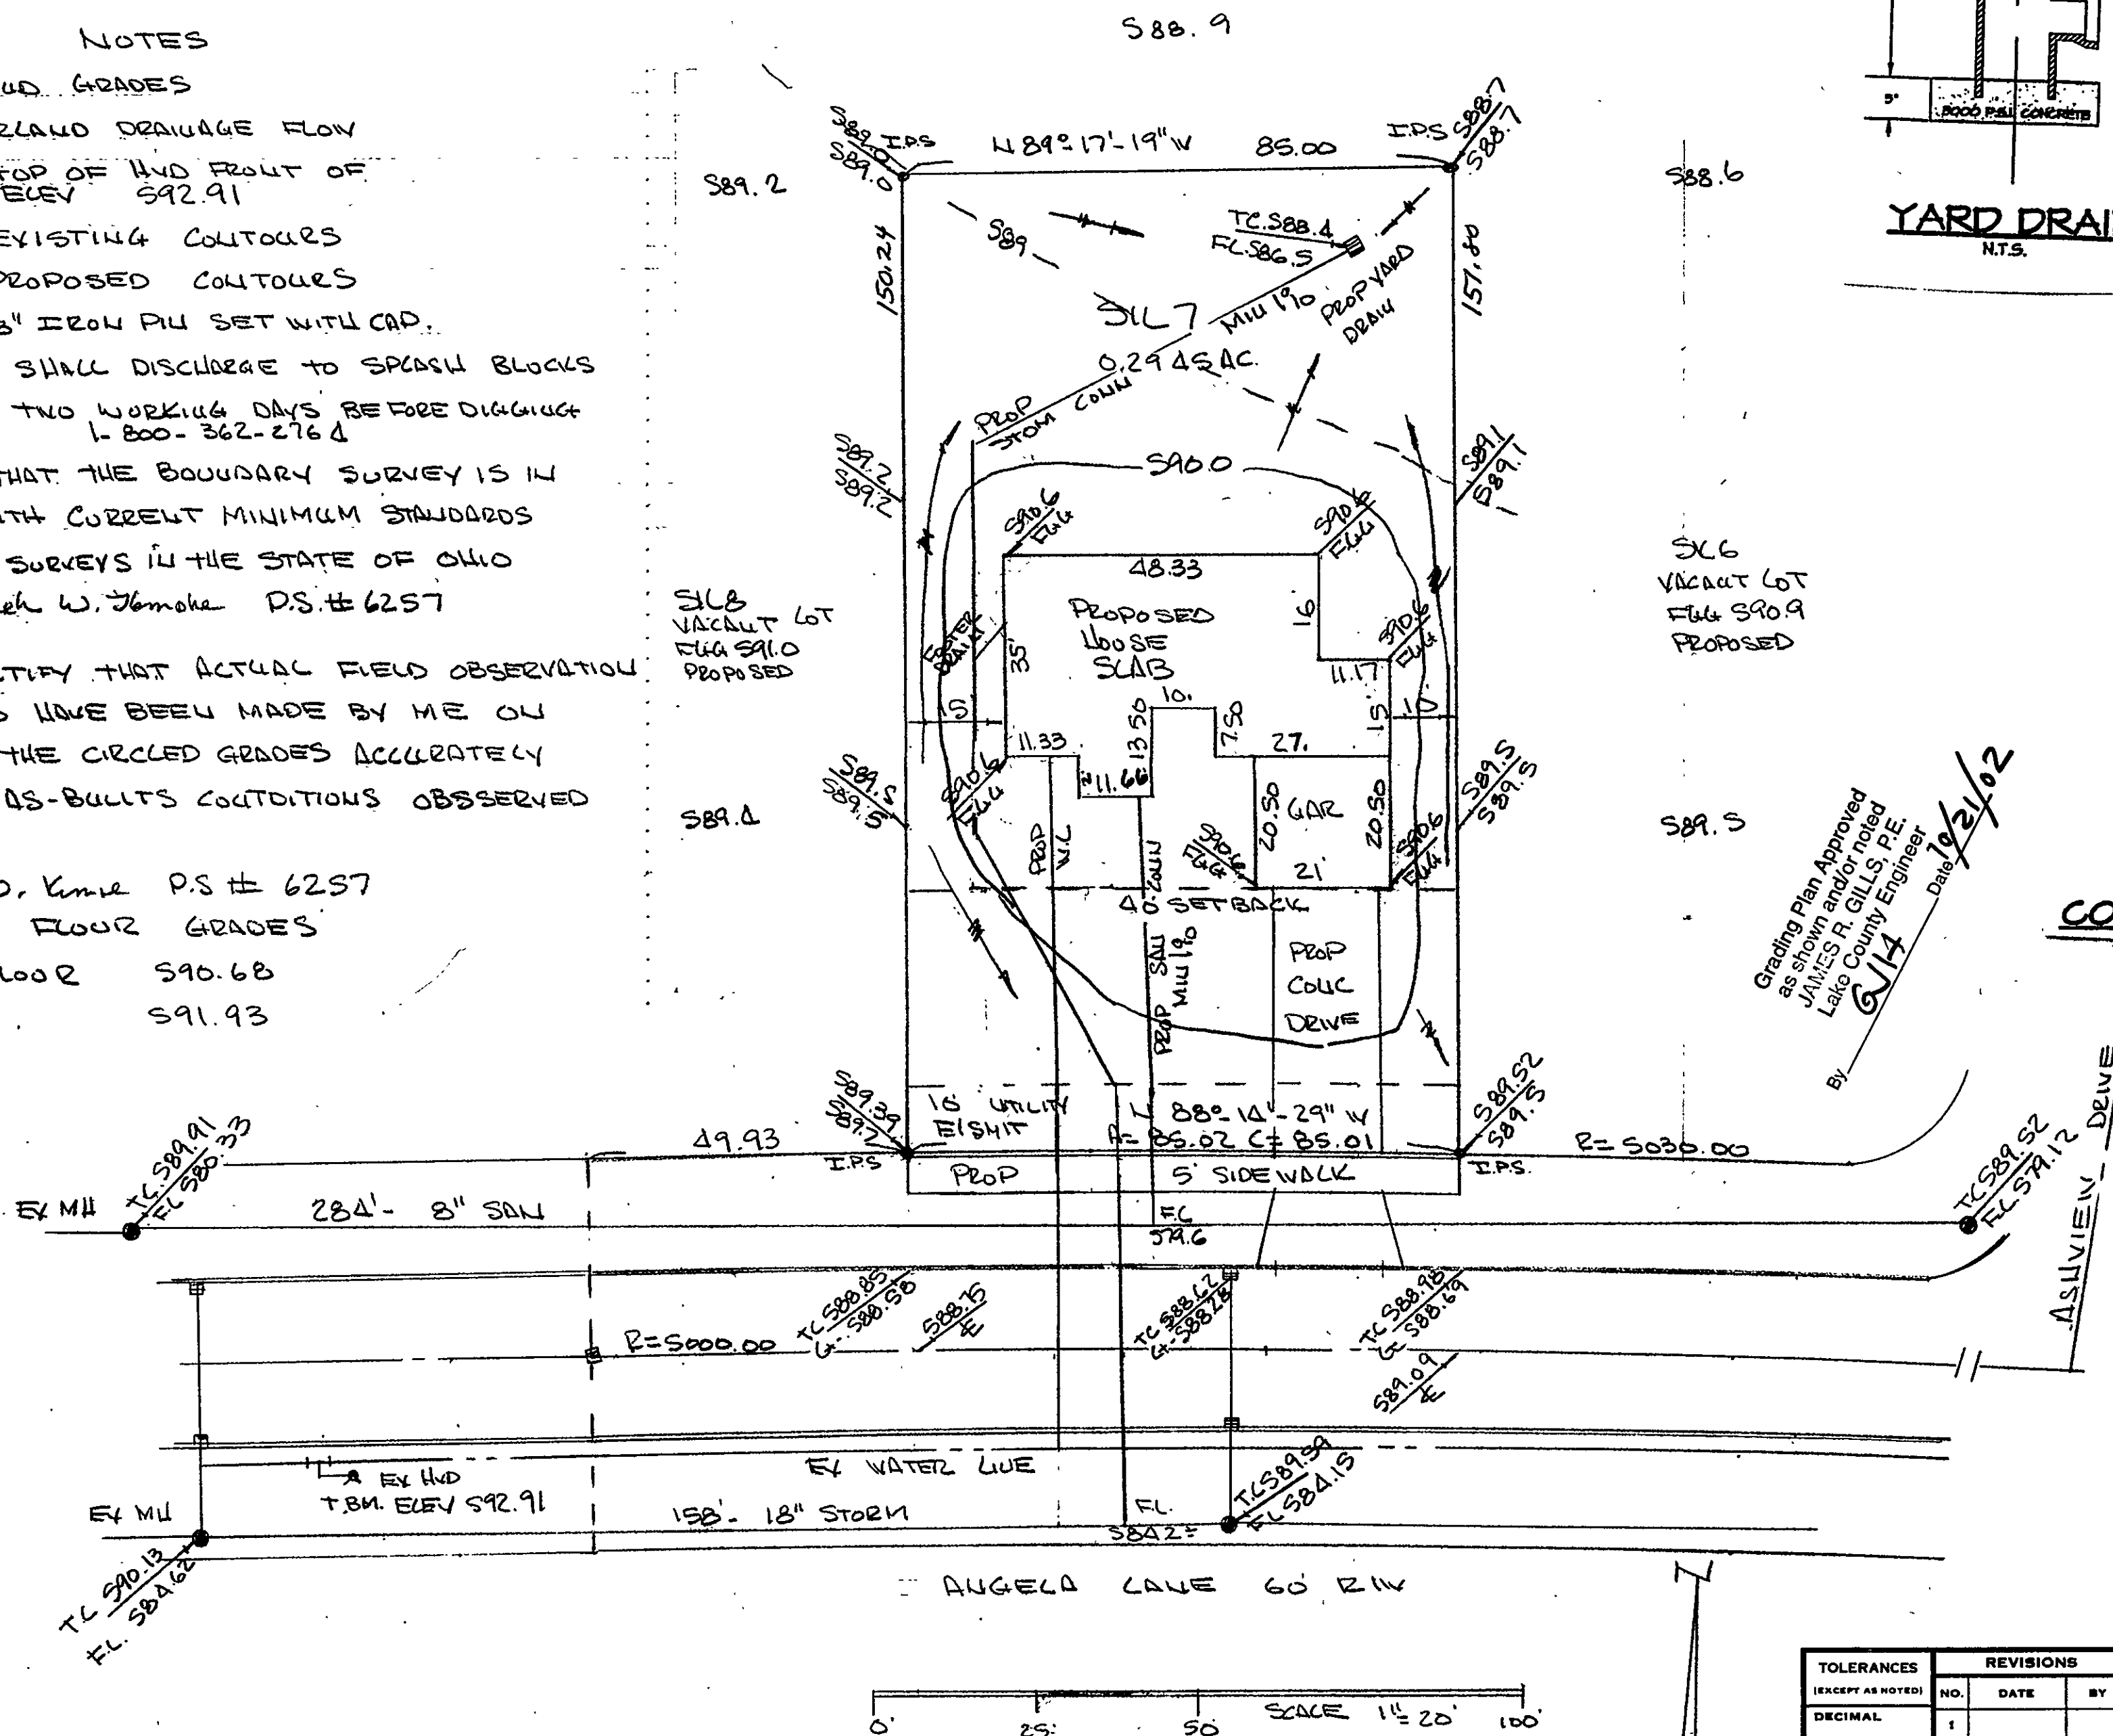

Grading Plan Approved
 as shown and/or noted
 JAMES R. GILLIS, P.E.
 Lake County Engineer
 Date 10/21/02
 By GJH

CONSTRUCTION DETAIL
 N.T.S.

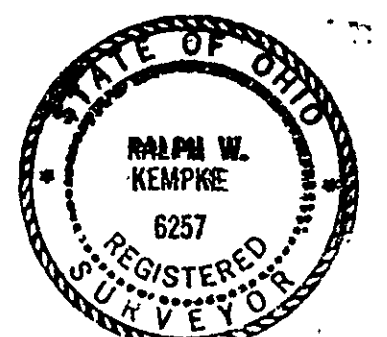

Ralph W. Kempke

APPROVED
 MADISON TOWNSHIP ZONING
 DATE 10/19/02
 BY JH 21148

TOLERANCES (EXCEPT AS NOTED)			REVISIONS			SITE PLAN FOR CUSTOM CRAFTED HOMES OF SUBLOT NO 7 IN MOORE'S CLADDING SUBD. VOL 35 PAGE 16		
DECIMAL	FRACTIONAL	ANGULAR	NO.	DATE	BY	DRAWN BY	SCALE	MATERIAL
±	±	±	1			CHK'D	DATE	DRAWING NO.
±	±	±	2			TRACED	10.07.02	
±	±	±	3					
±	±	±	4					
±	±	±	5					