
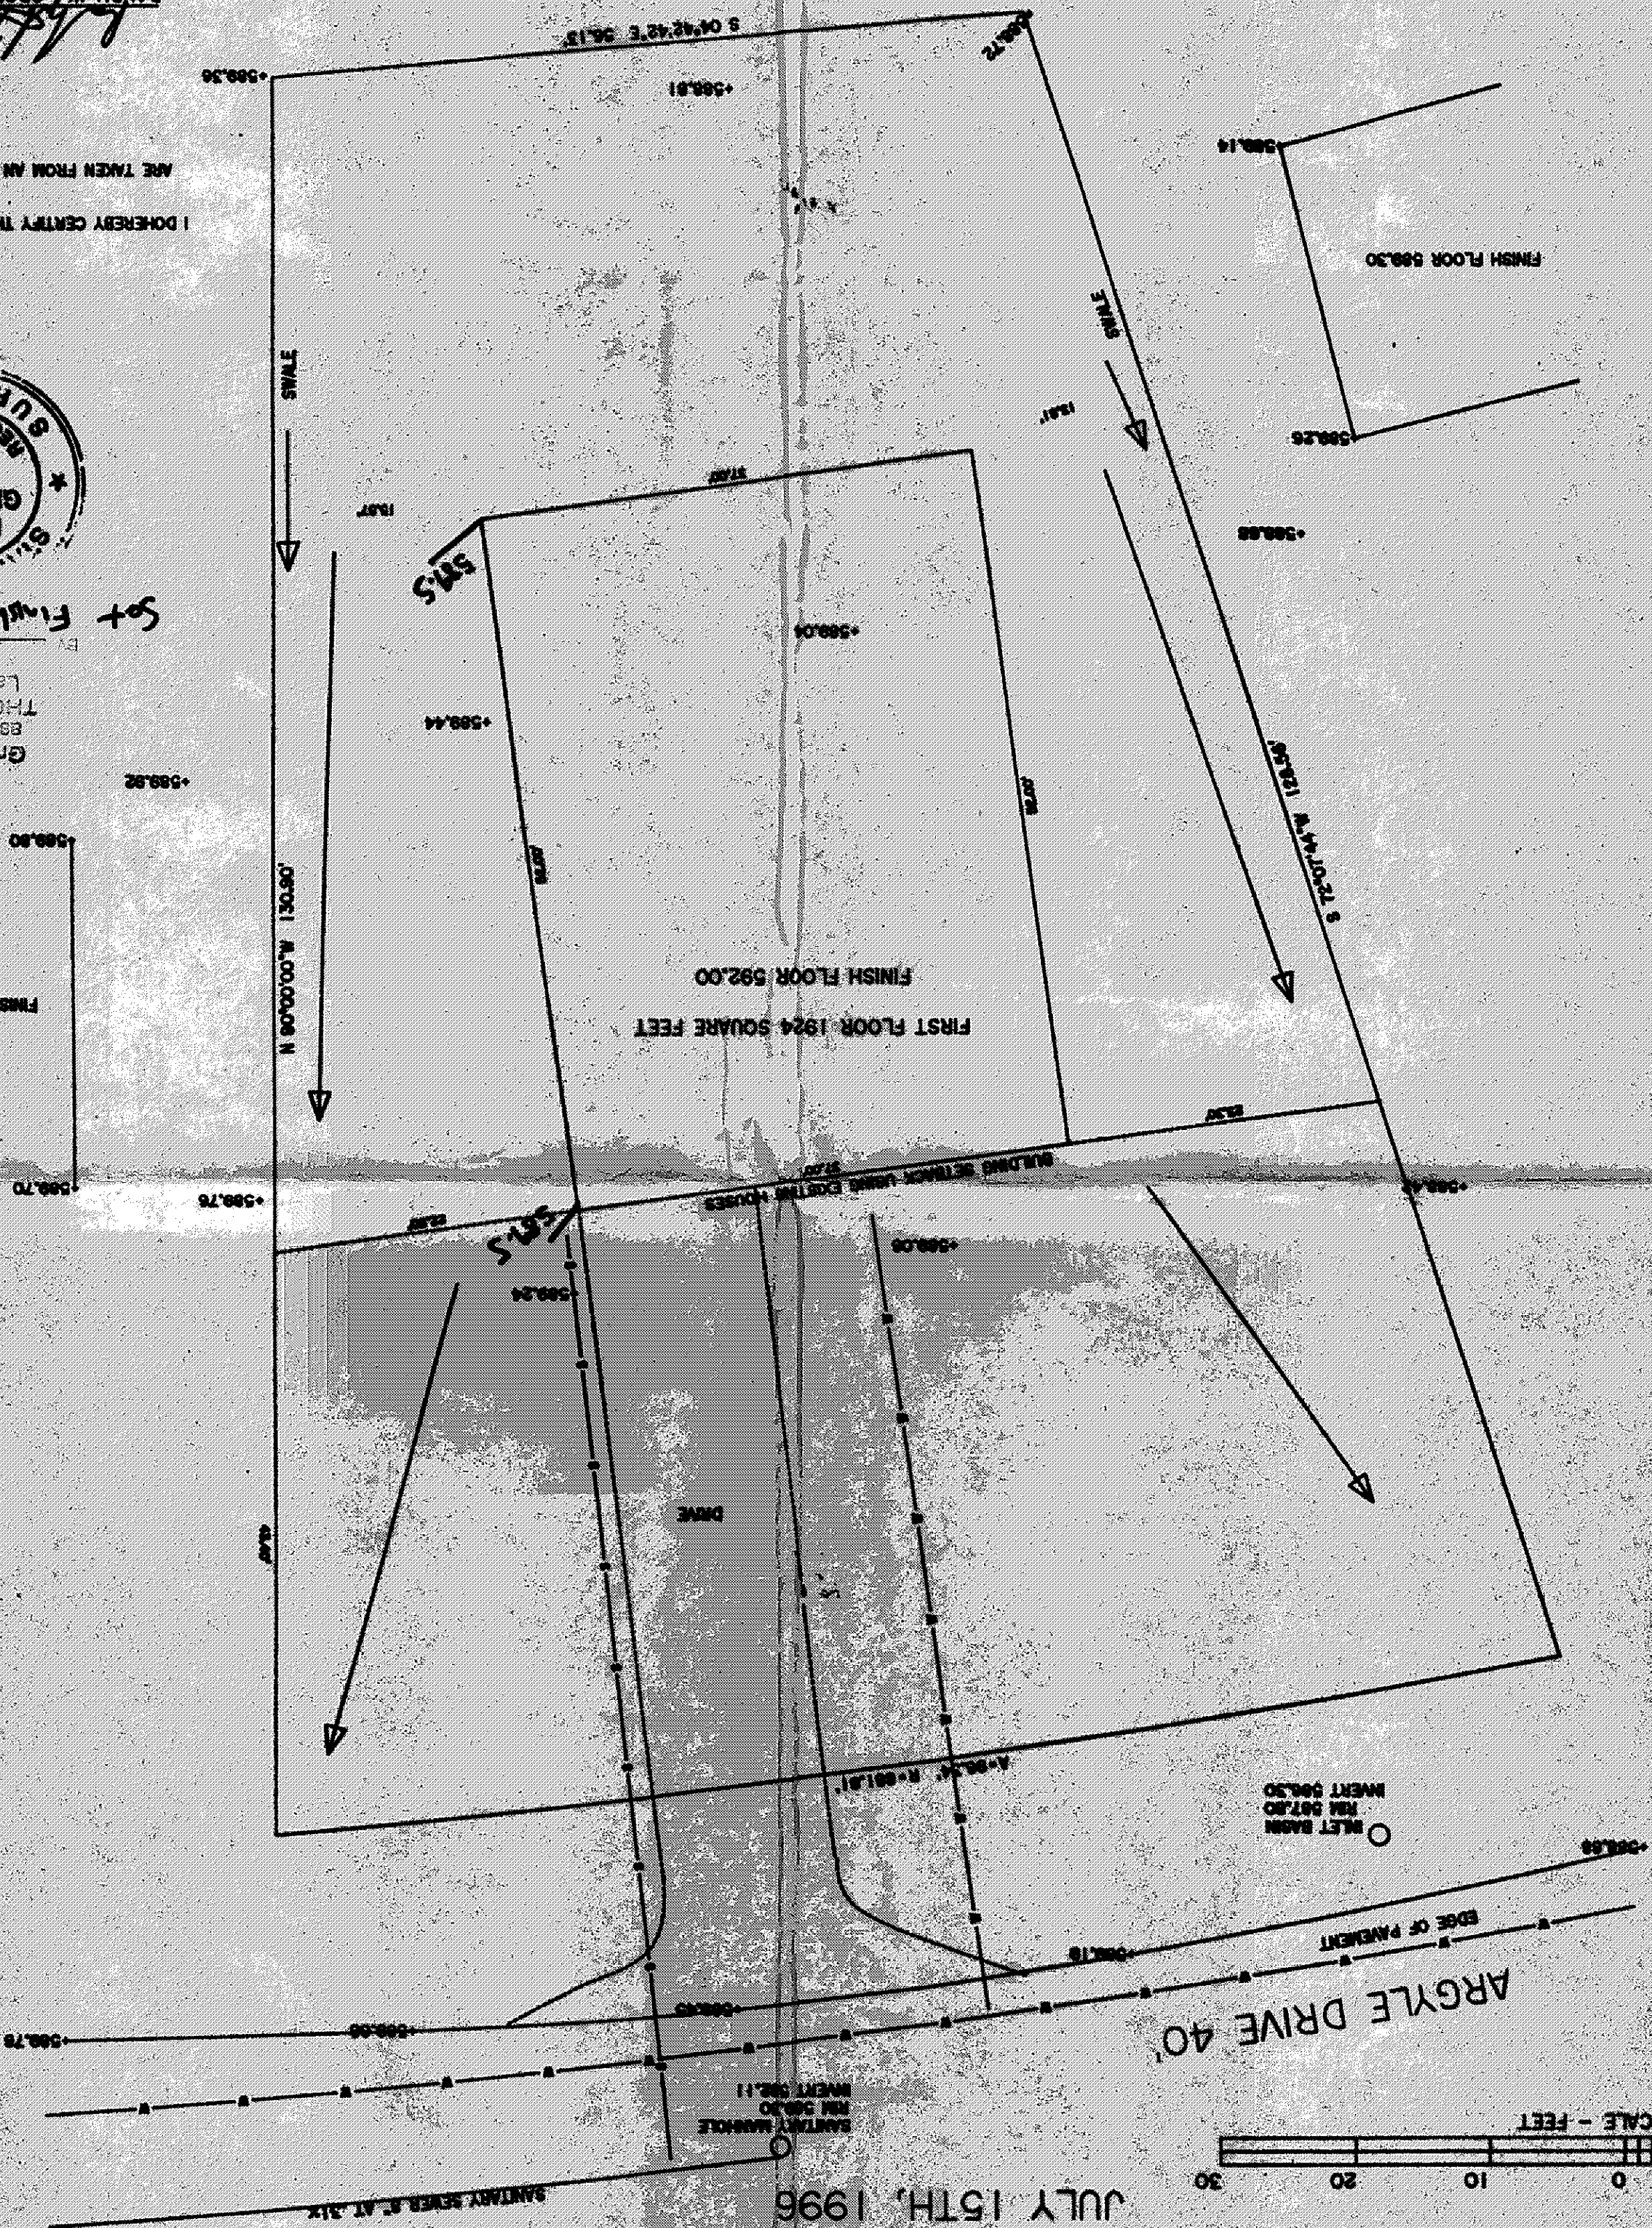
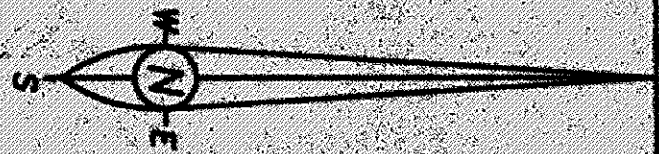


SITE PLAN
FOR
MARGARET WICKERT
PART OF LOT 81 MADISON BEACH SUBDIVISION
TOWNSHIP OF MADISON, COUNTY OF LAKE
STATE OF OHIO

JULY 15TH, 1996

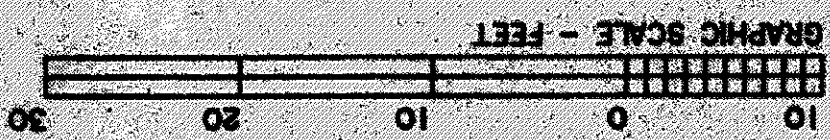

PLAT PREPARED BY
RALPH W. GROMLEY
35650 LAKELAND BOULEVARD
EASTLAKE, OHIO
216 953 1338

APPROVED
MADISON TOWNSHIP ZONING
JUL 29 1996
PERMIT # 150172
ZONING INSPECTOR

RALPH W. GROMLEY, P.E., No. 7431
[Signature]

I DO HEREBY CERTIFY THAT THE ABOVE ELEVATIONS
ARE TAKEN FROM AN ACTUAL FIELD SURVEY.

Set Finished grade = 589.5
Date 8-6-96
By L.W.
Grading Plan Approved
as shown and/or noted
THOMAS P. GILLES, P.E.
Lake County Engineer