


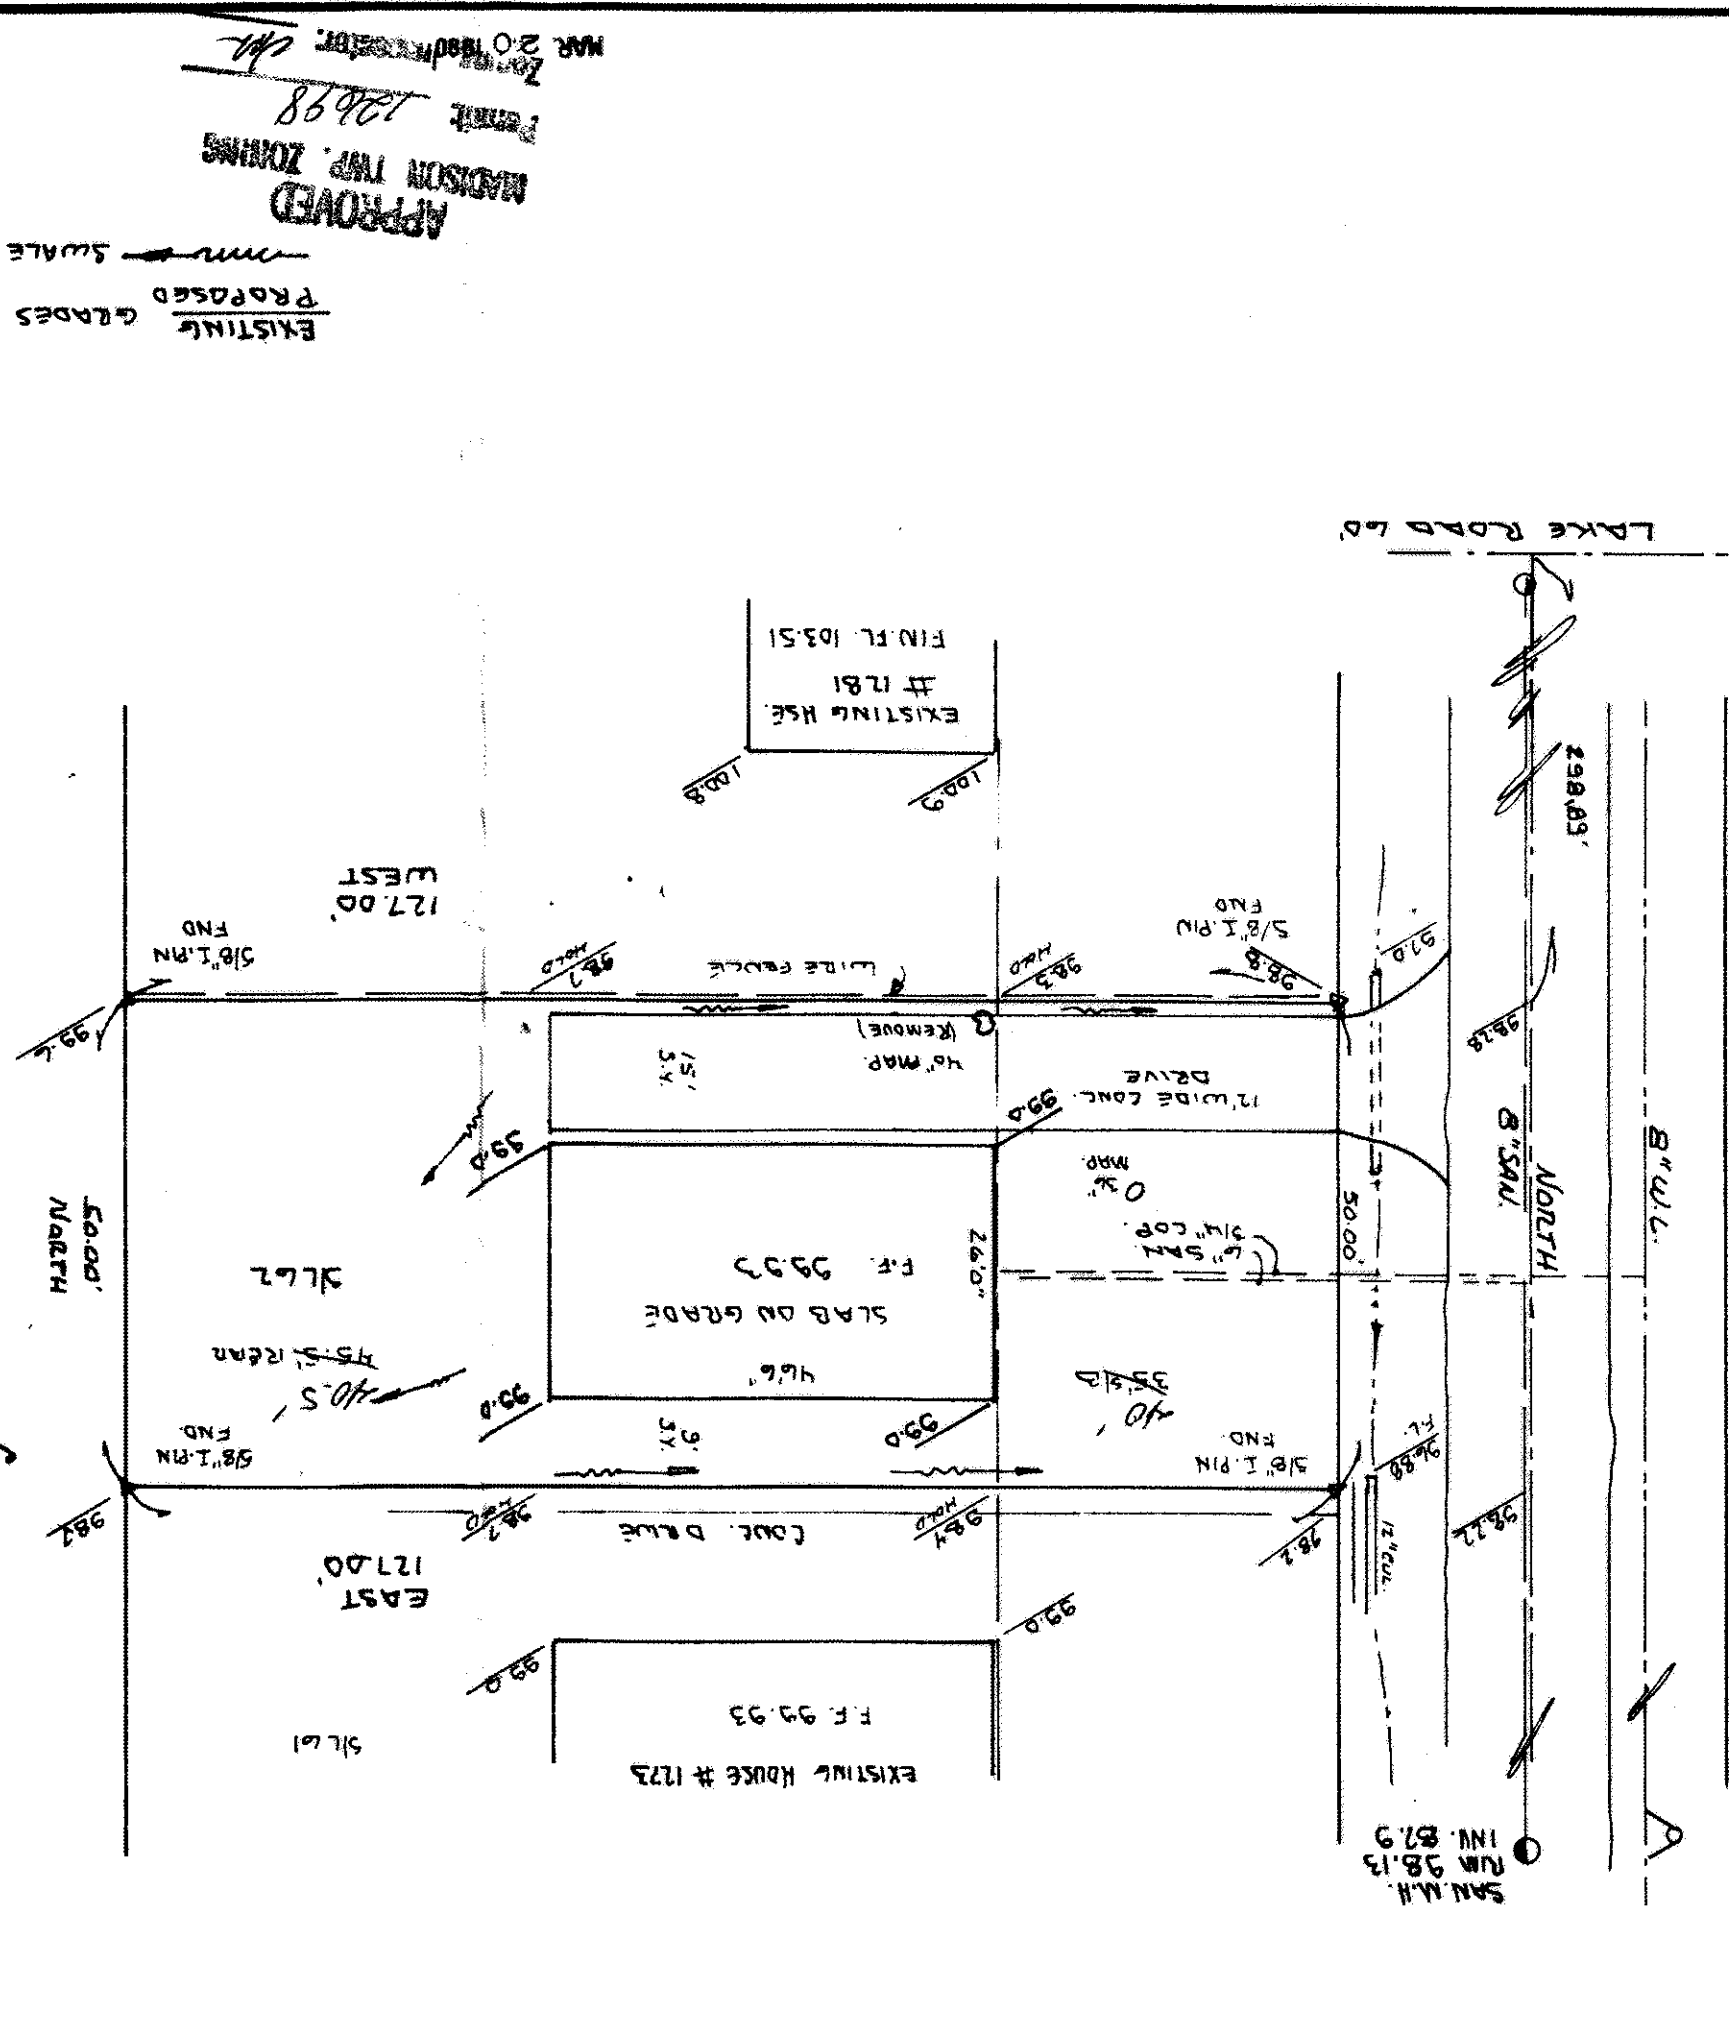

EXISTING GRADES PROPOSED

~~mm~~ SCALE

APPROVED

MADISON TWP. ZONING

Permit 12698

20180301 CH

MAR 20 10 58 AM '18

90-321

BEING SUBLOT 62 IN THE MADISON BEACH SUBDIVISION F-47
TOWNSHIP OF MADISON COUNTY OF LAKE STATE OF OHIO

I CERTIFY THAT THIS PLAN
WAS PREPARED BY ME AND
IS CORRECT TO THE BEST OF
MY KNOWLEDGE AND BELIEF

John C. Skonieczny
REG. SURVEYOR #63366

JOHN C. SKONIECZNY
7739 VIEWMOUNT DR.
PAINESVILLE, OHIO 44077
PH. 352-7742



Grading Plan Approved
as shown and/or noted
THOMAS P. GILLES, P.E.
Lake County Engineer
GJH
Date 3/22/80