

Grading Plan Approved
as shown and/or noted
THOMAS F. GILLES, P.E.
Lake County Engineer


SITE PLAN
for
ANDY GULYAS

Sublot 85 and part sublot 84
MADISON GOLF LAKELANDS RESUB.

APPROVED
MADISON TWP. ZONING
Permit: 8823

J.W.K. Date 12 June 73
MADISON TWP. LAKE CO. O.
1" = 30' June 1973

Miller A. Goodenow
Reg. Surveyor #4247

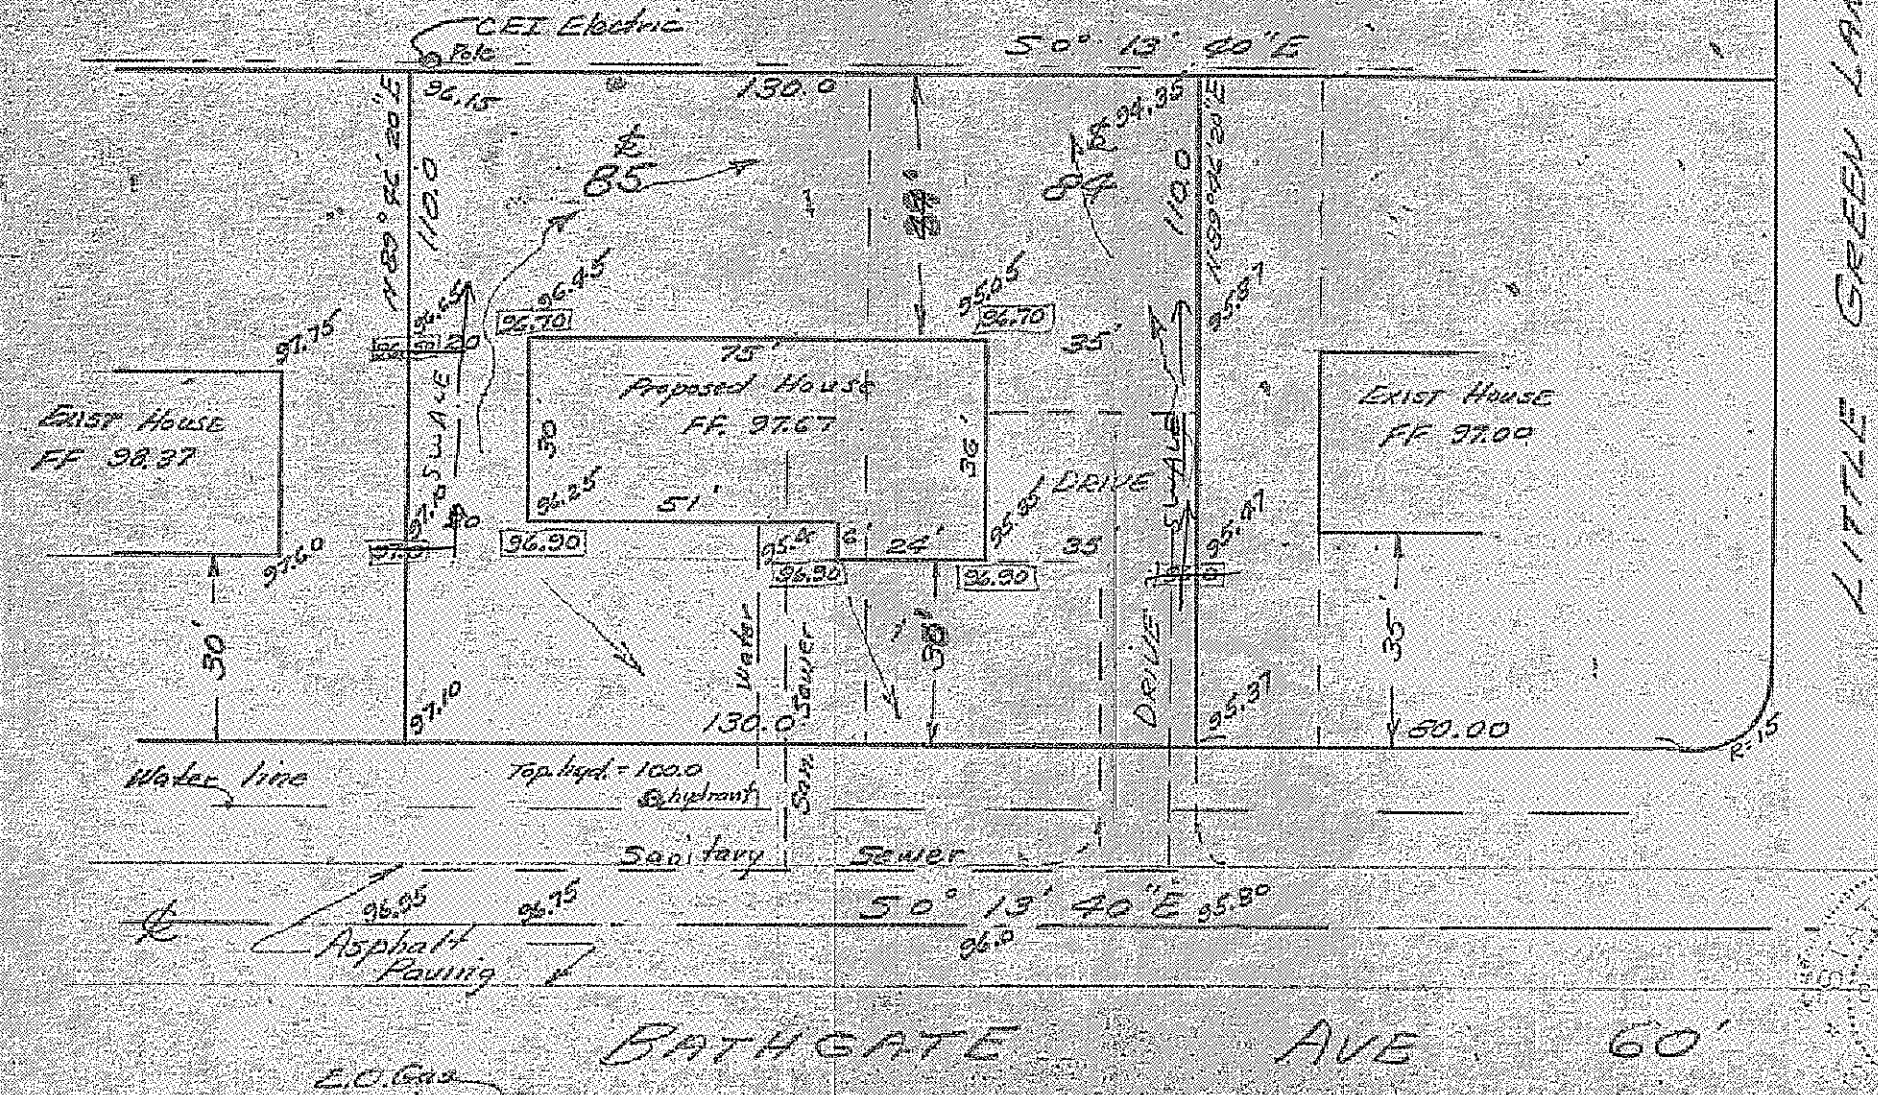

LITTLE GREEN LANE

