


ST JAMES ST GO

APPROVED
MADISON TWP. ZONING
Permit: 9018
Zoning Inspector: OKB

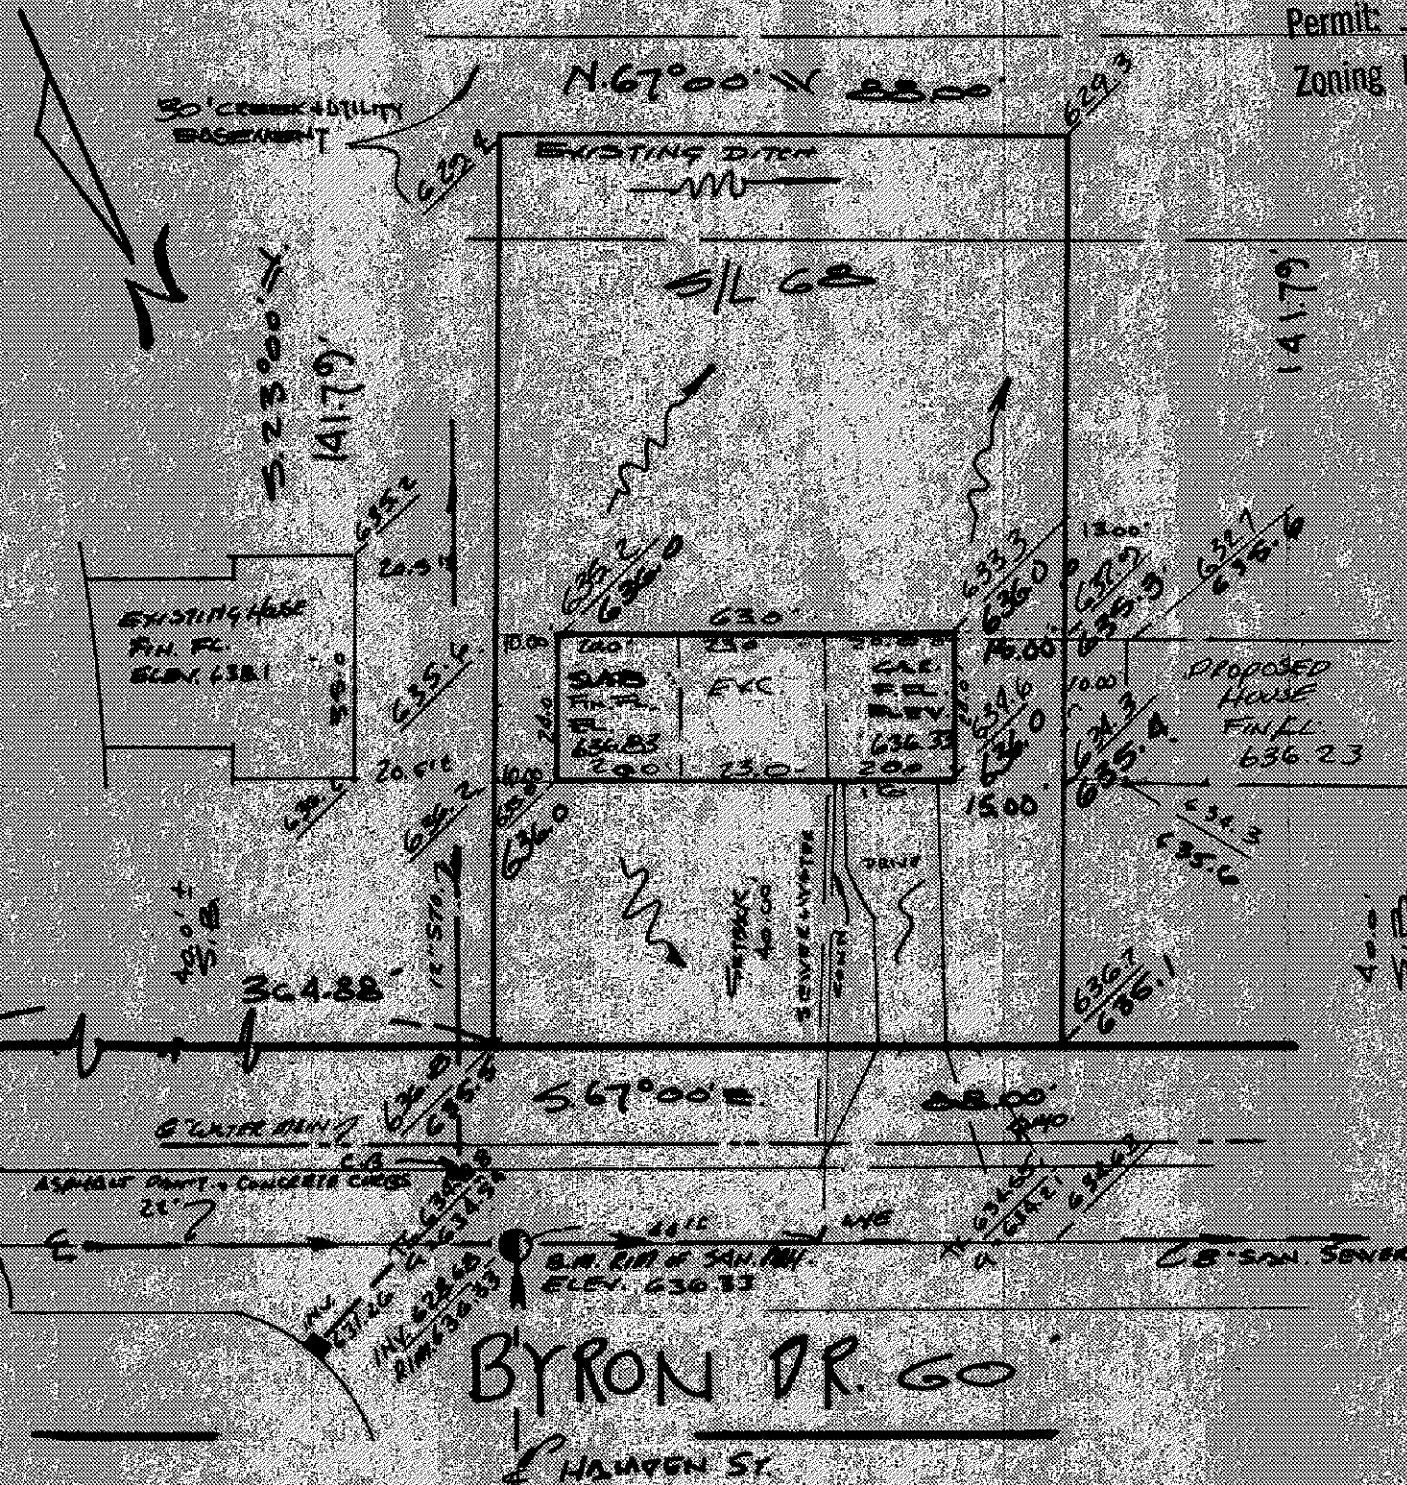

"AS BUILT" CERTIFICATION

I HEREBY CERTIFY THAT THE CIRCLED GRADES ARE EXISTING FINISH GRADES CHECKED IN FIELD ON 19 BY THOMAS E. GILLES, P.E. SURVEYING AND ARE CORRECT TO THE BEST OF MY KNOWLEDGE AND BELIEF

REGISTERED SURVEYOR

REG. NO.

By

Grading Plan Approved
as shown and/or noted
THOMAS E. GILLES, P.E.
Lake County Engineer

Date 3-18-74

SITE PLAN

MADISON LAKE COUNTY, OHIO
TOWNSHIP
for HALLMARK BLTRES.
CLIENT OWNER
6876 Byron Drive Madison, Ohio
ADDRESS STREET CITY ZIP

CHAPEL CREEK SUBV.
SUBDIVISION NAME
68 VOL - PG
SUBLOT NO. STREET

LOT TRACT
VOLUME PAGE
PERM. PARCEL # STREET

LEGEND

SANITARY MANHOLE WATER VALVE (GAS)
STORM MANHOLE WATER METER (GAS)
INLET OR CATCH BASIN AS BUILT ELEVATION
HYDRANT
EXISTING CONTOURS INDICATES
PROPOSED CONTOURS DIRECTION OF
EXIST. ELEV. 100.0 PROP. ELEV. SURFACE DRAINAGE

REMARKS

ALL BOUNDARY DATA SHOWN WAS OBTAINED FROM (DEEDS, RECORDED SUBDIVISION PLAT OR OTHER PUBLIC RECORDS)

DESIGN CERTIFICATION

THIS PLAT WAS PREPARED BY ME AND IS CORRECT TO THE BEST OF MY KNOWLEDGE AND BELIEF

NAME Richard J. Debevec SURVEYOR REGISTRATION NO. 5244

CHECK LIST

DIMENSIONS
BEARINGS
TIE TO NEAREST STREET
SUBLOT NO. PARCEL NO.
SURROUNDING OWNERS
BLDG DIMENSIONS FIN. GR.
BLDG TIES FLR GRADES
APRON TYPE WIDTH THICKNESS
SIDEWALK TYPE WIDTH THICKNESS
CULVERT TYPE DIA. LENGTH
WATER MAIN SIZE LOCATION
SAN SEWER SIZE % GR. LOC.
SAN MH CAST ELEV. INV. ELEV.
SAN CONN. SIZE LOC. DEPTH
STORM SEWER SIZE % GR. LOC.
STORM MH CAST ELEV. INV. ELEV.
PAVT TYPE GRADE CURBS
GAS LINE LOC. SIZE PRESSURE
SEPTIC TANK SIZE LOC.
WELL LOCATION

REVISIONS

NO.	DATE	BY
1	3-12-74	LB
2		
3		
4		
5		

PLAN PREPARED BY:

DEBEVEC-SALO & ASSOC., INC.

130 EAST JACKSON ST. PAINESVILLE

DRAWN BY

CHK'D

CREW CHIEF

SCALE

DATE

APP'D

PHONE NO.

DRAWING NO.

3603-68