

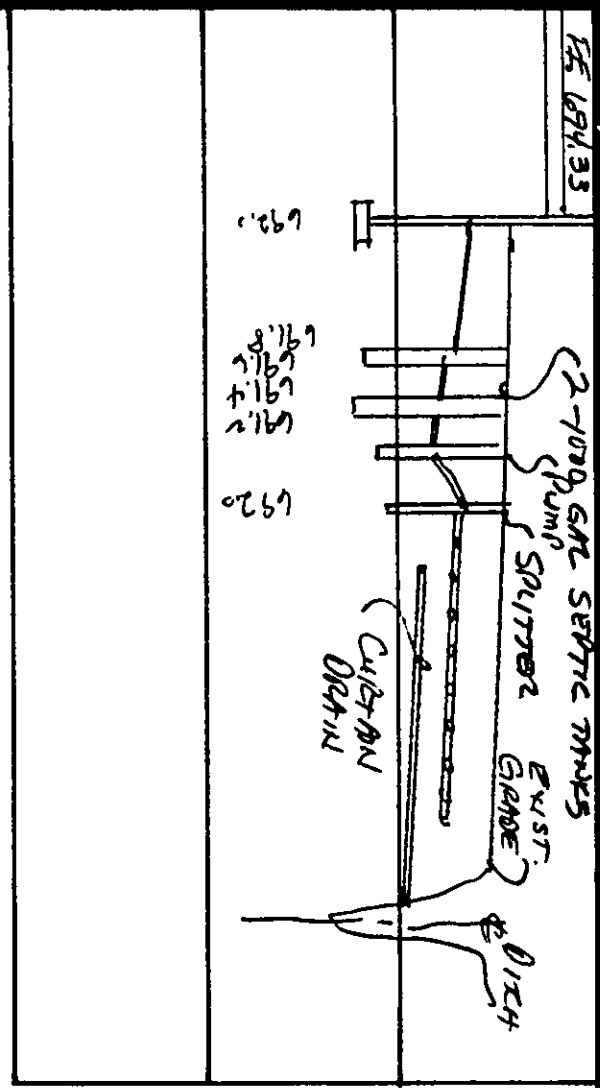
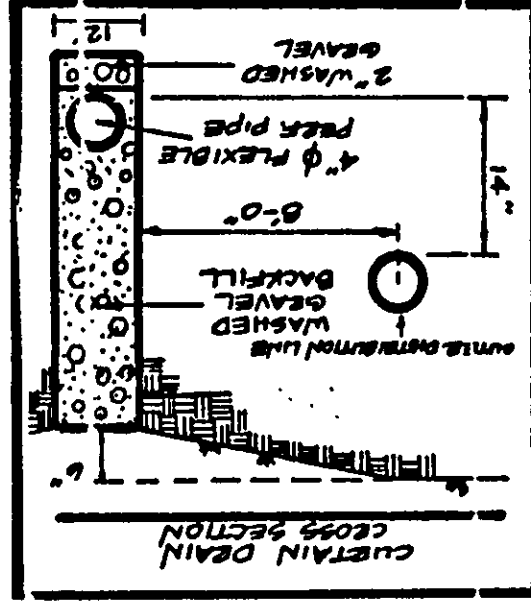
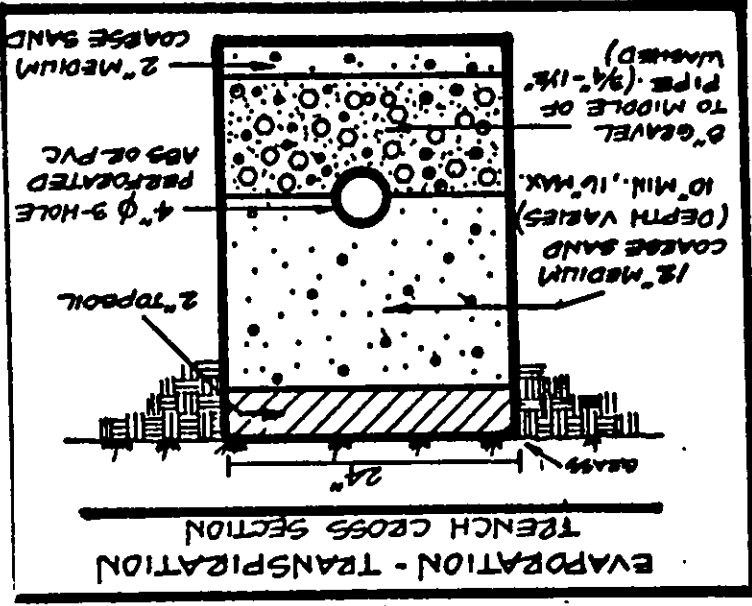


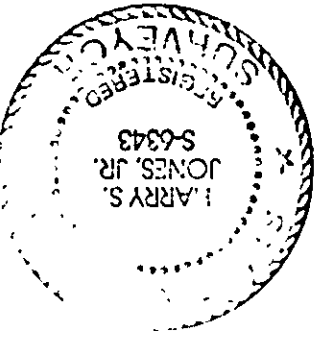

HYDRAULIC PROFILE
HORIZ 1"=30' VERT 1"=5'

REVIEWED AND ACCEPTED
LAKE COUNTY GENERAL
HEALTH DISTRICT
Date 3/14/87 BY D.J. [Signature]

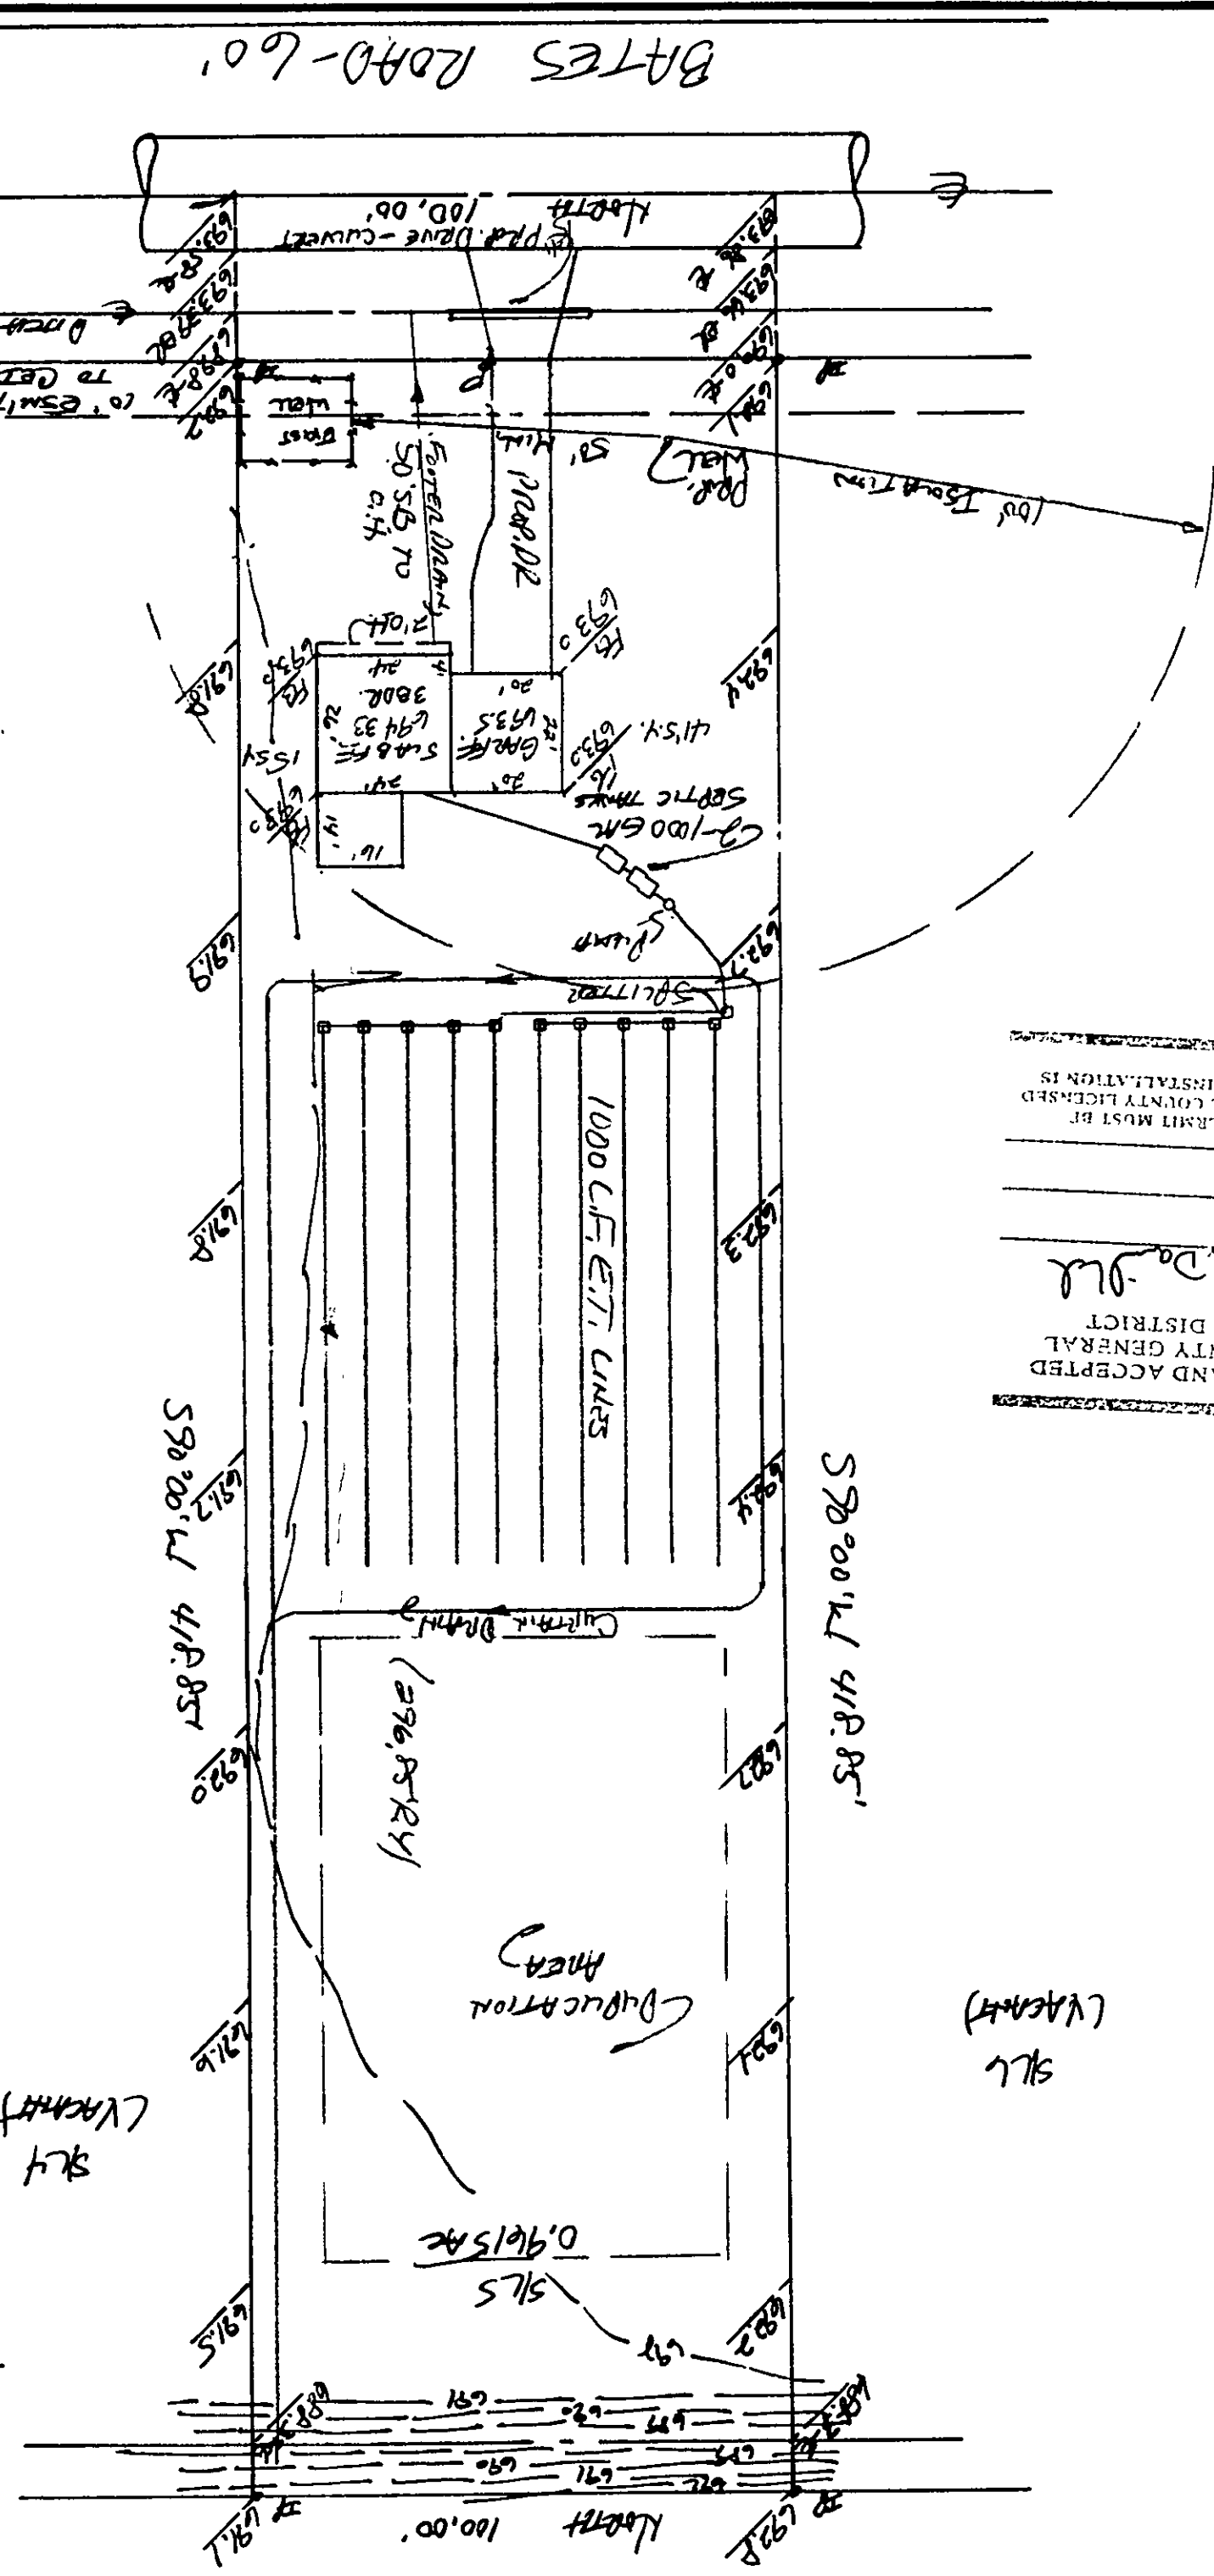

SITE PLAN

for: Gary & Cheryl Construction
MADISON Township, LAKE COUNTY, OHIO

ADDRESS _____ STREET _____ CITY _____ STATE _____ ZIP _____

SUBDIVISION NAME Waters Edge LOT 5

PERM. PARCEL NO. _____ VOLUME _____ TRACT _____

LEGEND

SANITARY MANHOLE (●)
 STORM MANHOLE (○)
 INLET OR CATCH BASIN (□)
 EXISTING CONTOURS (---)
 PROPOSED CONTOURS (---)
 EXIST. ELEV. 100.0 PROP. ELEV. 100.0
 AS BUILT ELEVATION (●)
 WATER VALVE (GAS) (V)
 WATER METER (GAS) (M)
 SURFACE DRAINAGE (---)

REMARKS

ALL BOUNDARY DATA SHOWN WAS OBTAINED FROM (DEEDS, RECORDED SUBDIVISION PLAT OR OTHER PUBLIC RECORDS)

LOCATIONS AS SHOWN OF ADJACENT WELLS AND SEPTIC TANKS OBTAINED FROM LAKE COUNTY HEALTH DEPARTMENT

DESIGN CERTIFICATION

THIS PLAN WAS PREPARED BY ME, AND IS CORRECT TO THE BEST OF MY KNOWLEDGE AND BELIEF.

NAME [Signature] SUPERVISOR REGISTRATION NO. 4343

CHECK LIST

NO.	DATE	BY	REVISIONS
1	3/14/87	HA	

PLAN PREPARED BY: **BABCOCK • JONES & ASSOCIATES, INC.** PAINESVILLE, OHIO

NO.	DATE	BY	REVISIONS
1	3/14/87	HA	

DRAWN BY HA DATE 5/29/87 SCALE 1" = 30' PHONE NO. 357-1811
 CHK'D. HA APP'D. HA
 CREW HA CHIEF HA

"AS BUILT" CERTIFICATION

I, HEREBY CERTIFY THAT THE CIRCLED GRADES ARE EXISTING FINISH GRADES CHECKED IN THE FIELD ON 19____, AND ARE CORRECT TO THE BEST OF MY KNOWLEDGE AND BELIEF.

REG. NO. _____

Grading Plan Approved as shown and/or noted
 THOMAS R. GILLES, P.E.
 Lake County Engineer
 Date 3/13/87 By HA 15" Drive Culvert

APPROVED MADISON TOWNSHIP ZONING
 DATE 3/13/87 BY HA

Name [Signature] Reg. No. 4343

"I, the undersigned, hereby certify that this topographic map, and the elevations shown hereon, were taken by me on the day of May, 1987, and that the elevations were taken at appropriate intervals and that as of that date they existed as indicated hereon."