
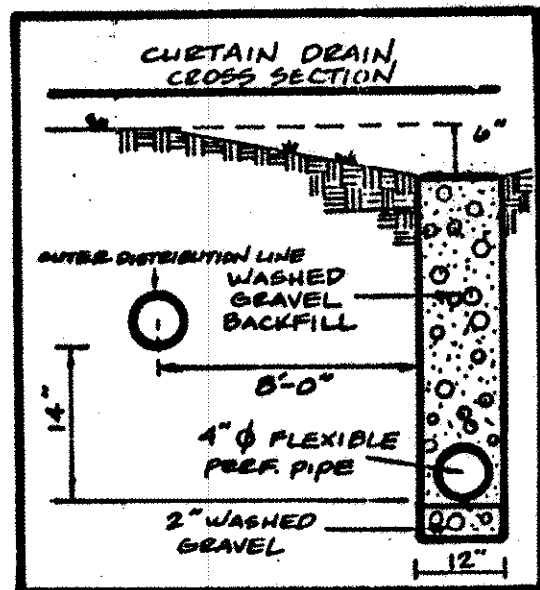




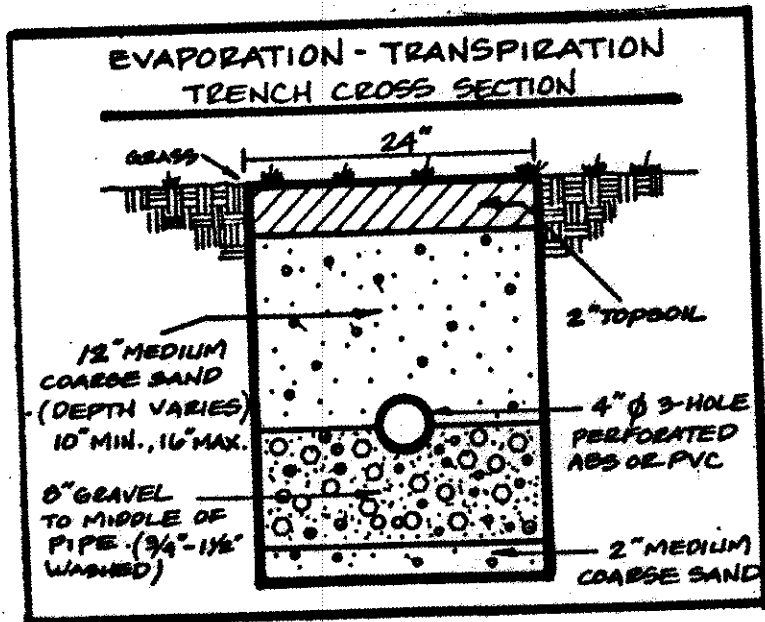


REVIEWED AND ACCEPTED
LAKE COUNTY GENERAL
HEALTH DISTRICT

Date: 7/3/97 BY: *Daniel L. ...*

SEWAGE DISPOSAL PERMIT MUST BE
OBTAINED BY A LAKE COUNTY LICENSED
INSTALLER BEFORE INSTALLATION IS
STARTED.

HYDRAULIC PROFILE
HORIZ: 1" = 30' VERT: 1" = 5'

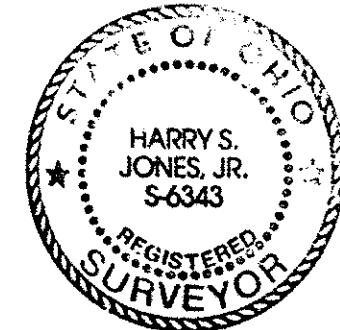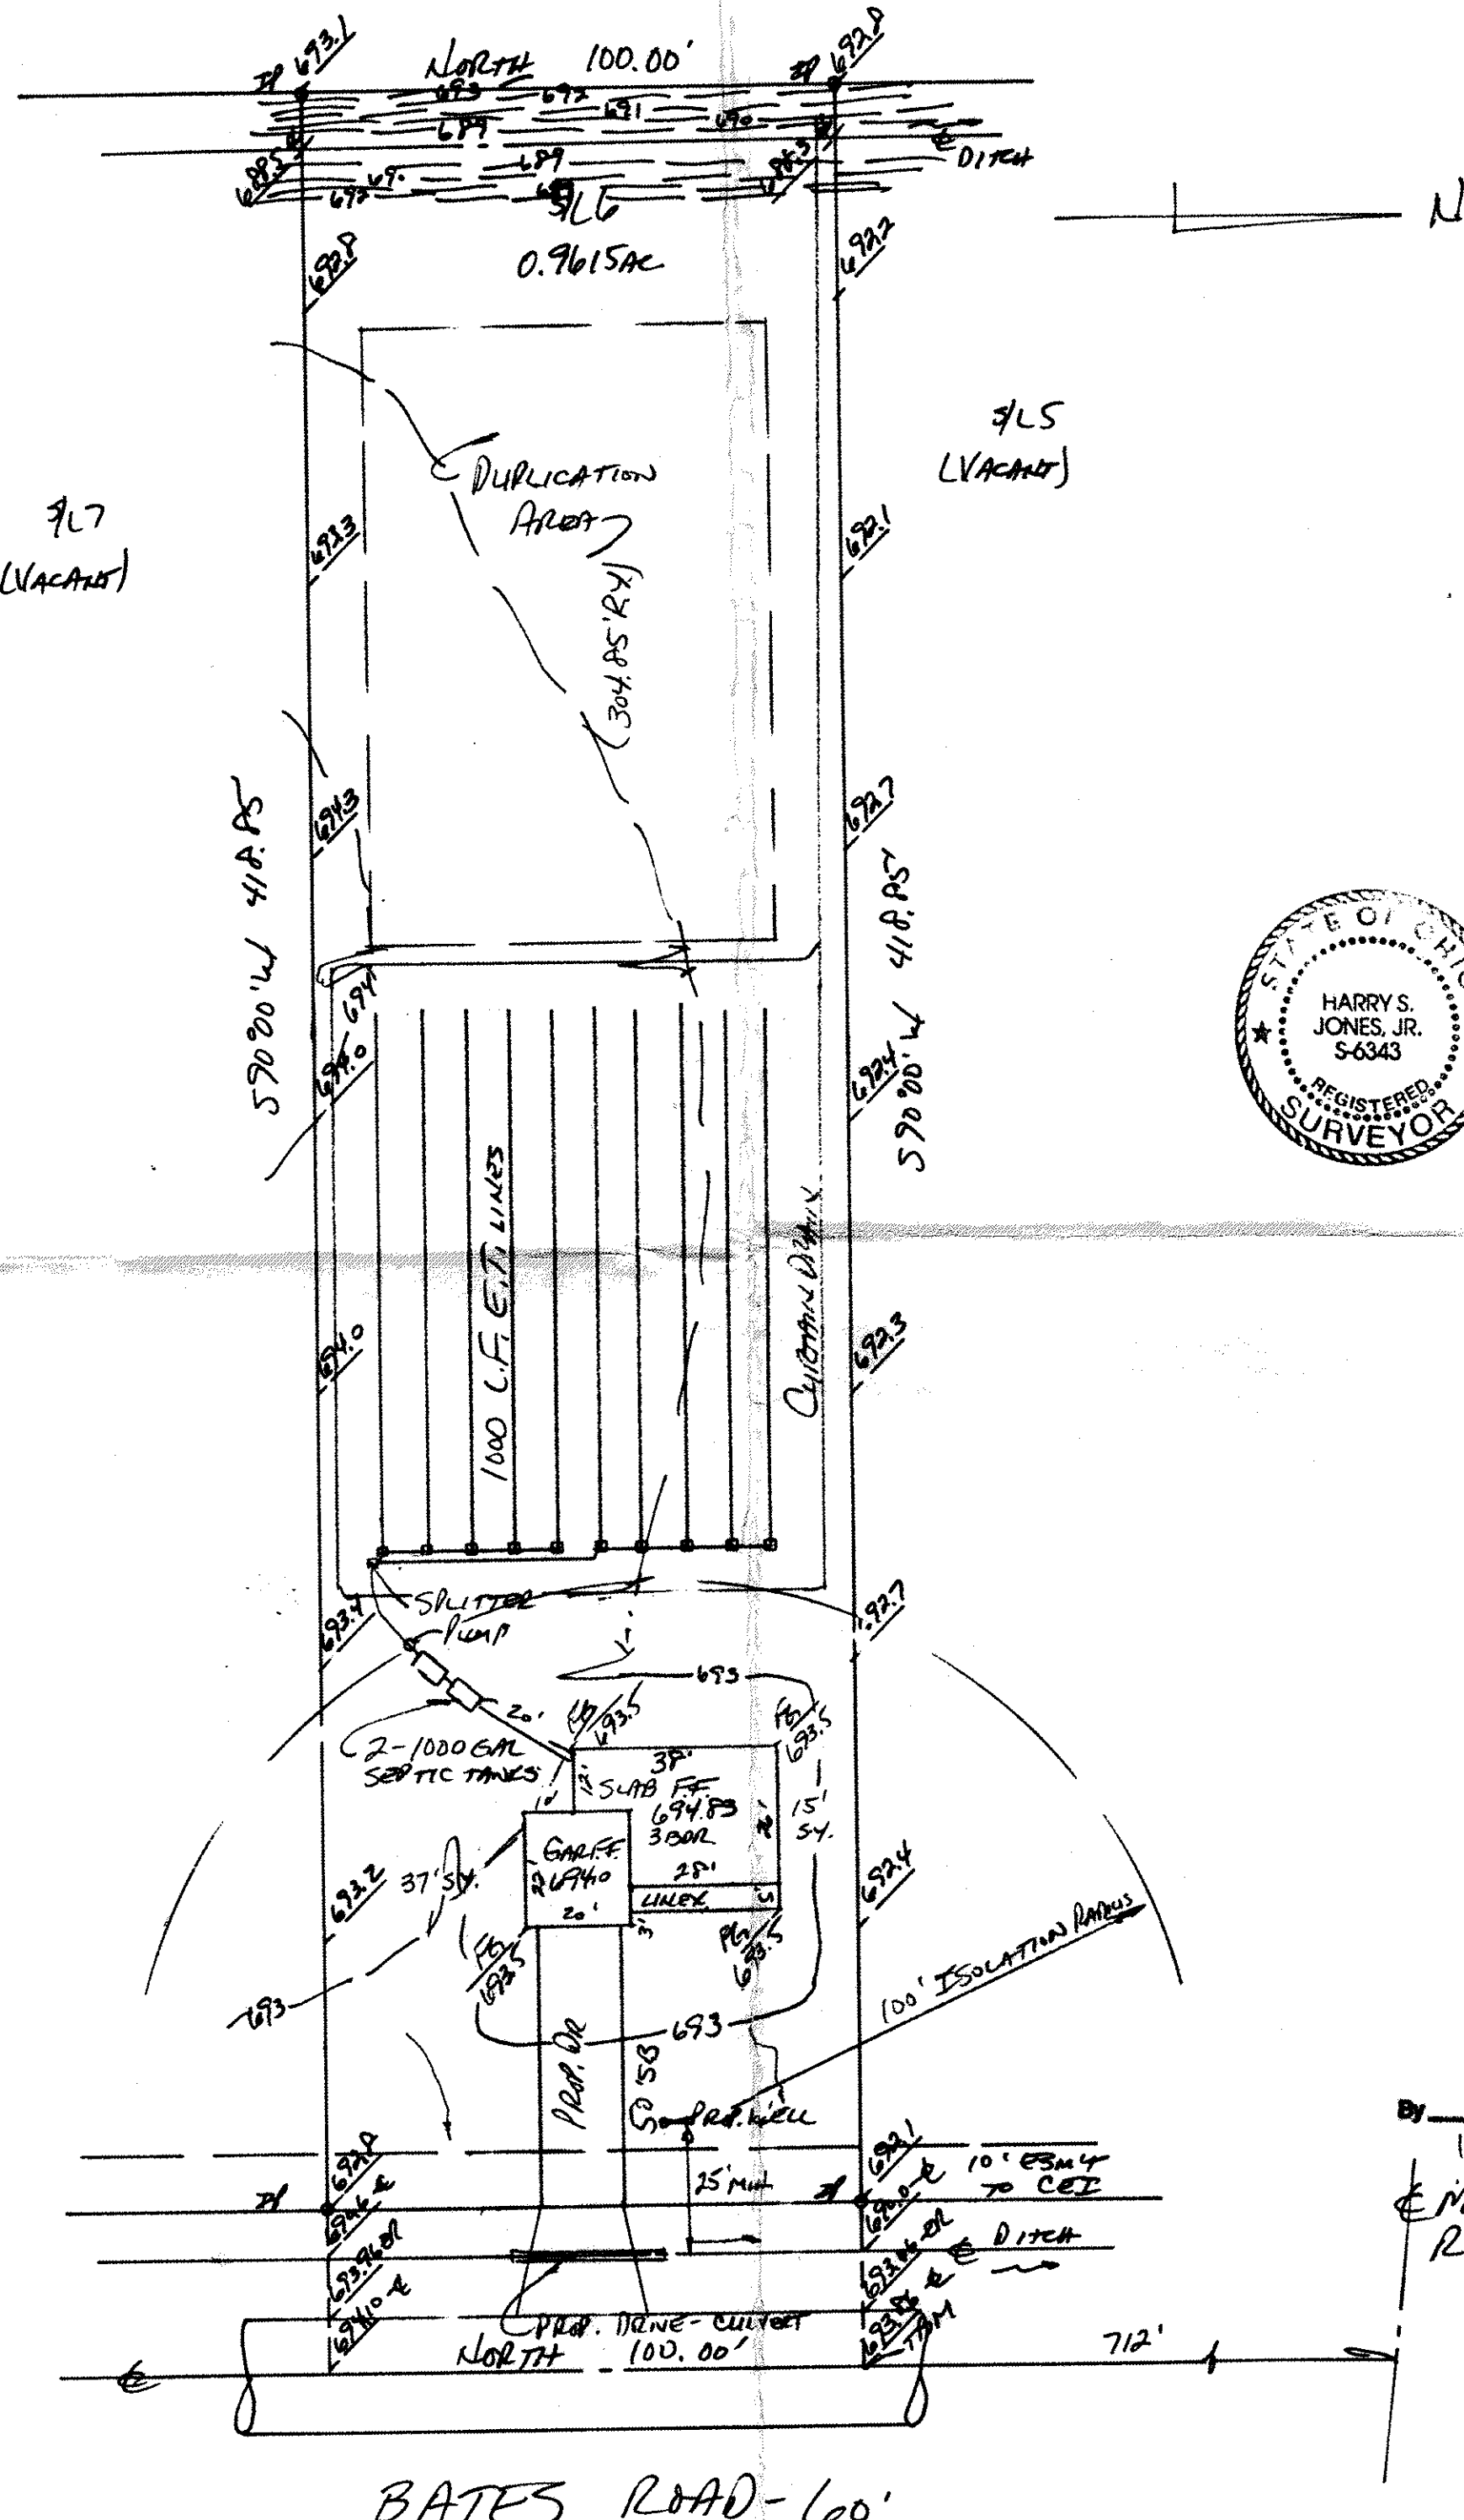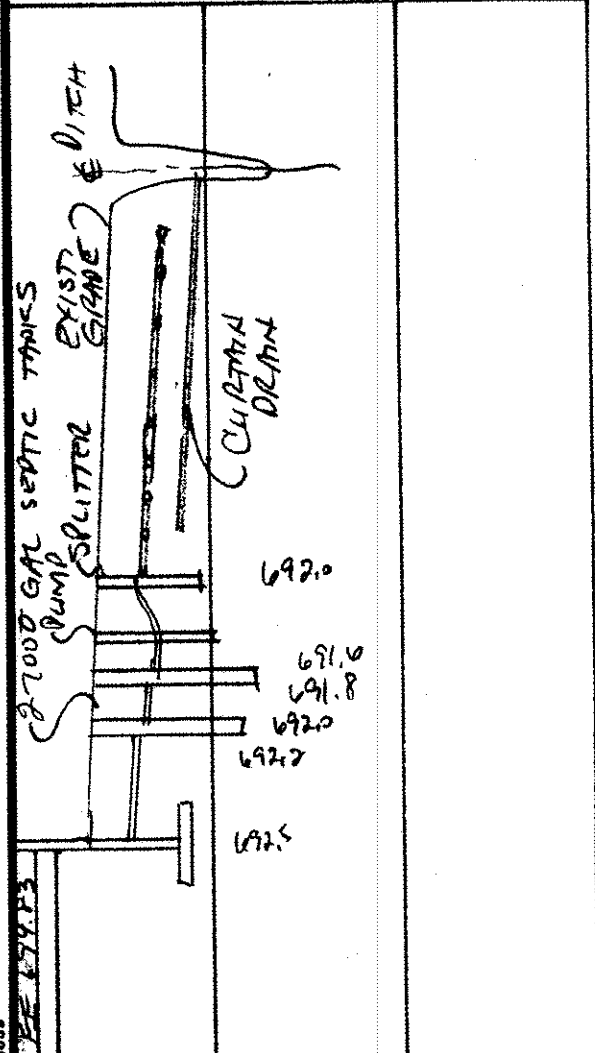

SITE PLAN

MADISON TOWNSHIP, LAKE COUNTY, OHIO

for: **GREAT EASTERN CONSTRUCTION**

ADDRESS STREET CITY ZIP

SUBDIVISION	NAME	LOT	TRACT
10	BATES ROAD		
SUBLOT NO.	STREET	VOLUME	PAGE
		PERM. PARCEL NO.	STREET

LEGEND

SANITARY MANHOLE	---	WATER VALVE (GAS)	---
STORM MANHOLE	---	WATER METER (GAS)	---
INLET OR CATCH BASIN	---	AS BUILT ELEVATION	---
HYDRANT	---	INDICATES	---
EXISTING CONTOURS	---	DIRECTION OF	---
PROPOSED CONTOURS	---	SURFACE DRAINAGE	---
EXIST. ELEV.	---		

REMARKS

ALL BOUNDARY DATA SHOWN WAS OBTAINED FROM (DEEDS, RECORDED
SUBDIVISION PLAT OR OTHER PUBLIC RECORDS)

LOCATIONS AS SHOWN OF ADJACENT WELLS AND SEPTIC TANKS OBTAINED FROM
LAKE COUNTY HEALTH DEPARTMENT

DESIGN CERTIFICATION

THIS PLAT WAS PREPARED BY ME, AND IS CORRECT
TO THE BEST OF MY KNOWLEDGE AND BELIEF.

NAME SURVEYOR REGISTRATION NO.

CHECK LIST

NO. OF BEDROOMS	WATER MAIN SIZE, LOCATION
DIMENSIONS	SAN. SEWER SIZE % GR. LOC.
BEARINGS	SAN. MH. CAST. ELEV. INV. ELEV.
TIE TO NEAREST STREET	SAN. CONN. SIZE, LOC. DEPTH
SUBLOT NO. PARCEL NO.	STORM SEWER SIZE % GR. LOC.
SURROUNDING OWNERS	STORM MH. CAST. ELEV. INV. ELEV.
BLDG. DIMENSIONS FIN. GR.	PAV'T TYPE GRADE CURBS
BLDG. TIES FL'R. GRADES	GAS LINE LOC. SIZE PRESSURE
APRON TYPE WIDTH THICKNESS	SEPTIC TANK LOCATION & DUPLICATION AREA
SIDEWALK TYPE WIDTH THICKNESS	WELL LOCATION
CULVERT TYPE DIA., LENGTH	ISOLATION RADIUS FROM WELL
ROCK OUTCROPPINGS	

NO.	DATE	BY
1	7/1/97	HT
2		
3		
4		
5		

PLAN PREPARED BY:

BABCOCK • JONES & ASSOCIATES, INC.

PAINESVILLE, OHIO

DRAWN BY	SCALE	PHONE NO.
HT	1" = 30'	357-1811
CHK'D.	DATE	DRAWING NO.
HT	5/29/97	96-209-6
CREW CHIEF	APP'D.	
WJ	HT	

"AS BUILT" CERTIFICATION

I, HEREBY CERTIFY THAT THE CIRCLED GRADES ARE EXISTING
FINISH GRADES CHECKED IN THE FIELD ON _____, 19____
AND ARE CORRECT TO THE BEST OF MY KNOWLEDGE AND BELIEF.

REGISTERED SURVEYOR REG. NO.

TBM - E PAYMENT @ N.E. CORNER 5/16

Grading Plan Approved
as shown and/or noted
THOMAS P. GILLES, P.E.
Lake County Engineer

By: *LSH* Date: 7-30-97
18" Drive Culvert
E MIDDLE RIDGE RD

APPROVED
MADISON TOWNSHIP ZONING
JUL 21 1997
PERMIT # 15465

"I, the undersigned, hereby certify that
this topographic map, prepared by 6", 1" or 2"
contours, and the elevations shown hereon
represent an accurate survey made by
me on the 29th of MAY, 1997
and that the elevations were taken at
appropriate intervals and that as of that
date they existed as indicated hereon."

Name: *Harry Jones #6343*
Reg. No.