
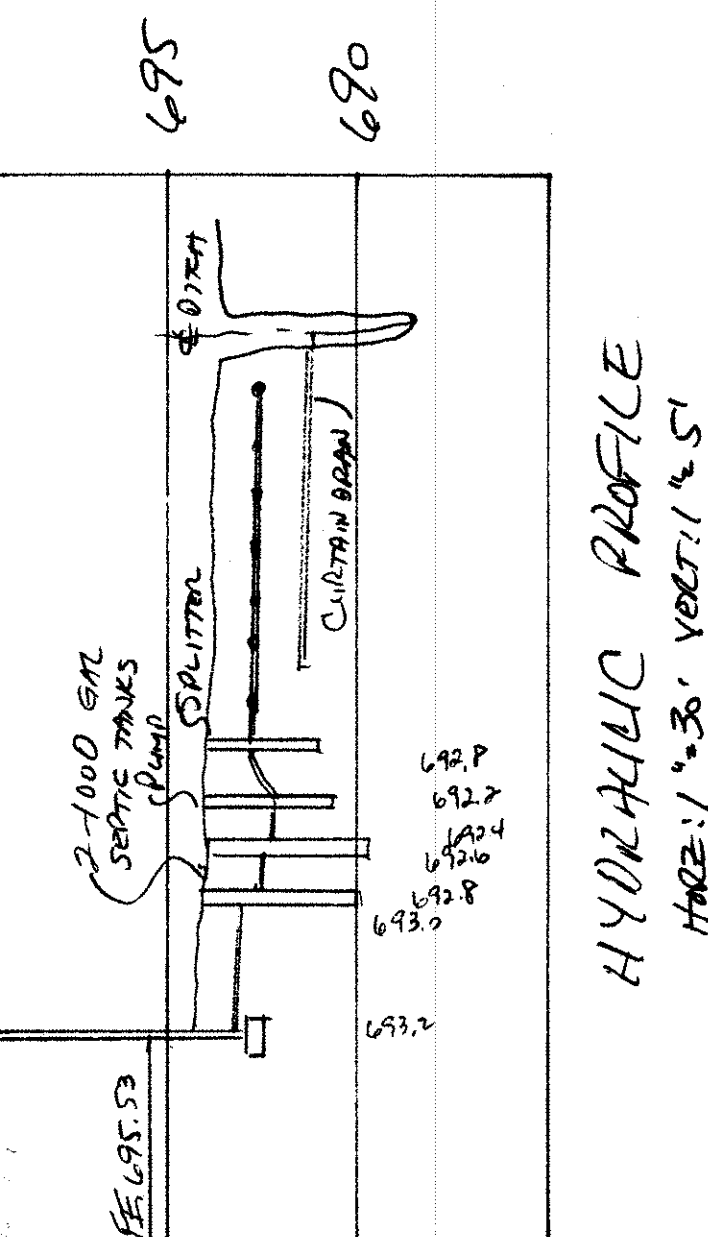


Date 7/3/97 BY Dan Olab

SEWAGE DISPOSAL PERMIT MUST BE
OBTAINED BY A LAKE COUNTY LICENSED
INSTALLER BEFORE INSTALLATION IS
STARTED

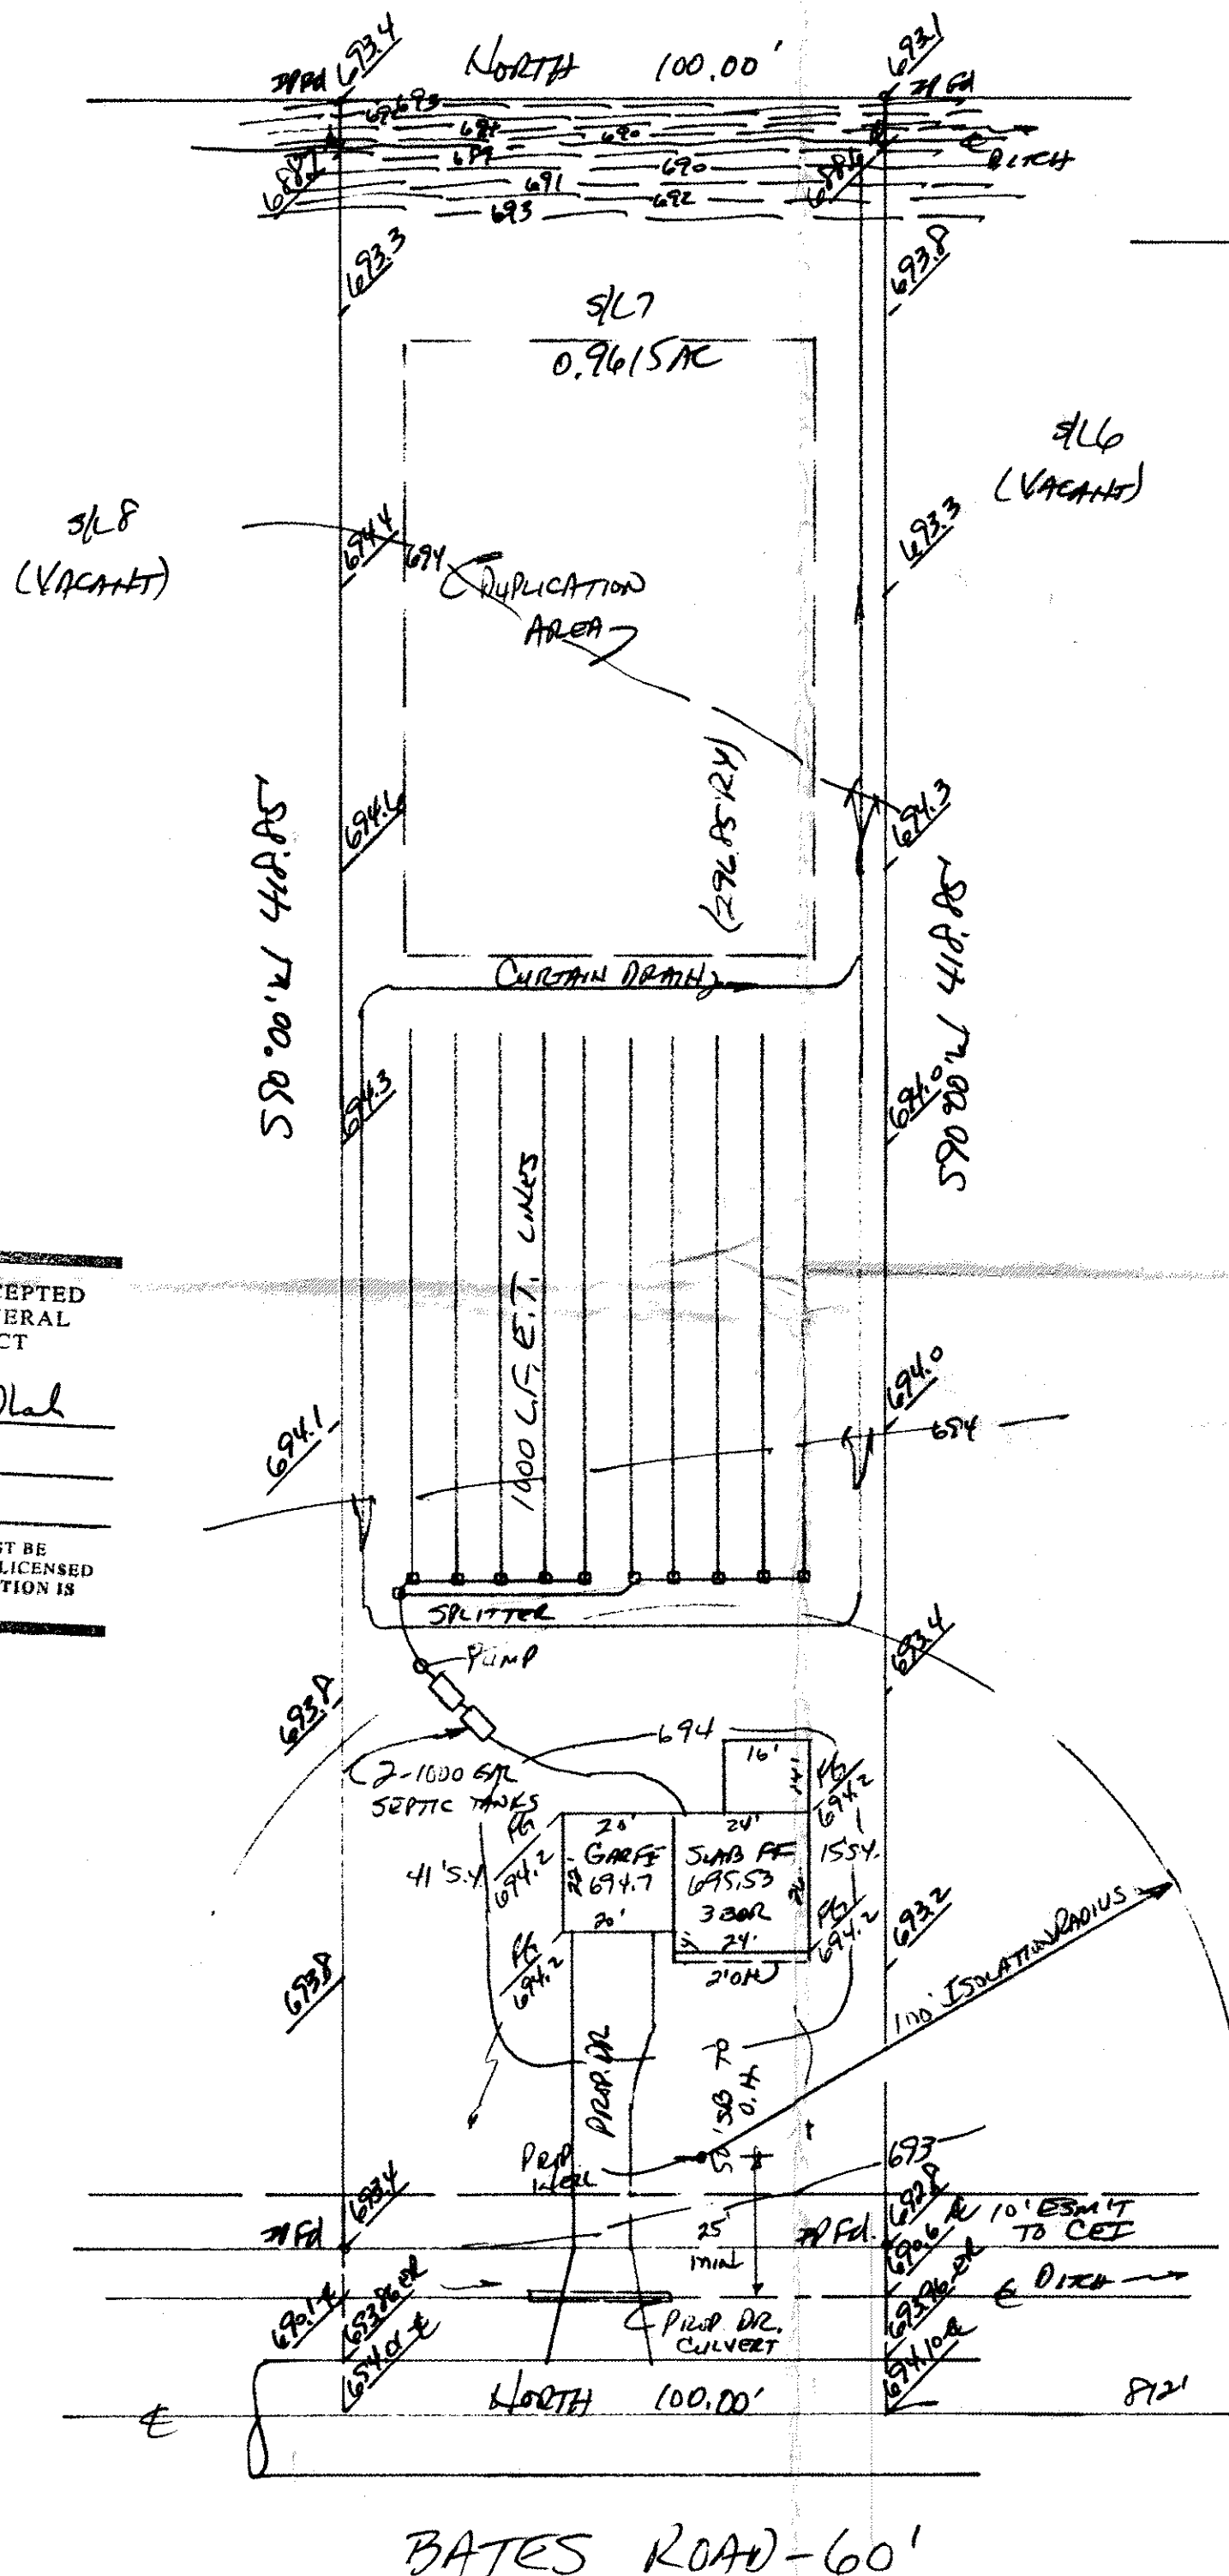

for: GREAT EASTERN CONSTRUCTION
CLIENT OWNER

ADDRESS	STREET	CITY	ZIP
---------	--------	------	-----

SUBDIVISION	NAME	LOT	TRACT
7	VOL. PG. <i>BATES ROAD</i>	VOLUME	PAGE
SUBLOT NO.	STREET	PERM. PARCEL NO.	STREET

SANITARY MANHOLE	-----	①	WATER VALVE (GAS)	-----	⚙
STORM MANHOLE	-----	●	WATER METER (GAS)	-----	---
INLET OR CATCH BASIN	-----	■	AS BUILT ELEVATION		
HYDRANT	-----	⊙			
EXISTING CONTOURS	-----			INDICATES	
PROPOSED CONTOURS	-----			DIRECTION OF	
EXIST. ELEV.		100.0		SURFACE DRAINAGE	
		100.0	PROP. ELEV.		

ALL BOUNDARY DATA SHOWN WAS OBTAINED FROM (DEEDS, RECORDED
SUBDIVISION PLAT OR OTHER PUBLIC RECORDS)

LOCATIONS AS SHOWN OF ADJACENT WELLS AND SEPTIC TANKS OBTAINED FROM
LAKE COUNTY HEALTH DEPARTMENT

THIS PLAT WAS PREPARED BY ME, AND IS CORRECT
TO THE BEST OF MY KNOWLEDGE AND BELIEF.

NAME	SURVEYOR	REGISTRATION	NO.
W. J.

NO. OF BEDROOMS	WATER MAIN SIZE, LOCATION
DIMENSIONS	SAN. SEWER SIZE % GR. LOC.
BEARINGS	SAN. MH. CAST. ELEV. INV. ELEV.
TIE TO NEAREST STREET	SAN. CONN. SIZE, LOC. DEPTH
SUBLOT NO. PARCEL NO.	STORM SEWER SIZE % GR. LOC.
SURROUNDING OWNERS	STORM MH. CAST. ELEV. INV. ELEV.
BLDG. DIMENSIONS FIN. GR.	PAVT TYPE GRADE CURBS
BLDG. TIES FL'R. GRADES	GAS LINE LOC. SIZE PRESSURE
APRON TYPE WIDTH THICKNESS	SEPTIC TANK LOCATION & DUPLICATION AREA
SIDEWALK TYPE WIDTH THICKNESS	WELL LOCATION
CULVERT TYPE DIA., LENGTH	ISOLATION RADIUS FROM WELL
ROCK OUTCROPPINGS	

REVISIONS			PLAN PREPARED BY:		
NO.	DATE	BY	BABCOCK • JONES & ASSOCIATES, INC		
1			PAINESVILLE, OHIO		
2					
3					
4					
5			DRAWN BY	SCALE	PHONE NO.
			CHK'D.	DATE	DRAWING NO.
			CREW CHIEF	APP'D.	

I, HEREBY CERTIFY THAT THE CIRCLED GRADES ARE EXISTING
FINISH GRADES CHECKED IN THE FIELD ON _____, 19____
AND ARE CORRECT TO THE BEST OF MY KNOWLEDGE AND BELIEF.

REGISTERED SURVEYOR

REG. NO.

**Grading Plan Approved
as shown and/or noted
THOMAS P. GILLES, P.E.
Lake County Engineer**

By GLH Date 7-30-97
18" Drive Culvert

€ MIDDLE
R456 R4

APPROVED
MADISON TOWNSHIP ZONING

JUL 21 1997
15490
JUL

"I, the undersigned hereby certify that this topography indicated by 6", 1' or 2' contours, and elevations shown hereon represent an actual field survey made by me on the 19th day of May, 1957 and that the elevations were taken at appropriate intervals and that as of that date they existed as indicated hereon."

Name Harry Jones Reg. No. 1634