

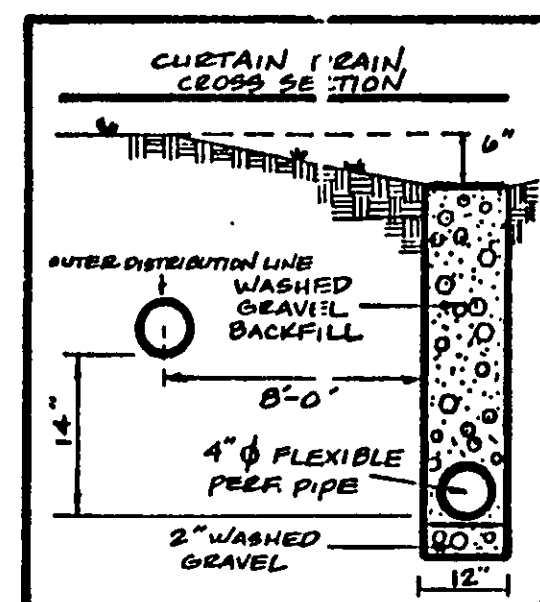
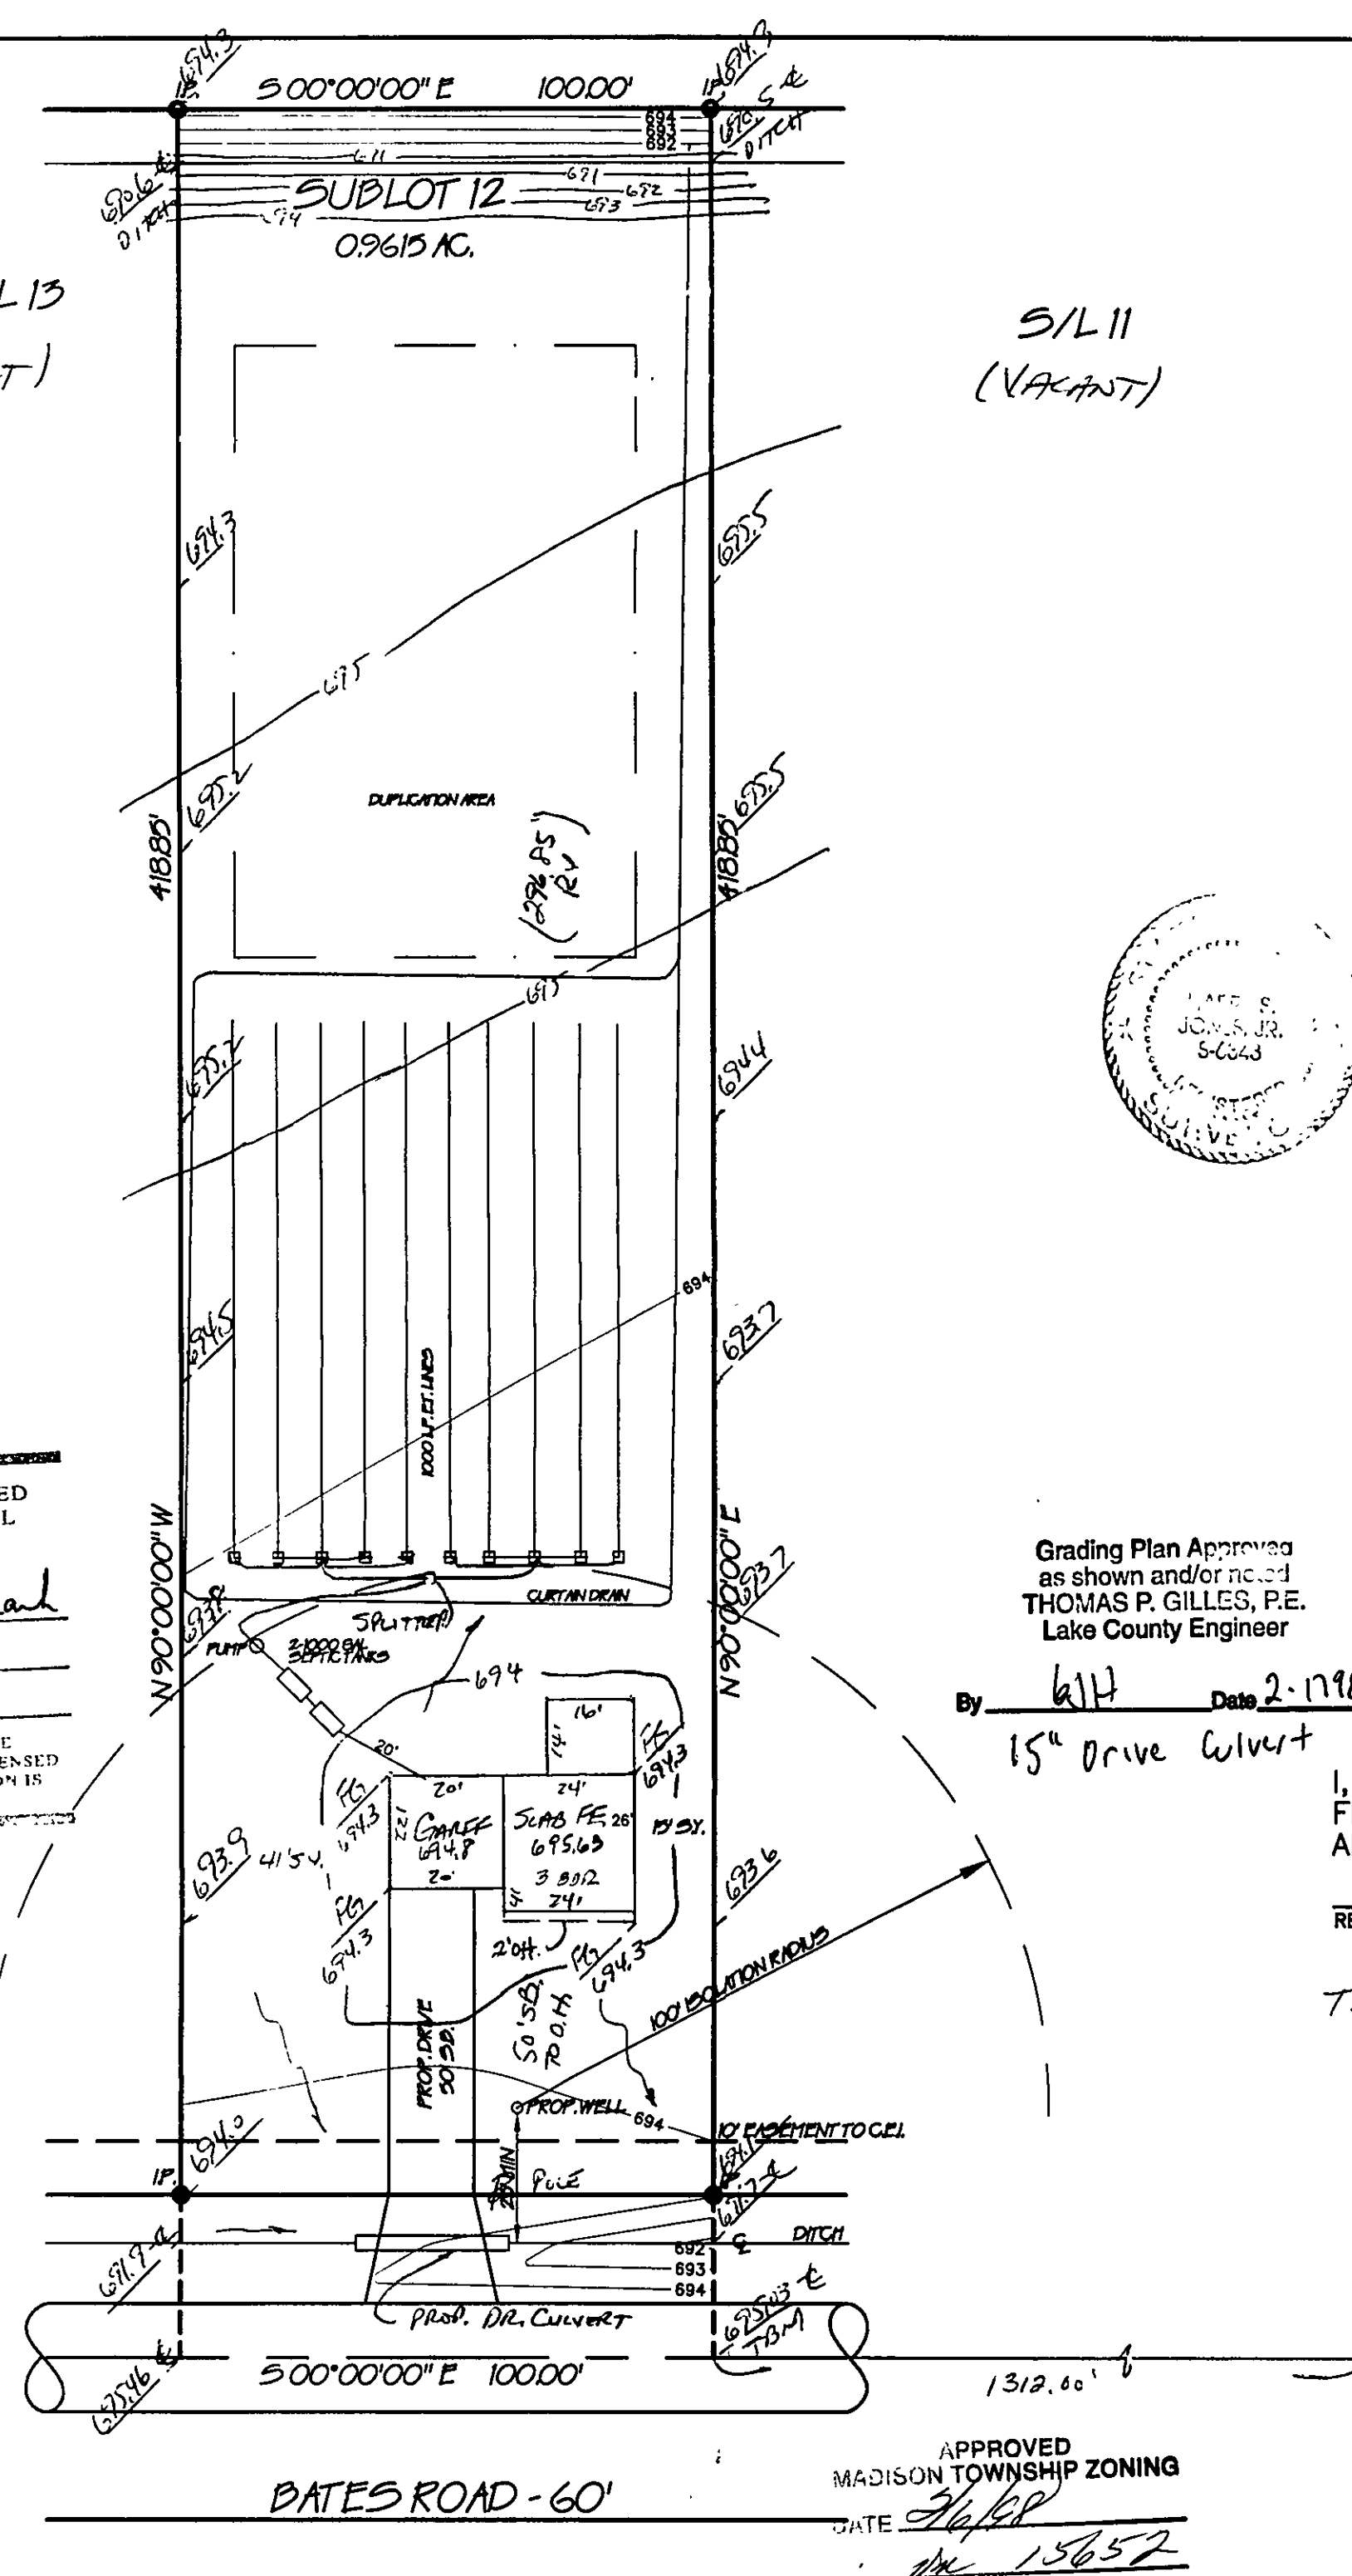


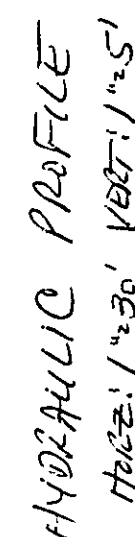

Date 2-4-98 BY Daniel Lark

SEWAGE DISPOSAL PERMIT MUST BE
OBTAINED BY A LAKE COUNTY LICENSED
INSTALLER BEFORE INSTALLATION IS
STARTED

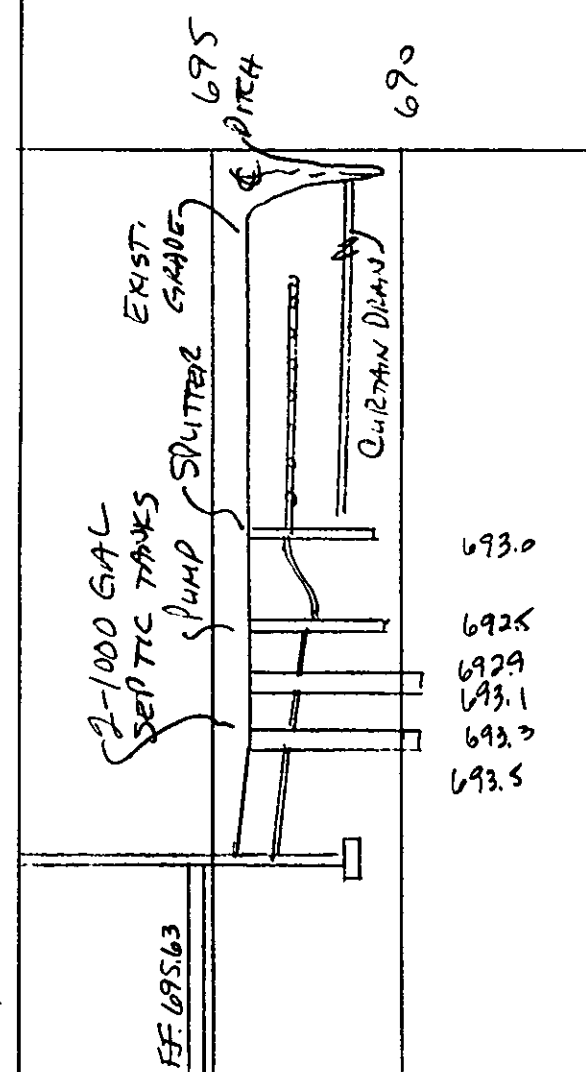

Grading Plan Approved
as shown and/or noted
THOMAS P. GILLES, P.E.
Lake County Engineer

By KIH Date 2-17-98
15" Drive Culvert

"AS BUILT" CERTIFICATION
I, HEREBY CERTIFY THAT THE CIRCLED GRADES ARE EXISTING
FINISH GRADES CHECKED IN THE FIELD ON _____, 19____
AND ARE CORRECT TO THE BEST OF MY KNOWLEDGE AND BELIEF.

REGISTERED SURVEYOR

REG. NO.

TBM - E BATES ROAD @ N.E. corner
of sk 12 - Elev. = 695.03

① MIDDLE RIDGE
ROAD

"I, the undersigned, hereby certify that this topography, shown by 6", 1" or 2" contours, and elevations shown hereon represent an actual field survey made by me on the 3rd day of March, 1957, and that the elevations were taken at appropriate intervals and that as of that date they existed as indicated hereon."

Name Harry Jones Reg. No. #634

SITE PLAN

MADISON TWP., LAKE COUNTY, OHIO

for: ED LUPP

ADDRESS	STREET	CITY	ZIP
---------	--------	------	-----

SUBMISSION	NAME	LOT	TRACT
12	VOL.-PG BATES ROAD	VOLUME	PAGE
SUBLOT NO.	STREET	PERM. PARCEL NO.	STREET

LEGEND

SANITARY MANHOLE	----		EXIST. ELEV.  100.0	PROP. ELEV.
STORM MANHOLE	----		100.0	
INLET OR CATCH BASIN	----			
HYDRANT	----			
EXISTING CONTOURS	----		AS BUILT ELEVATION	
PROPOSED CONTOURS	----		INDICATES	
			DIRECTION OF	
			SURFACE DRAINAGE	

REMARKS

ALL BOUNDARY DATA SHOWN WAS OBTAINED FROM (DEEDS, RECORDED
SUBMISSION PLAT OR OTHER PUBLIC RECORDS)

LOCATIONS AS SHOWN OF ADJACENT WELLS AND SEPTIC TANKS OBTAINED FROM LAKE COUNTY HEALTH DEPARTMENT

DESIGN CERTIFICATION

THIS PLAT WAS PREPARED BY ME, AND IS CORRECT
TO THE BEST OF MY KNOWLEDGE AND BELIEF.

NAME Henry Jones SURVEYOR 76343 REGISTRATION NO. _____

CHECK LIST

NO. OF BEDROOMS
DIMENSIONS
BEARINGS
TIE TO NEAREST STREET
SUBLOT NO. PARCEL NO.
SURROUNDING OWNERS
BLDG. DIMENSIONS FIN GR.
BLDG. TIES FL'R. GRADES
APRON TYPE WIDTH THICKNESS
SIDEWALK TYPE WIDTH THICKNESS
CULVERT TYPE DIA., LENGTH
ROCK OUTCROPPINGS

WATER MAIN SIZE, LOCATION
SAN. SEWER SIZE % GR. LOC.
SAN. MH. CAST. ELEV. INV. ELEV.
SAN. CONN. SIZE, LOC. DEPTH
STORM SEWER SIZE % GR. LOC.
STORM MH. CAST ELEV. INV. ELEV.
PAVT TYPE GRADE CURBS
GAS LINE LOC. SIZE PRESSURE
SEPTIC TANK LOCATION & DUPLICATION AREA
WELL LOCATION
ISOLATION RADIUS FROM WELL

REVISIONS		
NO.	DATE	BY
1	2/2/88	HT
2		
3		
4		
5		

PLAN PREPARED BY:

PLAN PREPARED BY:
BABCOCK • JONES & ASSOCIATES, INC.

PAINESVILLE, OHIO

DRAWN BY M.S.	SCALE 1/16" = 1'	PHONE NO. 216-357-1811
CHK'D. HT	DATE 1/14/98	DRAWING NO.
CREW CHIEF W.B.	APP'D HT	96-209-17

APPROVED
MADISON TOWNSHIP ZONING

DATE 7/6/58
15652