

# SITE PLAN

Madison Township, Lake County, Ohio

for: JERRY DODD

CLIENT OWNER

ADDRESS STREET CITY ZIP

Grading Plan Approved  
as shown and/or noted  
THOMAS P. GILLES, P.E.  
Lake County Engineer

By: [Signature] Date: 6-22-87

LOT	TRACT
1	1
VOLUME	PAGE
1	1
PERMIT PARCEL NO.	STREET
1	1

## LEGEND

SANITARY MANHOLE	WATER VALVE (GAS)
STORM MANHOLE	WATER METER (GAS)
INLET OR CATCH BASIN	AS BUILT ELEVATION
HYDRANT	INDICATES DIRECTION OF SURFACE DRAINAGE
EXISTING CONTOURS	
PROPOSED CONTOURS	
EXIST. ELEV.	100.0
PROG. ELEV.	100.0

## REMARKS

ALL BOUNDARY DATA SHOWN WAS OBTAINED FROM IDEEDS, RECORDED SUBDIVISION PLAT OR OTHER PUBLIC RECORDS  
LOCATIONS AS SHOWN OF ADJACENT WELLS AND SEPTIC TANKS OBTAINED FROM LAKE COUNTY HEALTH DEPARTMENT

## DESIGN CERTIFICATION

THIS PLAT WAS PREPARED BY ME, AND IS CORRECT TO THE BEST OF MY KNOWLEDGE AND BELIEF.

NAME SURVEYOR REGISTRATION NO.

## CHECK LIST

NO. OF BEDROOMS	WATER MAIN SIZE, LOCATION
1	SAN. SEWER SIZE & GR. LOC.
2	SAN. MH. CAST ELEV. INV. ELEV.
3	SAN. CONN. SIZE, LOC. DEPTH
4	STORM SEWER SIZE & GR. LOC.
5	STORM SEWER CAST ELEV. INV. ELEV.
6	STORM TYPE GRADE CURVES
7	GAS LINE LOC. SIZE PRESSURE
8	SEPTIC TANK LOCATION & DUPLICATION AREA
9	WELL LOCATION
10	ISOLATION RADII FROM WELL

PLAN PREPARED BY: BABCOCK • JONES & ASSOCIATES, INC. PAINESVILLE, OHIO

NO.	DATE	BY
1		
2		
3		
4		
5		
6		
7		
8		
9		
10		

## "AS BUILT" CERTIFICATION

I, HEREBY CERTIFY THAT THE CIRCLED GRADES ARE EXISTING FINISH GRADES CHECKED IN THE FIELD ON 1987 AND ARE CORRECT TO THE BEST OF MY KNOWLEDGE AND BELIEF.

REGISTERED SURVEYOR REG. NO.


THOMAS P. GILLES, P.E.  
DATE: 6-22-87  
ELEV. 100.0

## APPROVED

MADISON TWP. ZONING

Permit: 12100

Zoning Inspector: [Signature]

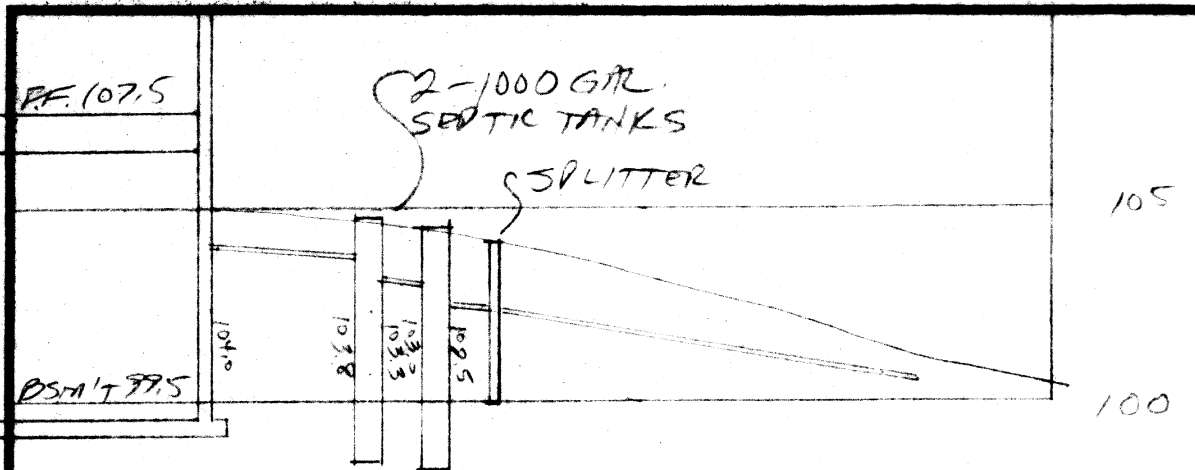

HYDRAULIC PROFILE  
SCALE: HORIZ. 1"=30'  
VERT. 1"=5'

