



SURVEYORS and ENGINEERS
Civil Engineering • Land Surveying


I CERTIFY THAT THIS PLAN
WAS PREPARED BY ME AND
IS CORRECT TO THE BEST OF
MY KNOWLEDGE AND BELIEF

John C. Skonieczny
REG. SURVEYOR #3356

JOHN C. SKONIECZNY
7739 VIEWMOUNT DR.
PAINESVILLE, OHIO 44077
PH. 352-7742

$\Delta = 1011115"$
 $R = 30.00'$
 $T = 2.67'$
 $L = 5.53'$


$\Delta = 802454"$
 $R = 30.00'$
 $T = 25.36'$
 $L = 42.11'$

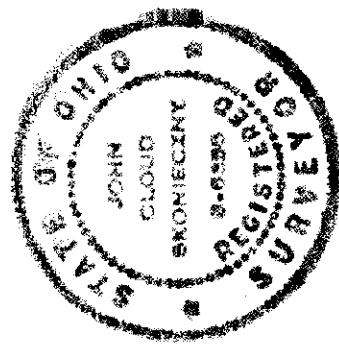

**SITE PLAN FOR: HOMES BY SIMMONS
BEING S/L 2 OF BENNETT ROAD NORTH
TOWNSHIP OF MADISON
LAKE COUNTY, OHIO**

DRAWN BY: SRL DATE: 7/94

CHECKED BY: JCS DRAWING NO.: AZT-047

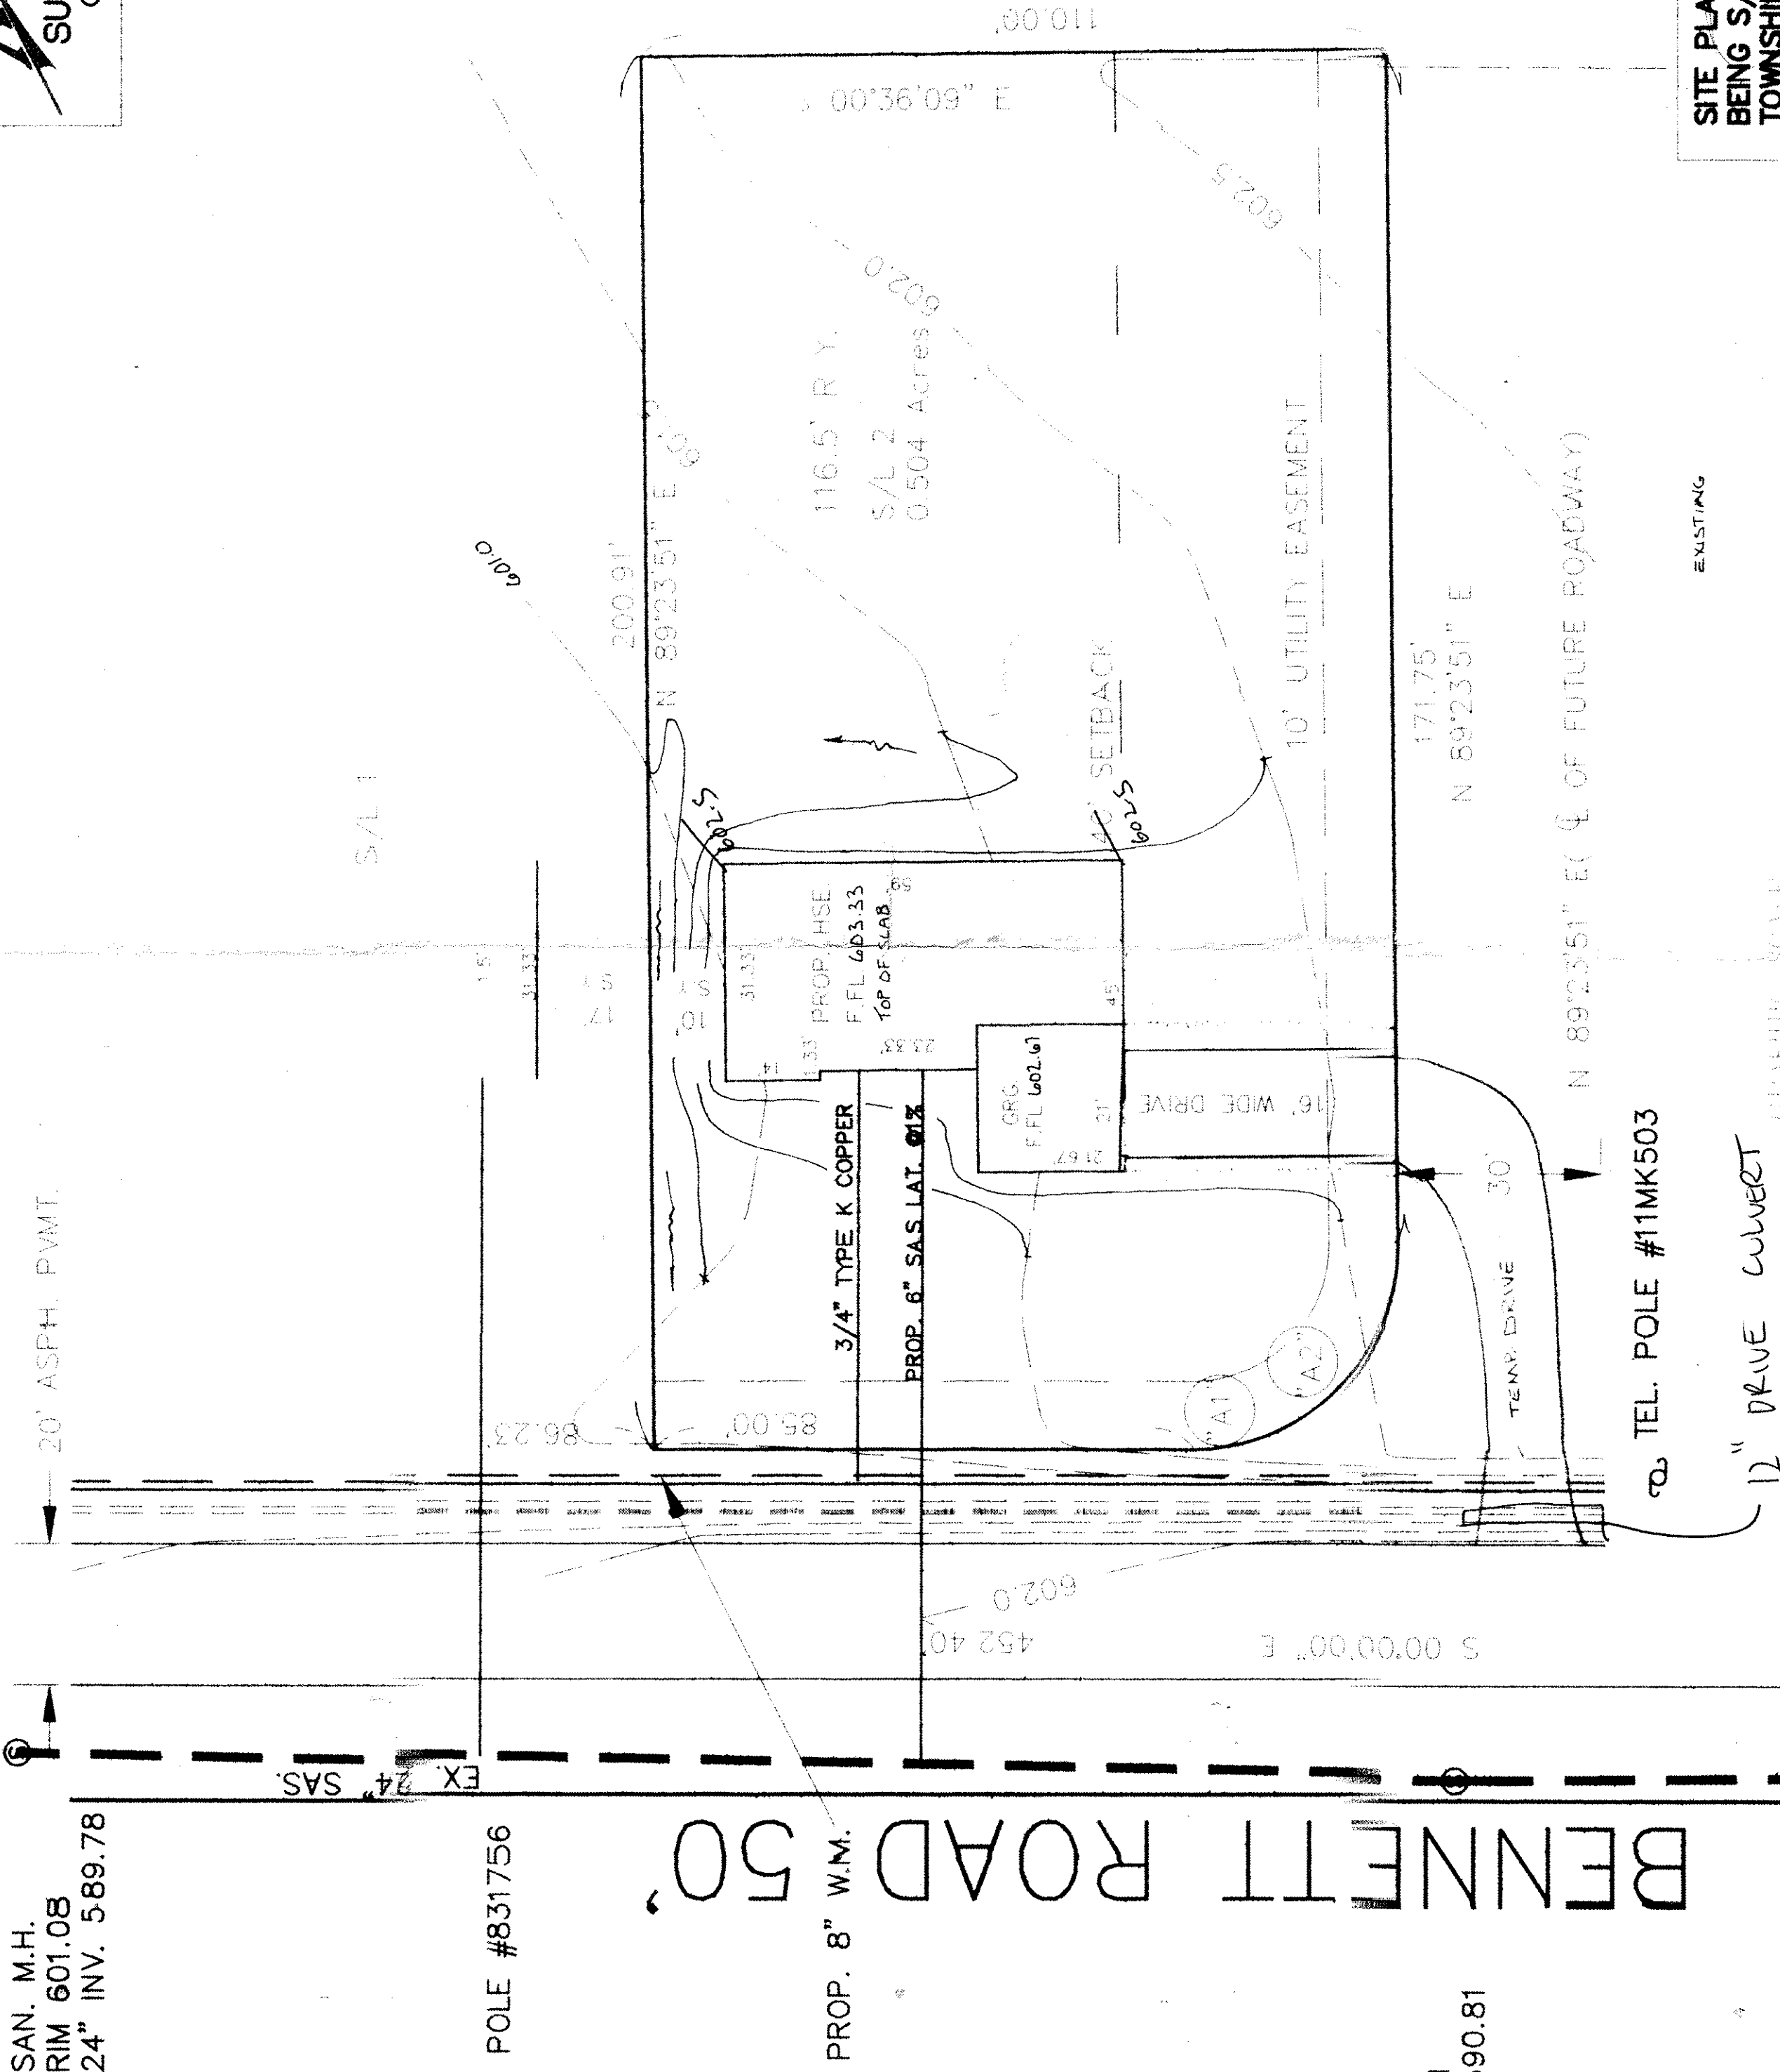

EXISTING

CLEARING SCAPED

Grading Plan Approved
as shown and/or noted
THOMAS P. GILLES, P.E.
Lake County Engineer

By: *TPG* Date: 1/94

APPROVED
JACKSON TWP. ZONING
Committee
August 2, 1994