

Madison Township

RECEIVED SEP 23 1987


SITE PLAN

FOR

JOE WELSH

KNOWN AS BEING A PART OF THE BOLLES TRACT, LOT 2, AND SITUATED IN THE TOWNSHIP OF MADISON, COUNTY OF LAKE, AND STATE OF OHIO.

BENCHMARK-600.43
HYDRANT NORTH BOLT

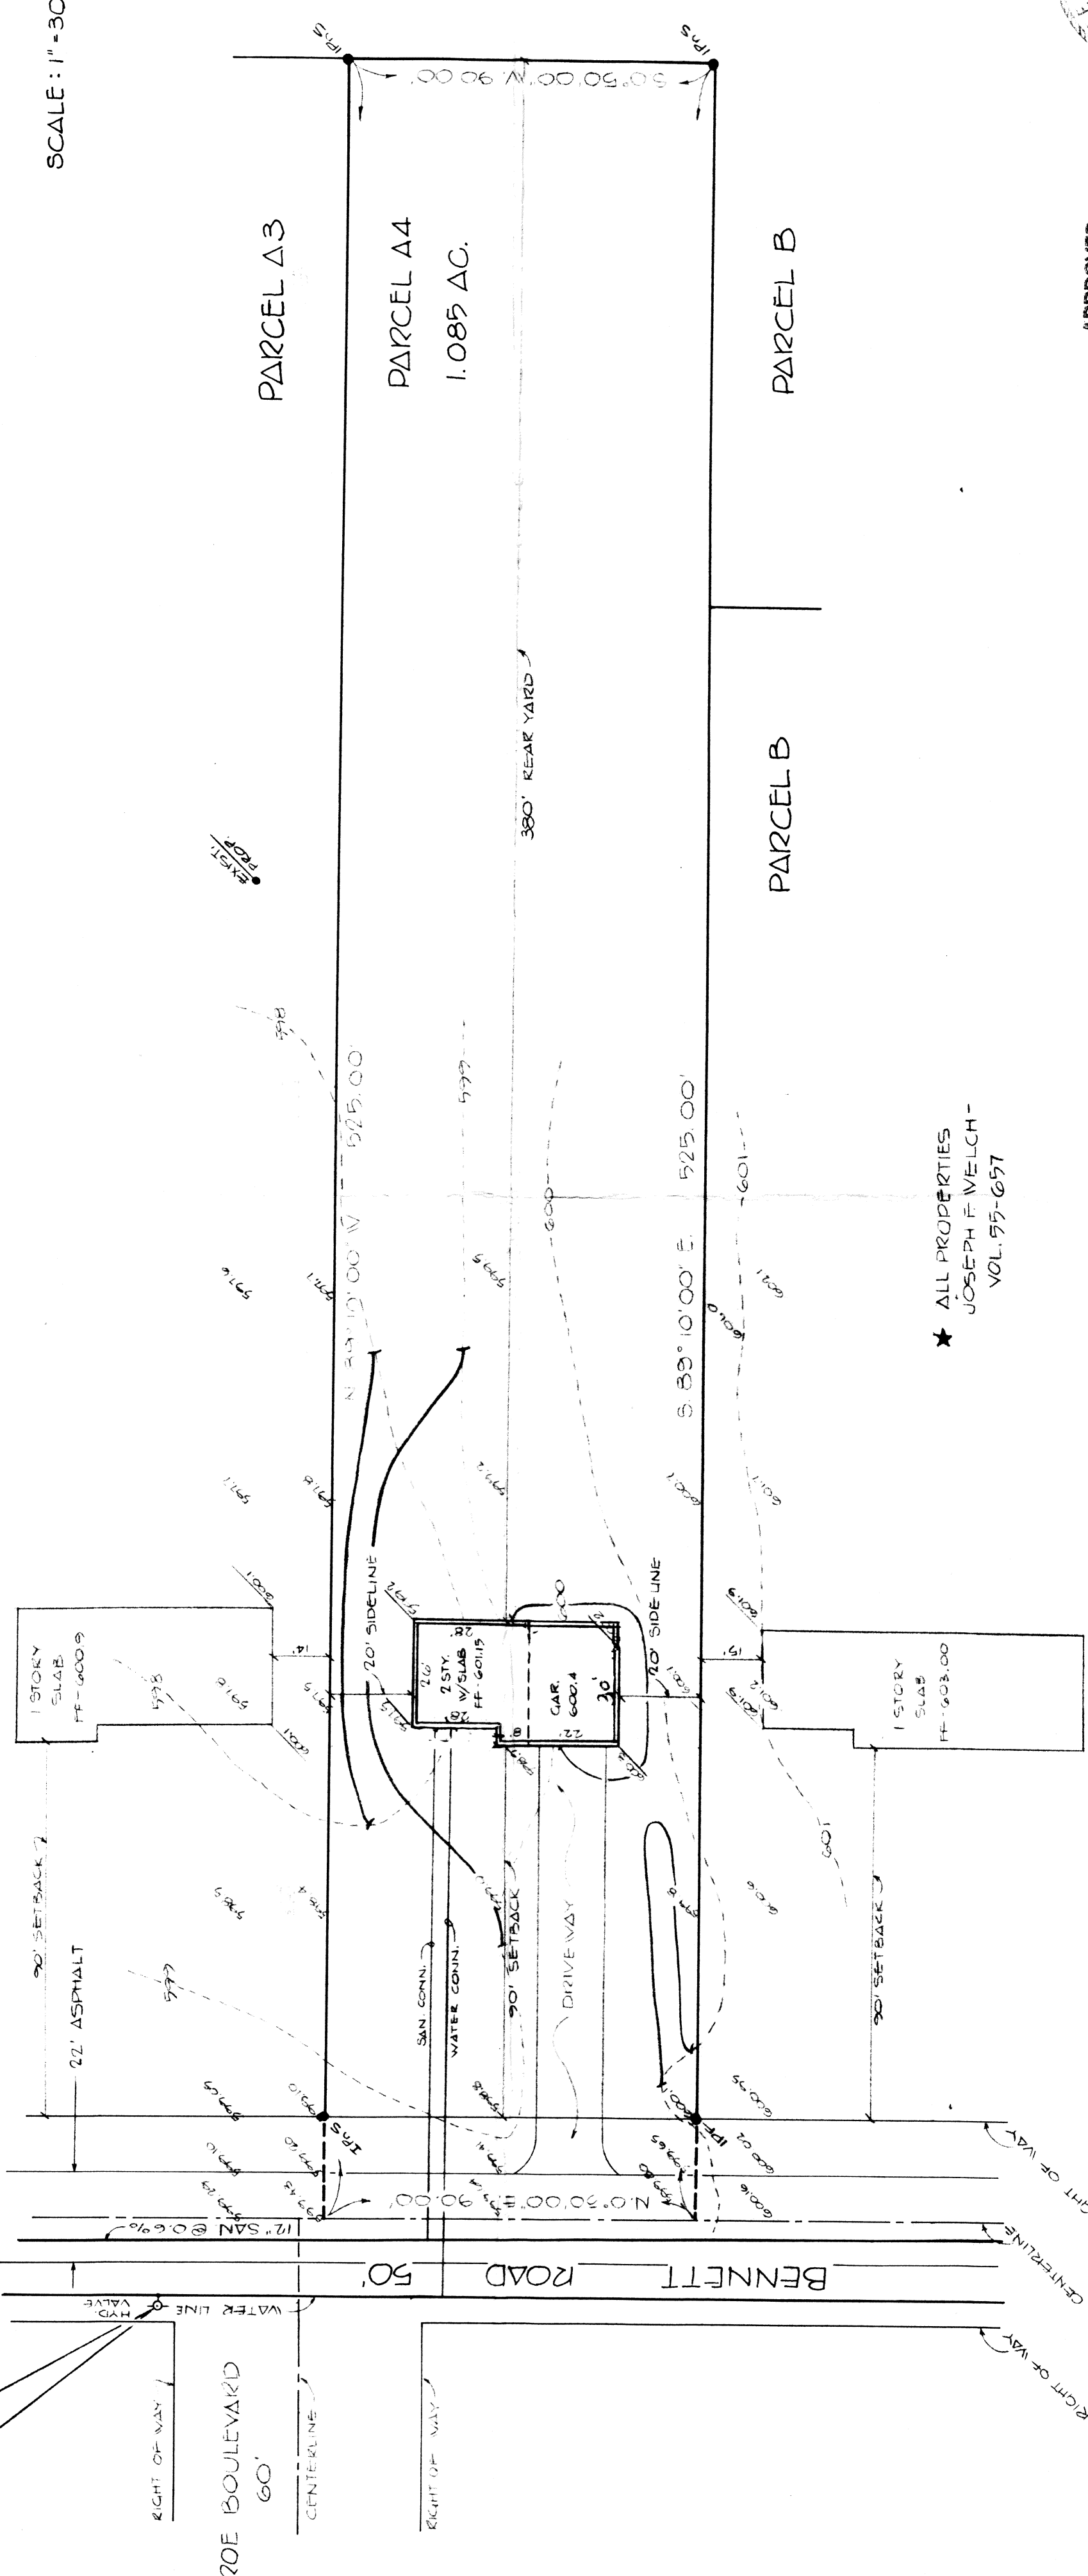

SCALE: 1" = 30'

APPROVED
MADISON TWP. ZONING

Permit 12168

Zoning inspector: J. G. Smith



VILLAGE SURVEYING CO.

THOMAS M. COFFMAN, P.S.
202 THIRD STREET, FAIRPORT HARBOR, OH. 44077
(216) 357-1359

Plan Approved
shown and/or noted
THOMAS P. GILLES, P.E.
Lake County Engineer

By J. M. P. Date 10.5.87

THIS PLAT WAS PREPARED BY ME AND IS TRUE AND ACCURATE TO THE BEST OF MY KNOWLEDGE AND BELIEF.

THOMAS M. COFFMAN No. 6857