


SITE PLAN
 FOR
 STERLING HOMES
 BEING PART OF THE BOLLES LOT, TRACT 2,
 IN THE TOWNSHIP OF MADISON, LAKE COUNTY, OHIO.

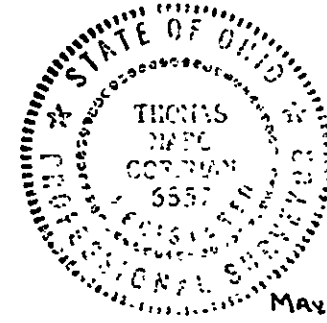


MAY 22, 1998

I, the undersigned hereby certify that
 this topography, indicated by 1' contours
 and elevations shown hereon represent an
 actual field survey made by me on MAY 12, 1998
 and that the elevations were taken at
 appropriate intervals and that as of that
 date they existed as indicated hereon.

J. W. Coffman, S.
No. 6257

SCALE: 1" = 20'

N

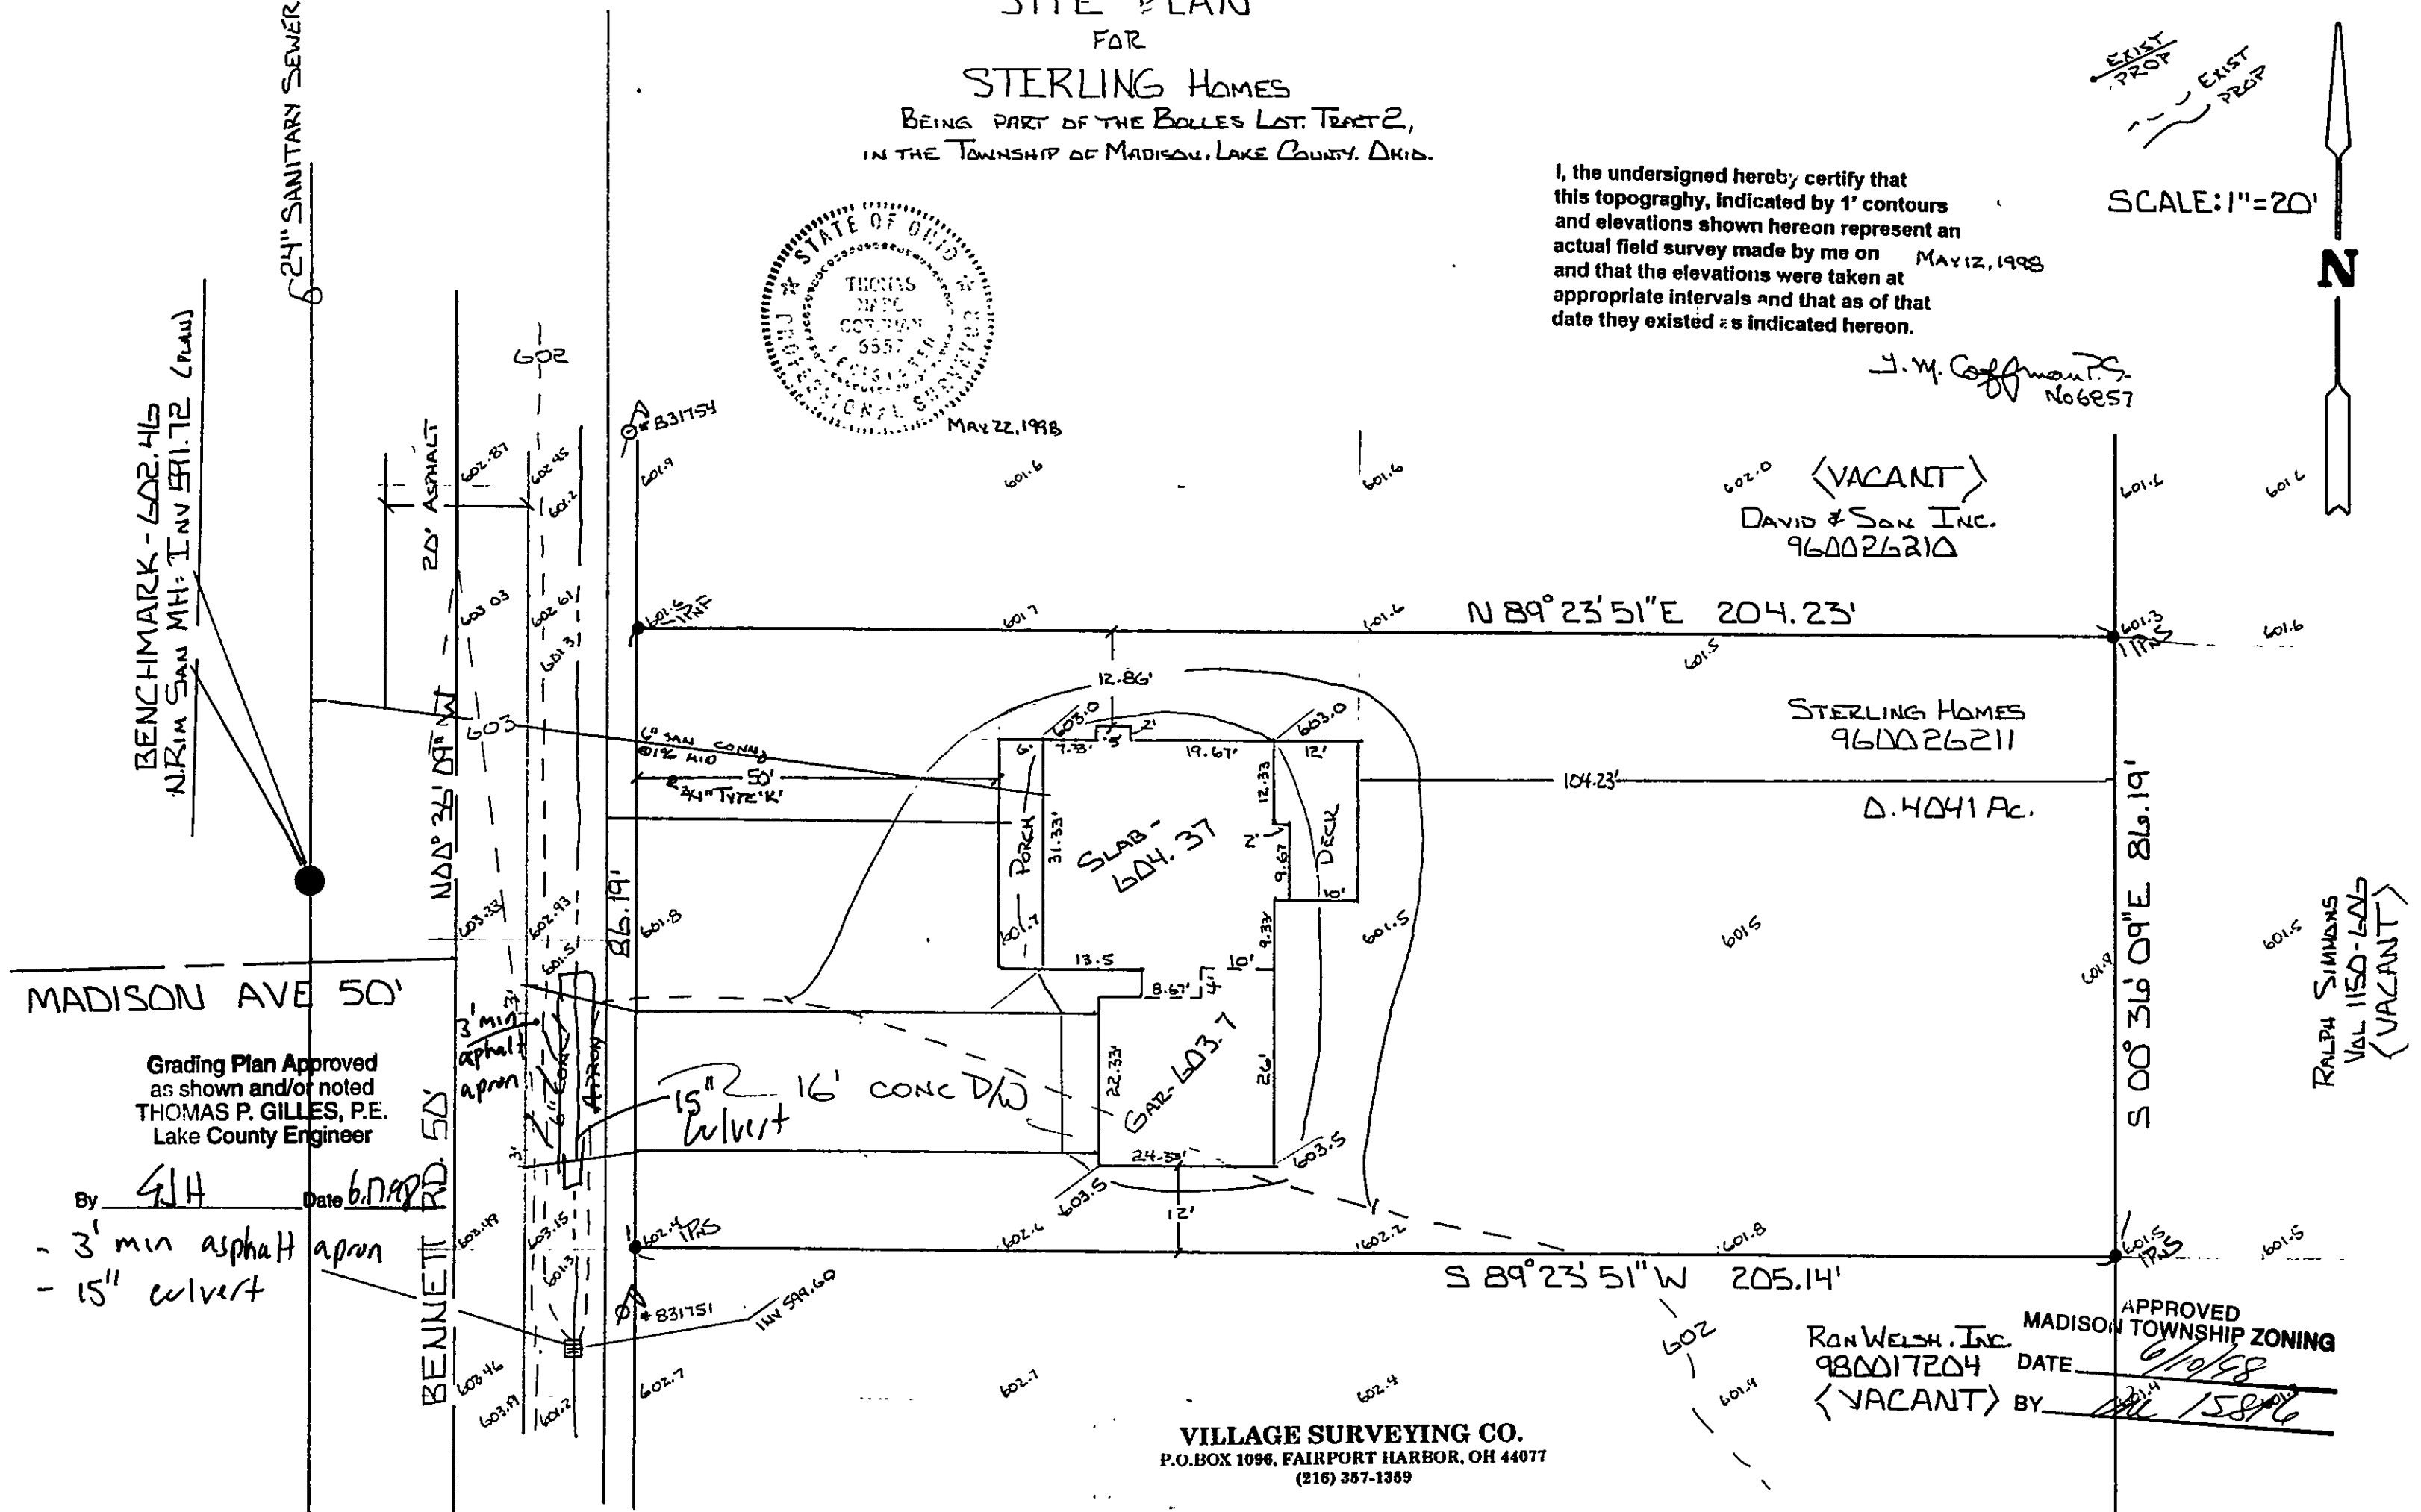

STERLING HOMES
 960026211
 0.4041 AC.

RALPH SIMMONS
 960017204
 (VACANT)

APPROVED
 MADISON TOWNSHIP ZONING
 DATE 6/10/98
 BY [Signature]
 RAN WELSH, INC.
 960017204
 (VACANT)

VILLAGE SURVEYING CO.
 P.O. BOX 1096, FAIRPORT HARBOR, OH 44077
 (216) 357-1359