


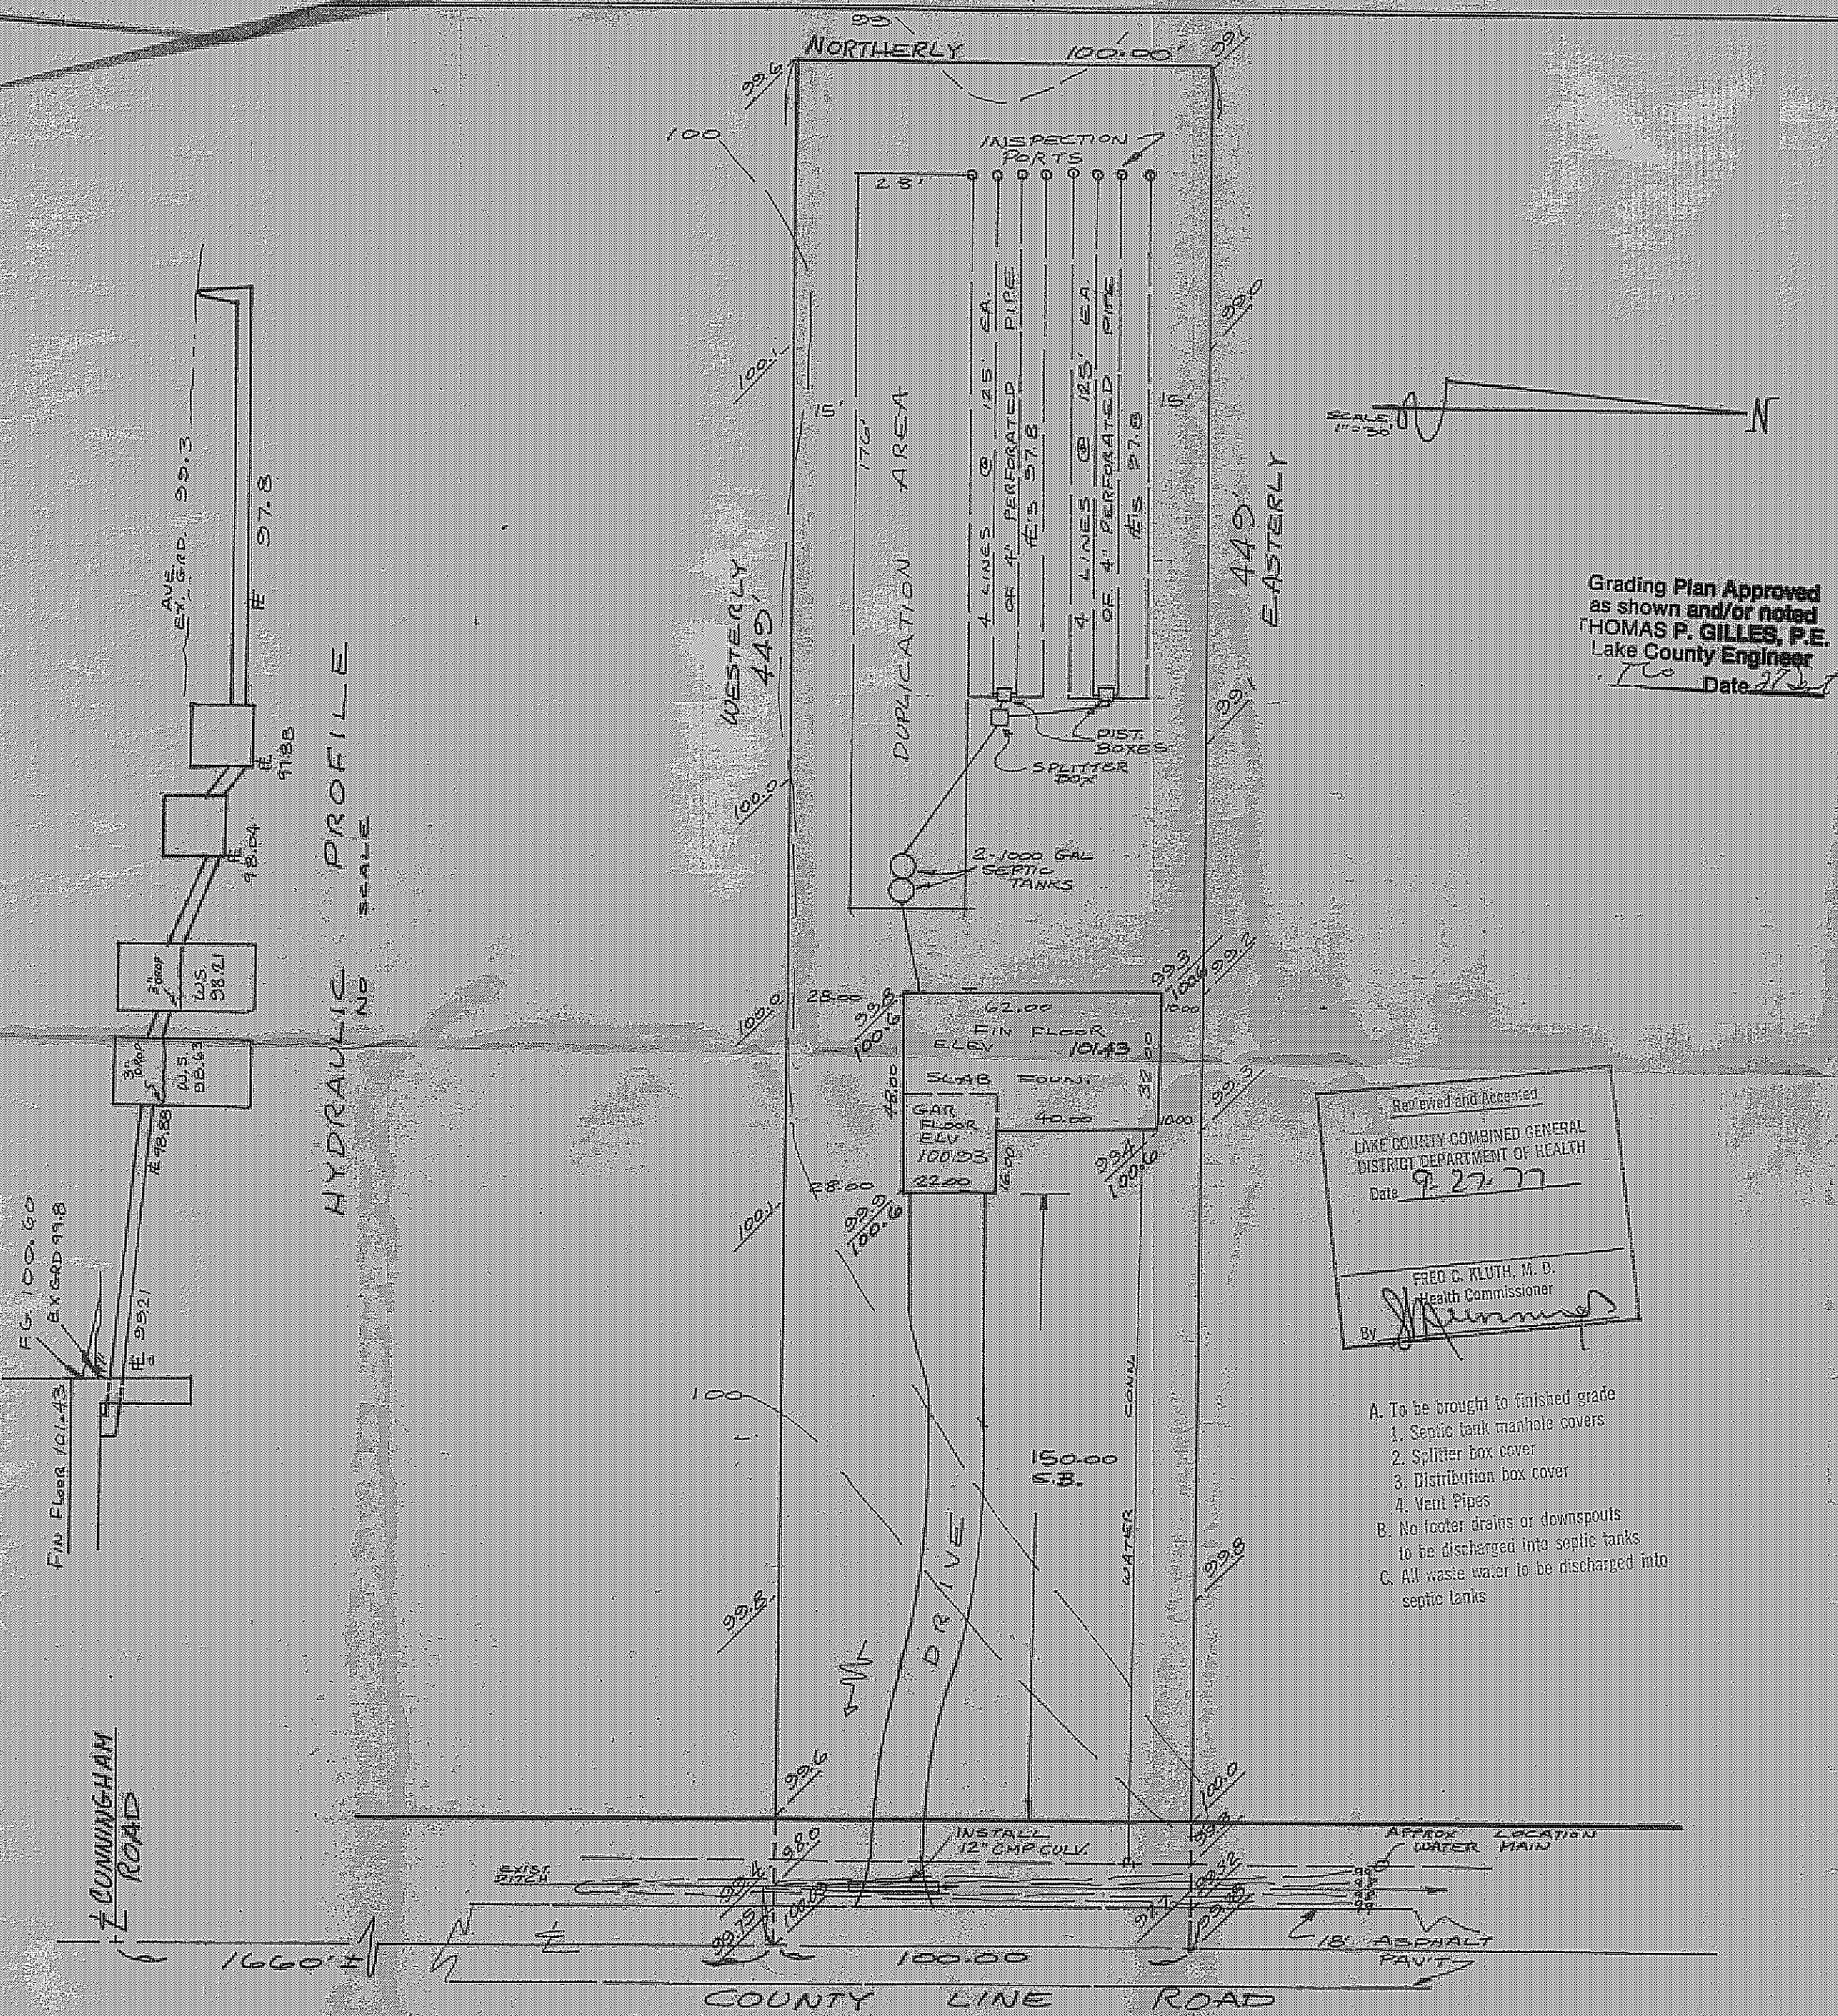

SITE PLAN

for **THOMAS HAYDEN**

CLIENT

OWNER

1935 SPRING GROVE MADISON, OHIO
ADDRESS STREET CITY

SUBLOT NO. 12, 1 SUBDIVISION NAME MADISON TWP., OHIO
LOT, TRACT

REMARKS

ALL BOUNDARY DATA SHOWN WAS OBTAINED FROM (DEEDS, RECORDED SUBDIVISION PLAT OR OTHER PUBLIC RECORDS). LOCATIONS AS SHOWN OF ADJACENT WELLS AND SEPTIC TANKS OBTAINED FROM LAKE COUNTY HEALTH DEPARTMENT.

LEGEND

SANITARY MANHOLE ———— ① WATER VALVE (GAS) ———— ②
PROPOSED CONTOURS ———— 100.0
EXIST. ELEV. ———— 100.0
100.0 ———— PROP. ELEV.

CHECK LIST

NO. OF BEDROOMS
DIMENSIONS
BEARINGS
TIE TO NEAREST STREET
SUBLOT NO. PARCEL NO.
SURROUNDING OWNERS
BLDG. DIMENSIONS FIN. GR.
BLDG. TIES FLT. GRADES
APRON TYPE WIDTH THICKNESS
SIDEWALK TYPE WIDTH THICKNESS
CULVERT TYPE DIA. LENGTH
ROCK OUTCROPPINGS

WATER MAIN SIZE, LOCATION
SAN. SEWER SIZE % GR. LOC.
SAN. MH. CAST. ELEV. IN. ELEV.
SAN. CONN. SIZE, LOC. DEPTH
STORM SEWER SIZE % GR. LOC.
STORM MH. CAST. ELEV. INV. ELEV.
PAVT TYPE GRADE CURBS
GAS LINE LOC. SIZE PRESSURE
SEPTIC TANK LOCATION &
DUPLICATION AREA
WELL LOCATION
ISOLATION RADIUS FROM WELL

DESIGN CERTIFICATION

THIS PLAT WAS PREPARED BY ME, AND IS CORRECT TO THE BEST OF MY KNOWLEDGE AND BELIEF.

NAME SURVEYOR REGISTRATION NO.

"AS BUILT" CERTIFICATION

I HEREBY CERTIFY THAT THE CIRCLED GRADES ARE EXISTING GRADES OBTAINED ON THE SITE ON 19 AND ARE CORRECT TO THE BEST OF MY ACKNOWLEDGMENT AND BELIEF.



LAND DESIGN consultants, inc.

9613 JACKSON STREET, MENTOR, OHIO 44060
TELEPHONE (216) 951-6872 or 354-6646

1	Rev'd	9-26-77	DRAWN BY	SCALE	1"=30'	DRAWING NO.
2	RE-DRAWN	9/26/77	CHK'D.	DATE	9/26/77	169
3			CREW CHIEF	APP'D.		

Reviewed and Accepted
LAKE COUNTY COMBINED GENERAL
DISTRICT DEPARTMENT OF HEALTH
Date 9-27-77

FRED C. KLOTH, M. D.
Health Commissioner

- A. To be brought to finished grade
1. Septic tank manhole covers
 2. Splitter box cover
 3. Distribution box cover
 4. Vent Pipes
- B. No footer drains or downspouts to be discharged into septic tanks
- C. All waste water to be discharged into septic tanks

T.B.M.

TOP OF IRON PIN @
NELY PROP COR

ELEV 100.00
(ASSUMED)