



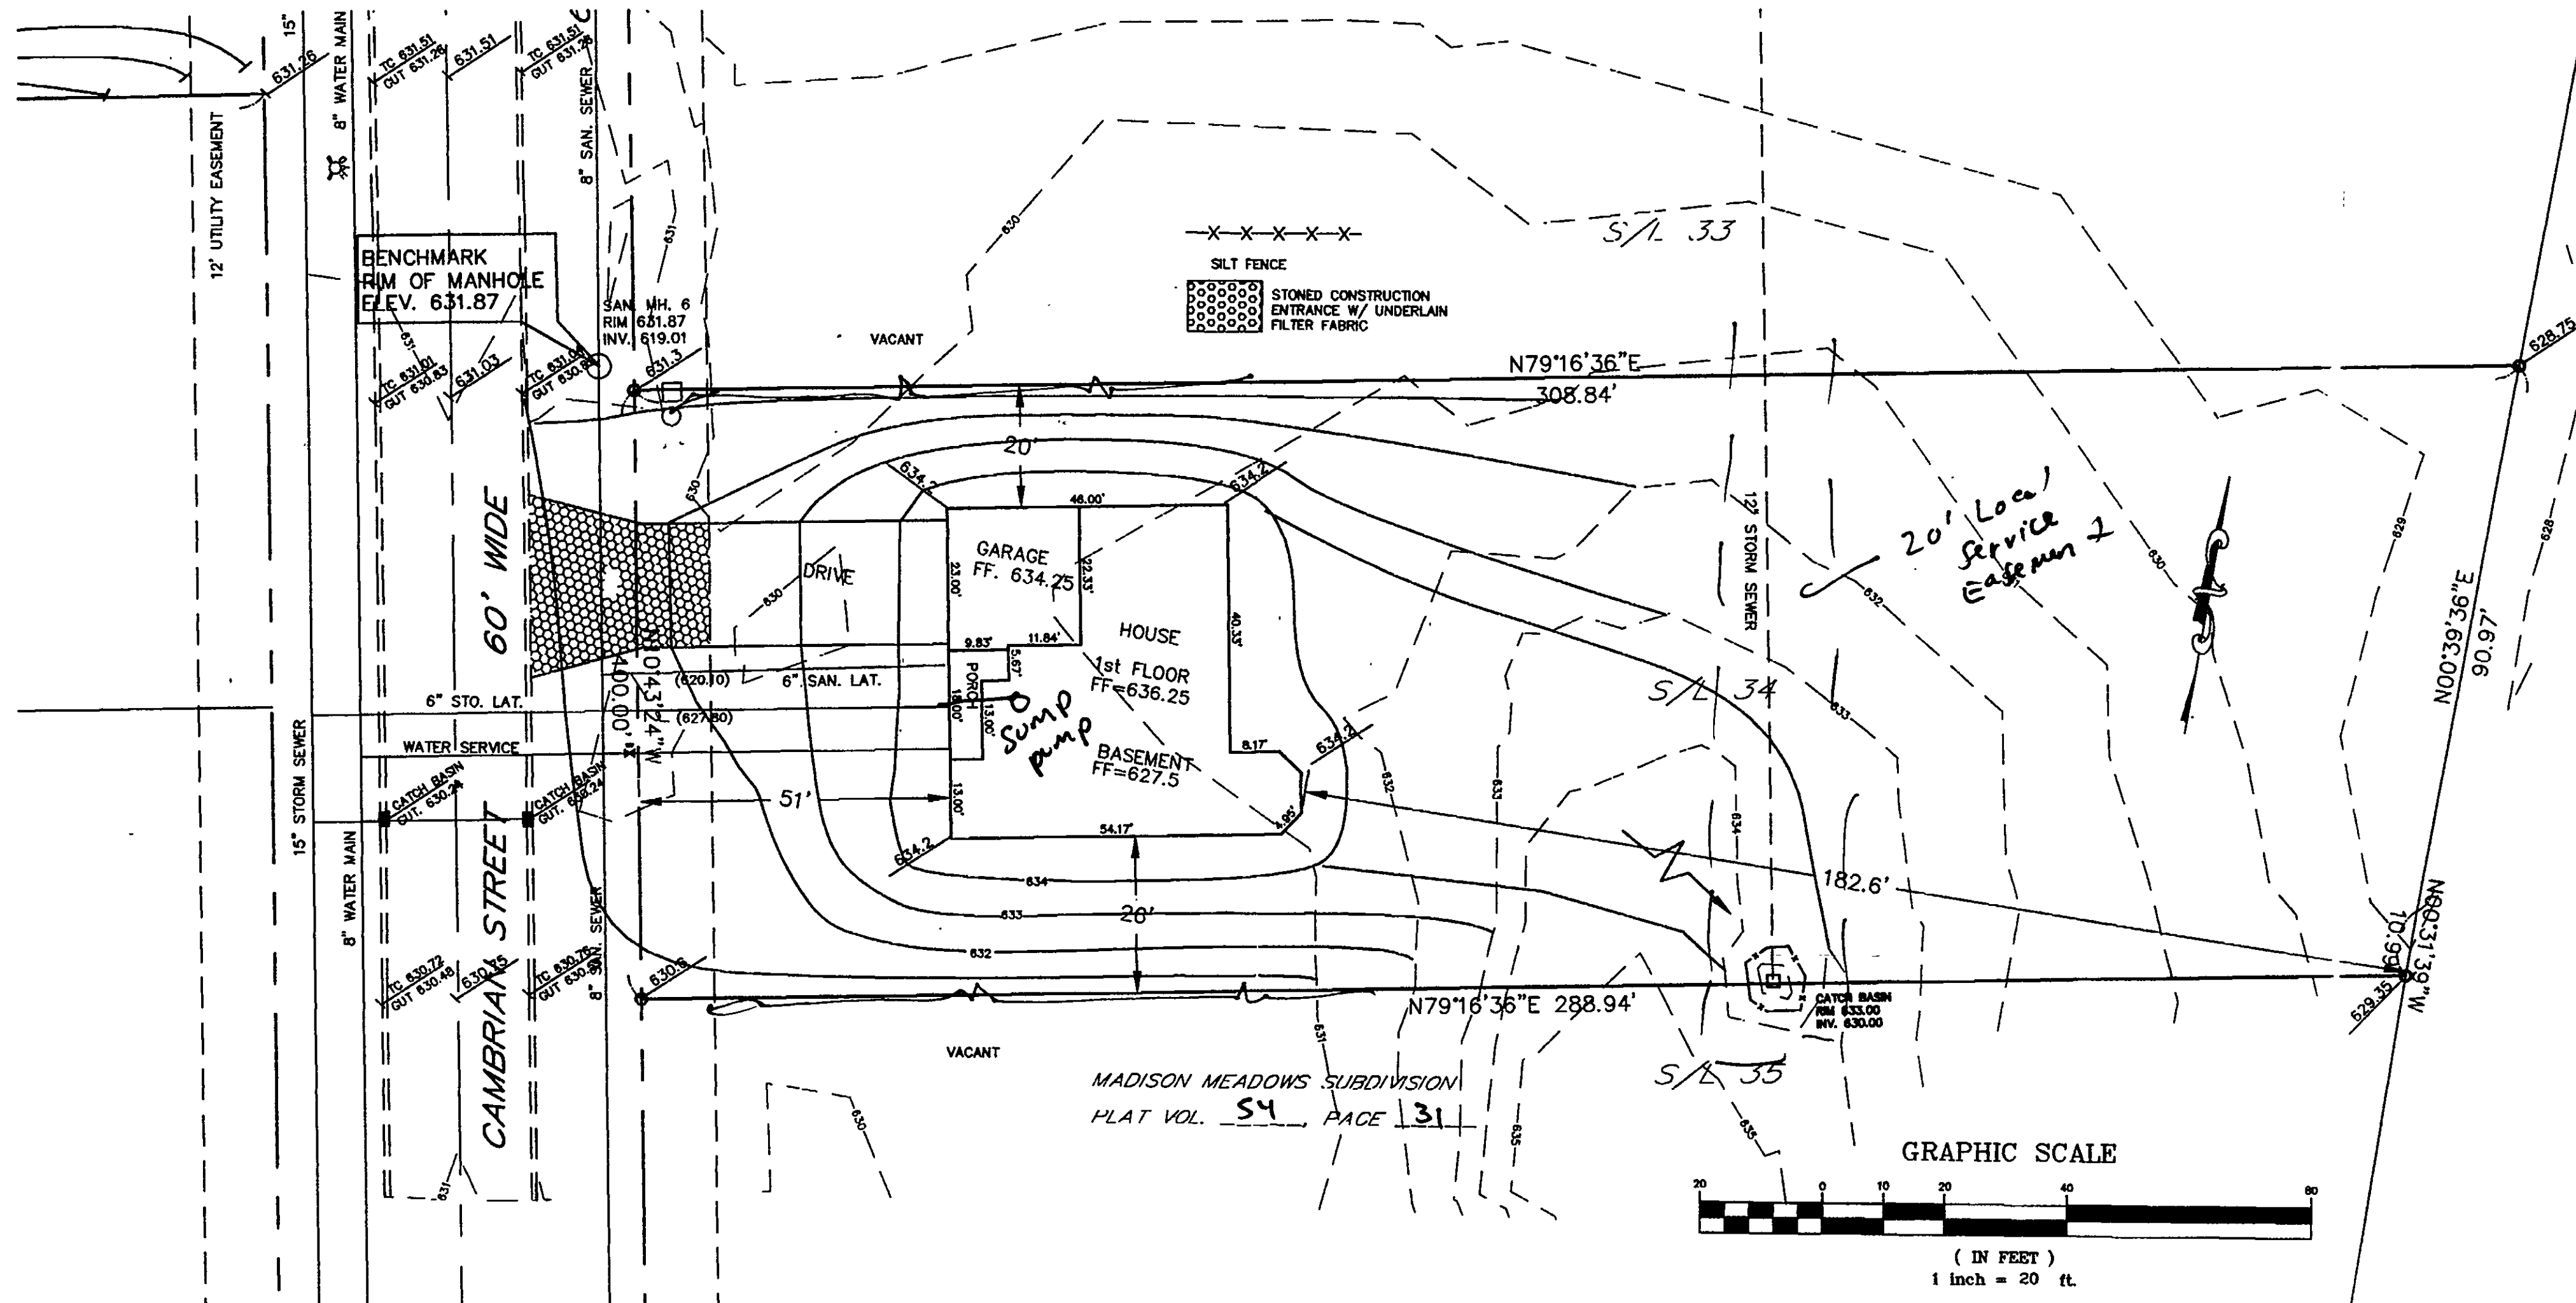

I, the undersigned hereby certify that this topography, indicated by 1' contours and elevations shown hereon represents an actual field survey made by me in March, 2007 and that the elevations were taken at appropriate intervals and that as of that date they existed as indicated hereon.

David A. Rapp 3/19/07
David A. Rapp

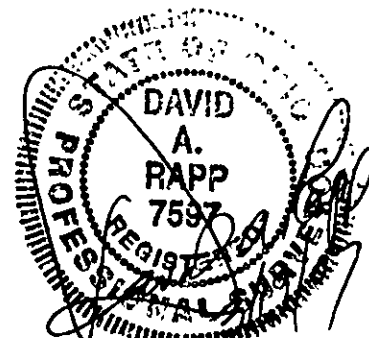

- NOTES: 1. The Contractor Shall Verify the Following Before Starting:
Finish Floor Elevations and House Size.
Location and elevation of existing utility connections.
2. Contractor Shall Contact OUPS at least 2 Working Days prior to construction, 1-800-362-2764.

Management Plan
as shown and/or noted.
JAMES R. GILLS, P.E.
County Drainage Engineer
By *W.H.* Date *4/5/07*
Swale along property lines
Discharge Sump pump to
Storm lateral.

ROOF DRAINS
SHALL DISCHARGE
TO SPLASH BLOCKS.

Subject to approval by:

- ☐ Planning Department
☐ General Health District
☒ Soil & Water Conservation District
☒ Building Department (final approval)

DAVID RAPP SERVICES

3406 DAYTON ROAD, MADISON, OHIO 44057
440-428-1686

DATE: March, 2007
DRAWN BY: DAR
APPROVED BY: DAR
P.S. No. 7597

HSM BUILDERS
MADISON MEADOWS SUBDIVISION
Site Plan For Sublot 34

D-27010

APPROVED
MADISON TOWNSHIP ZONING
DATE 4/3/07
BY JK Z-3004