

Erosion and Sediment Control Schedule

<u>Ingress-Egress</u>
A stone access drive complete with under lying geo-textile fabric (20 feet wide and 50 feet long) for ingress and egress at the site shall be installed. This drive shall be the only entrance and exit to the site.

Silt Fence

A silt fence shall be installed prior to any earthwork activities at the site in the locations shown on the site plan as well as along the front of any lot that slopes towards the street.

Temporary Seeding


Disturbed areas of the site that are to remain idle for more than twenty—one(21) days shall be properly seeded and straw mulched within seven(7) days of completion of intitial grading. Temporary seeding and mulching ao a thirty(30) foot strip of the entire front of the lot shall be maintained on the site once initial grading is complete.

Stabilization of critical areas within fifty(50) feet of any stream or wetland shall be complete within two(2) days of the disturbance if the site is to remain inactive for longer than fourteen(14) days.

Mulching
Straw—mulch shall be applied at a rate of 1 bale per every ten (10) feet of curb, at a width of thirty(30) feet to the entire length of the lot. Wood chips may also be used but must be spread at a minimum depth of four inches over the thirty-foot width and must be accompanied by a properly installed silt fence.

<u>Maintenance</u>

Erosion and sediment controls shall be inspected every seven(7) days or within 24 hours of a 0.5" or greater rainfall event. Necessary repairs shall be made at this time.

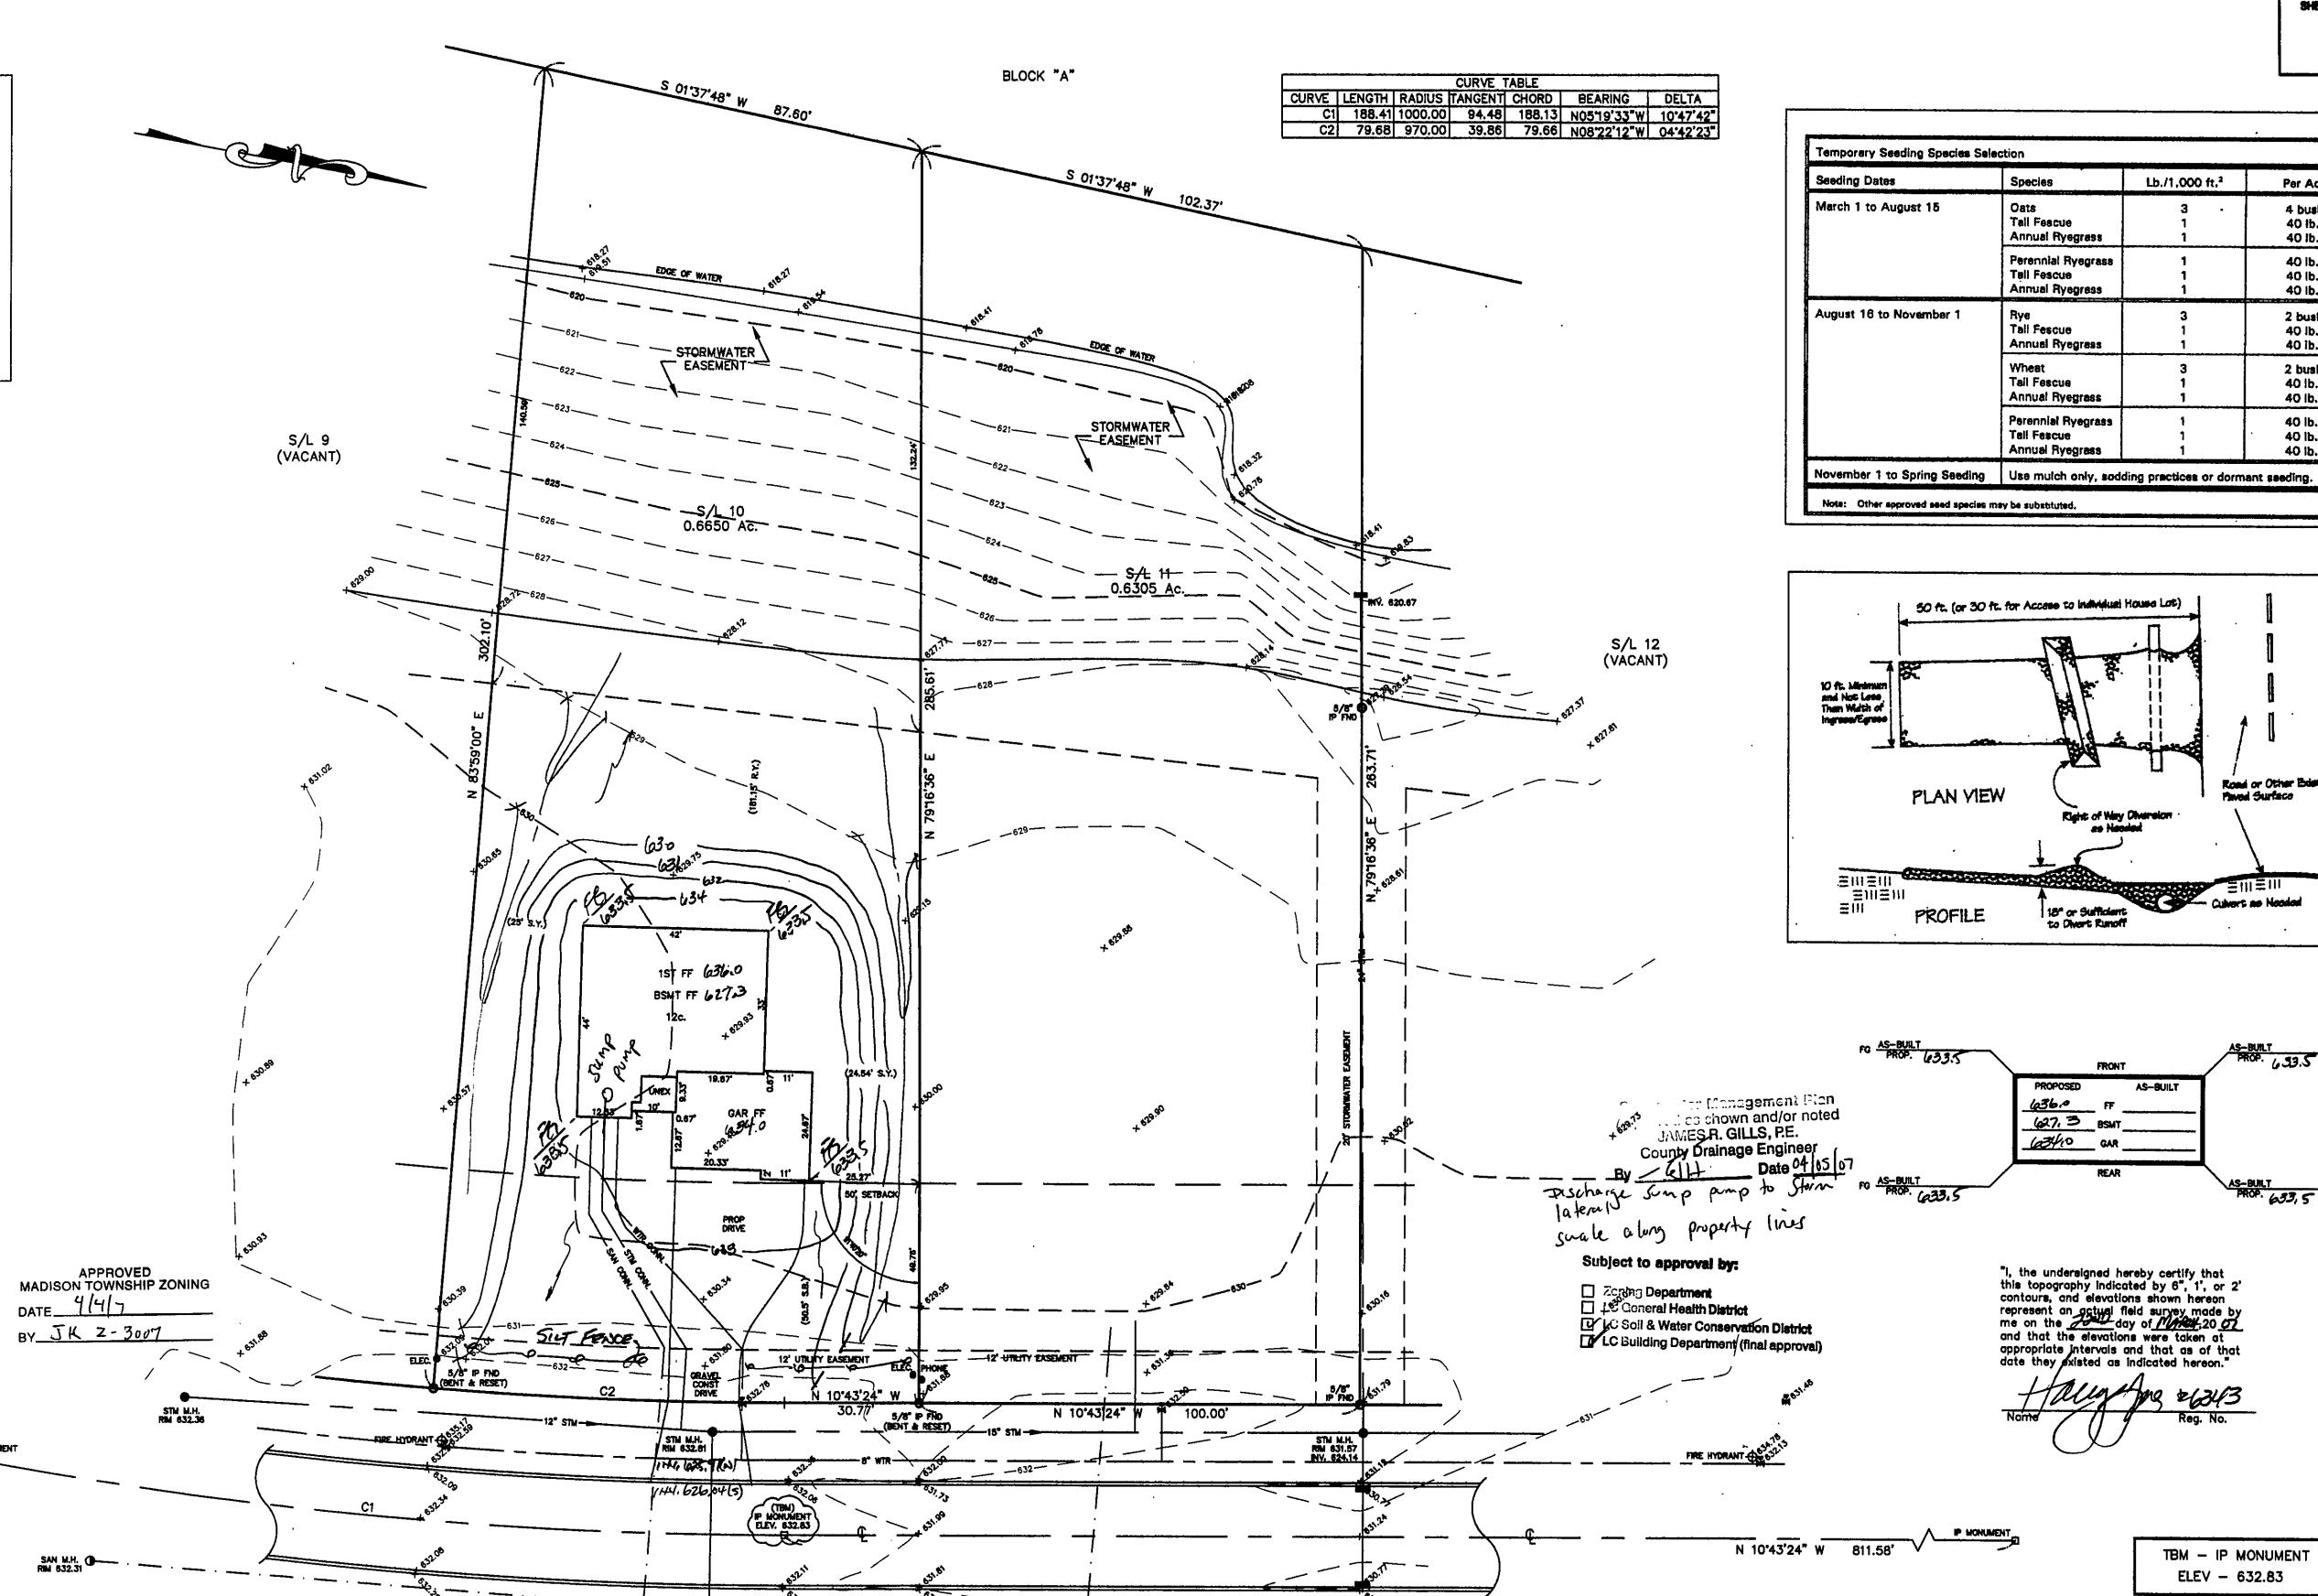

2332 CAMBRIAN STREET - 60'

EXISTING UTILITIES NOTE:
THE SIZE AND LOCATION, BOTH HORIZONTAL AND VERTICAL
OF THE UNDERGROUND UTILITIES SHOWN HEREON, HAVE BEEN
OBTAINED BY A SEARCH OF AVAILABLE RECORDS.
VERIFICATION BY FIELD OBSERVATION HAS BEEN CONDUCTED
WHERE PRACTICAL, HOWEVER, BABCOCK, JONES AND ASSOCIATES
INC. DOES NOT GUARANTEE THE COMPLETENESS NOR ACCURACY
THEREOF.



Per Ac.

4 bushel

40 lb.

40 lb.

2 bushel

40 lb.

40 lb.

2 bushel

40 lb.

40 lb.

AS-BUILT FG

REV NO.	DESCRIPTION	DATE	BY	CHK*D	-	
					1 4	DADCOCK TONES AND ASSOCIATES
					ha	BABCOCK, JONES AND ASSOCIATES
					γı	CIVIL ENGINEERS - SURVEYORS - LAND PLANNERS
				 /		PAINESVILLE OHIO 44077

3/29/07 APPROVED BY H.J. MADISON TOWNSHIP

SITE PLAN CAPUTO

- - J

S/L 10 CAMBRIAN STREET (MADISON MEADOWS SUB) LAKE COUNTY STATE OF OHIO

1"=20" JOS NO 05-138-10