


24 House  
Elev. 95.8

DAVID BAUGH & RICHARD BODER  
Vol. 763-Pg. 1186


REVIEWED AND ACCEPTED  
LAKE COUNTY GENERAL  
HEALTH DISTRICT

Date 5-29-97 BY Jerry Lusk

SEWAGE DISPOSAL PERMIT MUST BE  
OBTAINED BY A LAKE COUNTY LICENSED  
INSTALLER BEFORE INSTALLATION IS  
STARTED

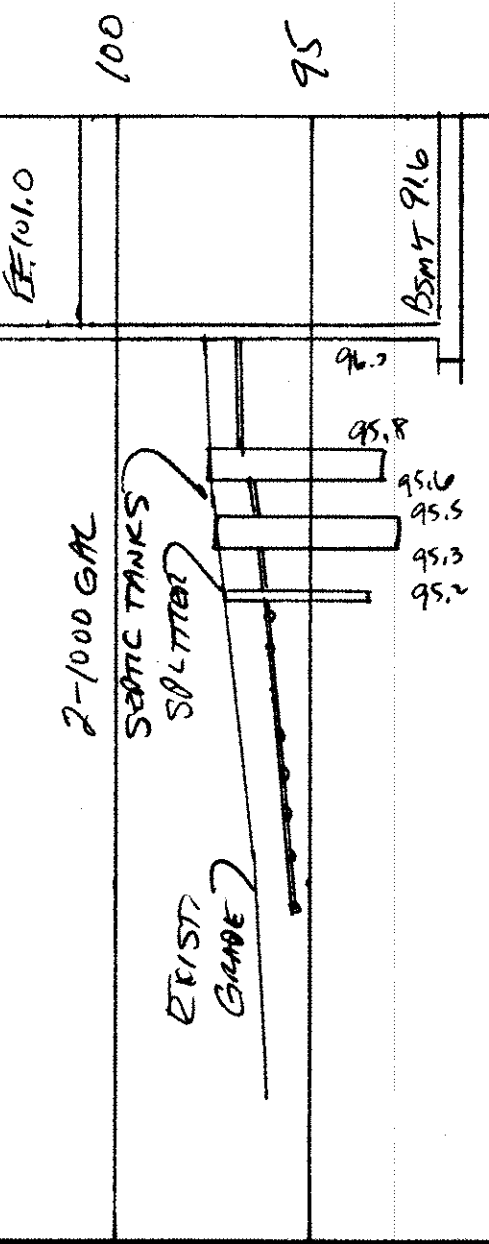

HYDRAULIC PROFILE  
HORIZ. 1"=20' VERT. 1"=5'

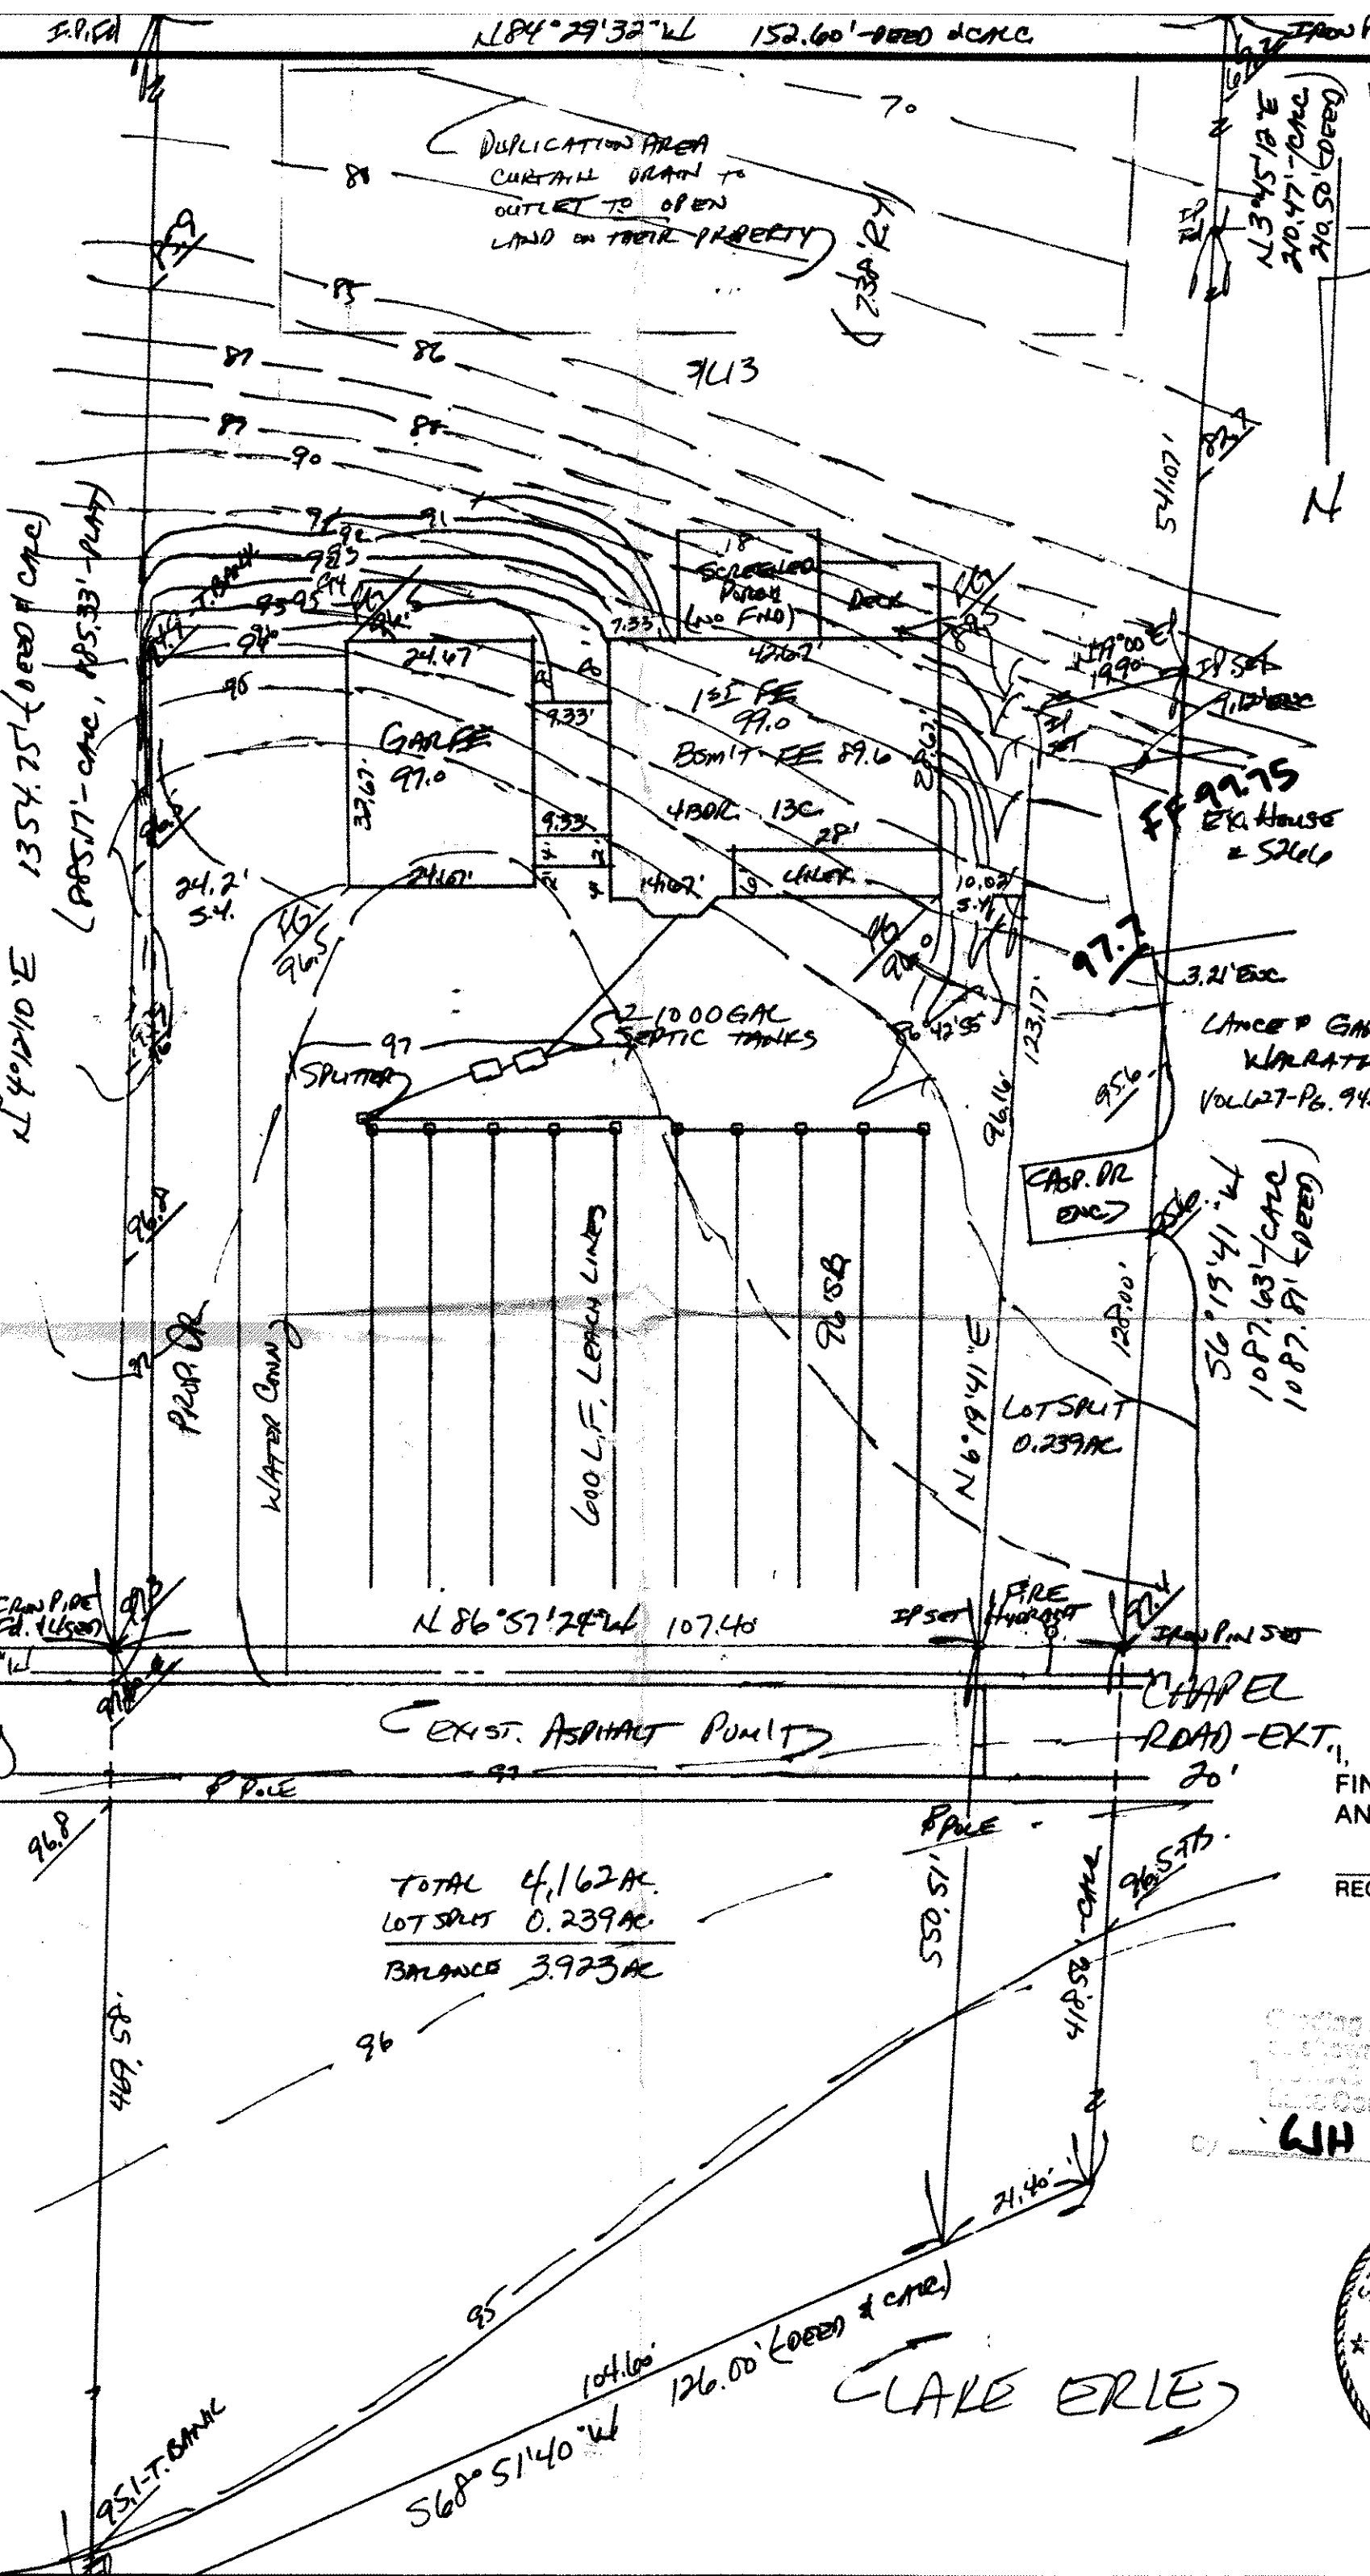

# SITE PLAN

MADISON TOWNSHIP, LAKE COUNTY, OHIO

for: JUDY MILLER  
CLIENT OWNER  
1725 BATHGATE DR. MADISON  
ADDRESS STREET CITY ZIP

SUBDIVISION	NAME	LOT	TRACT
13	VOL. - PG.	13	4
SUBLOT NO.	STREET	VOLUME	PAGE
		13-12P-13	10. EST.
		PERM. PARCEL NO.	STREET

LEGEND	
SANITARY MANHOLE	WATER VALVE (GAS)
STORM MANHOLE	WATER METER (GAS)
INLET OR CATCH BASIN	AS BUILT ELEVATION
HYDRANT	INDICATES DIRECTION OF SURFACE DRAINAGE
EXISTING CONTOURS	
PROPOSED CONTOURS	
EXIST. ELEV.	PROP. ELEV.

REMARKS

ALL BOUNDARY DATA SHOWN WAS OBTAINED FROM (DEEDS, RECORDED SUBDIVISION PLAT OR OTHER PUBLIC RECORDS)

LOCATIONS AS SHOWN OF ADJACENT WELLS AND SEPTIC TANKS OBTAINED FROM LAKE COUNTY HEALTH DEPARTMENT

DESIGN CERTIFICATION

THIS PLAT WAS PREPARED BY ME, AND IS CORRECT TO THE BEST OF MY KNOWLEDGE AND BELIEF.

NAME Jerry Lusk SURVEYOR REGISTRATION NO. 6343

CHECK LIST	
NO. OF BEDROOMS	WATER MAIN SIZE, LOCATION
DIMENSIONS	SAN. SEWER SIZE % GR. LOC.
BEARINGS	SAN. MH. CAST. ELEV. INV. ELEV.
TIE TO NEAREST STREET	SAN. CONN. SIZE, LOC. DEPTH
SUBLOT NO. PARCEL NO.	STORM SEWER SIZE % GR. LOC.
SURROUNDING OWNERS	STORM MH. CAST. ELEV. INV. ELEV.
BLDG. DIMENSIONS FIN. GR.	PAV'T TYPE GRADE CURBS
BLDG. TIES FLTR. GRADES	GAS LINE LOC. SIZE PRESSURE
APRON TYPE WIDTH THICKNESS	SEPTIC TANK LOCATION & DUPLICATION AREA
SIDEWALK TYPE WIDTH THICKNESS	WELL LOCATION
CULVERT TYPE DIA. LENGTH	ISOLATION RADIUS FROM WELL
ROCK OUTCROPPINGS	

REVISIONS			PLAN PREPARED BY:	
NO.	DATE	BY	BABCOCK • JONES & ASSOCIATES, INC.	
1	5/13/97	HT	PAINESVILLE, OHIO	
2	5/30/97	HT		
3	6/4/97	HT	DRAWN BY	SCALE 1"=20'
4	6/20/97	HT	CHK'D.	DATE 4/2/97
5	9/22/97	HT	CREW CHIEF	APP'D. 97-047

"AS BUILT" CERTIFICATION

I, HEREBY CERTIFY THAT THE CIRCLED GRADES ARE EXISTING FINISH GRADES CHECKED IN THE FIELD ON \_\_\_\_\_, 19\_\_\_\_ AND ARE CORRECT TO THE BEST OF MY KNOWLEDGE AND BELIEF.

REGISTERED SURVEYOR REG. NO.

TBM - TSF4 - ELEV. = 100.00

APPROVED  
MADISON TOWNSHIP ZONING

SEP 19 1997  
PERMIT # 15554  
ZONING INSPECTOR

9.24.97

"I, the undersigned hereby certify that this topography indicated by 6", 1' or 2' contours, and elevations shown hereon represent an actual field survey made by me on the 1st day of April, 1997 and that the elevations were taken at appropriate intervals and that as of that date they existed as indicated hereon."

Harry S. Jones, Jr. #6343  
Name Reg. No.

