


Vol. 174-9791

HORIZ. $1^{\circ} = 30'$
VERT. $1^{\circ} = 3'$



~~EXIST. PROP.~~

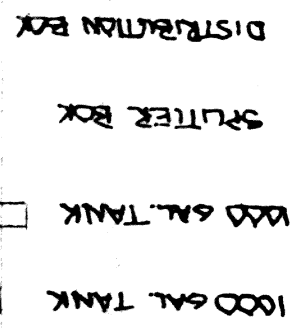