




I, THE UNDERSIGNED, DO HEREBY CERTIFY THAT THE TOPOGRAPHY SHOWN HEREON, INDICATED BY ONE FOOT CONTOURS, REPRESENTS AN ACTUAL FIELD TOPOGRAPHIC SURVEY MADE BY ME, AND THAT THE ELEVATIONS AS SHOWN HEREON EXISTED ON THE 2nd DAY OF JULY NINETEEN HUNDRED AND NINETY EIGHT.

James M. Peter

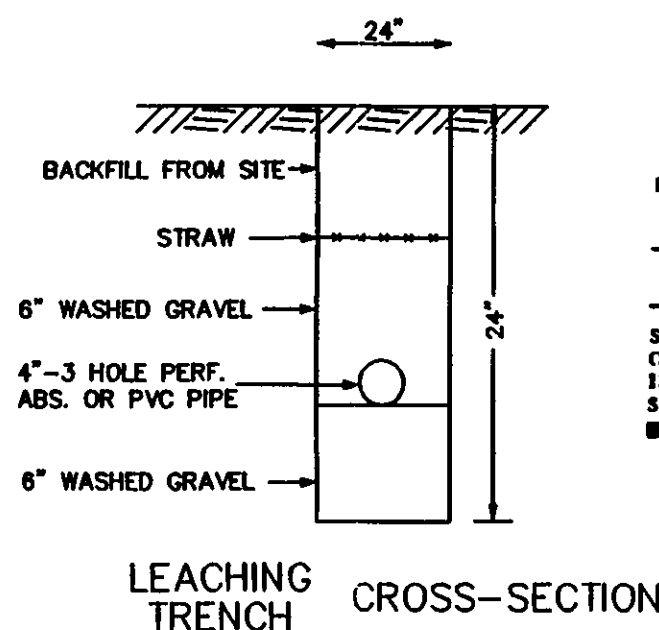

REVIEWED AND ACCEPTED
LAKE COUNTY GENERAL EL. 98.90
HEALTH DISTRICT
Date 7/22/98 BY Daniel Earl
SEWAGE DISPOSAL PERMIT MUST BE OBTAINED BY A LAKE COUNTY LICENSED INSTALLER BEFORE INSTALLATION IS STARTED.

SEPTIC SYSTEM PROFILE

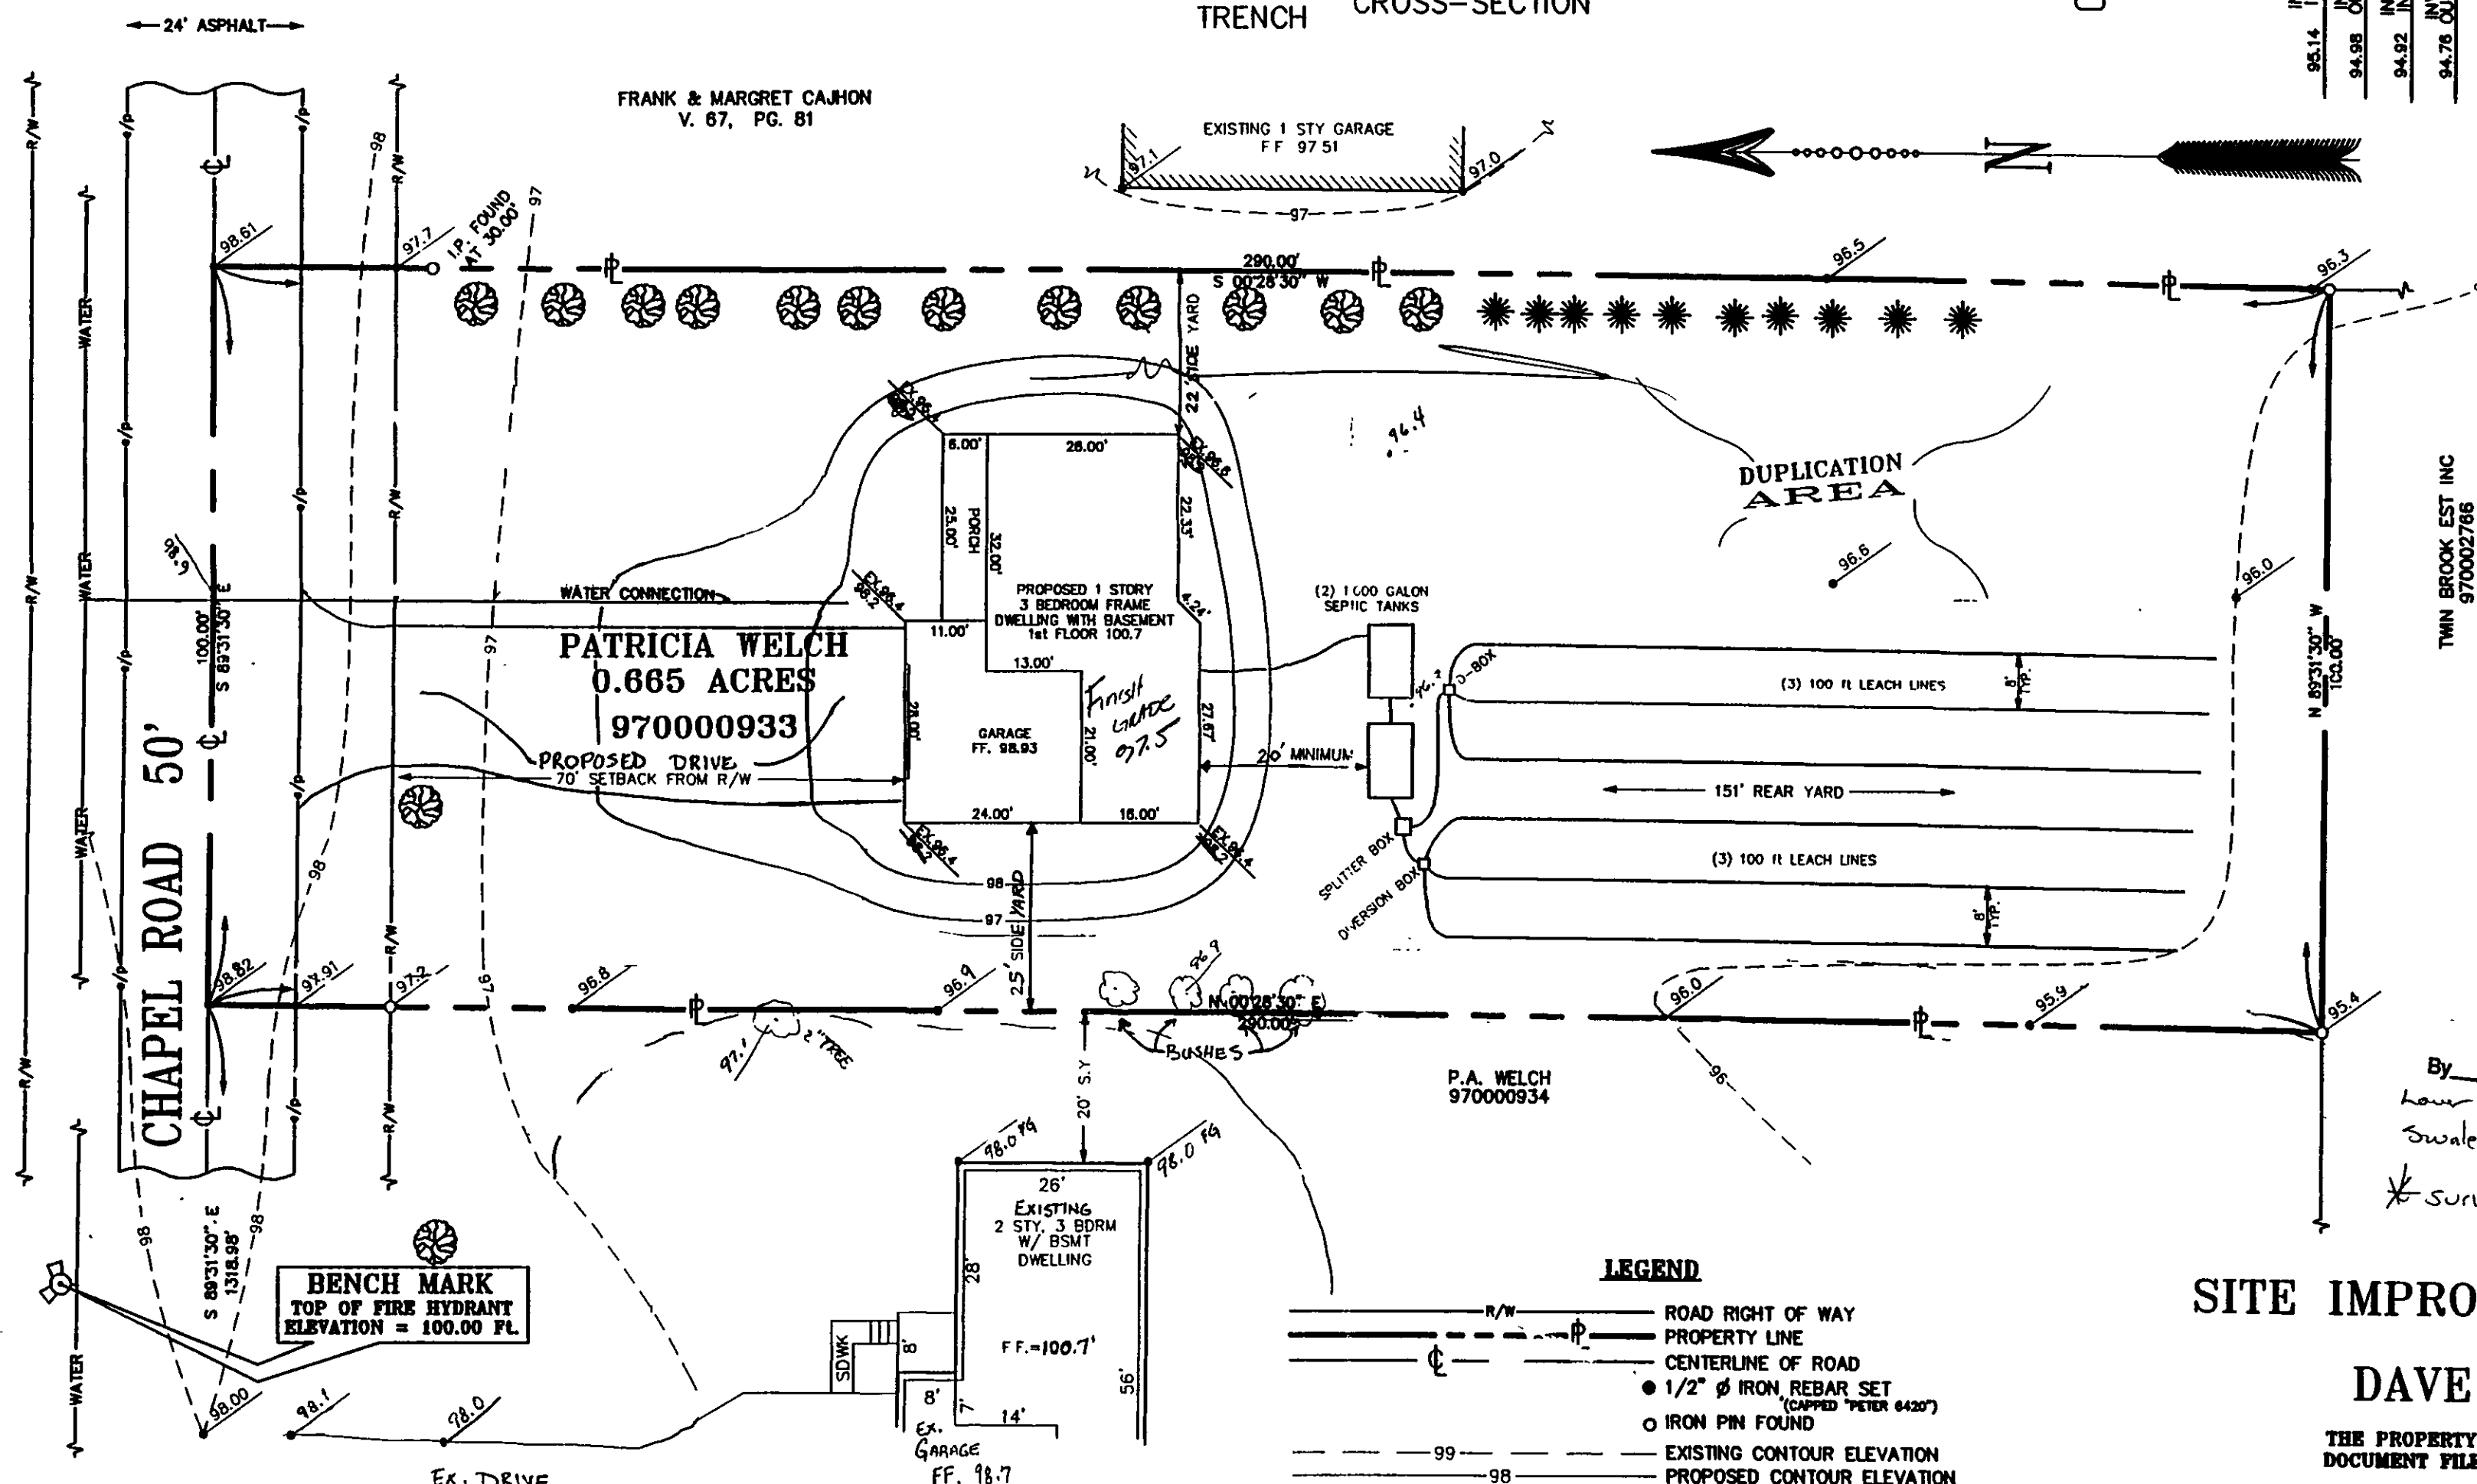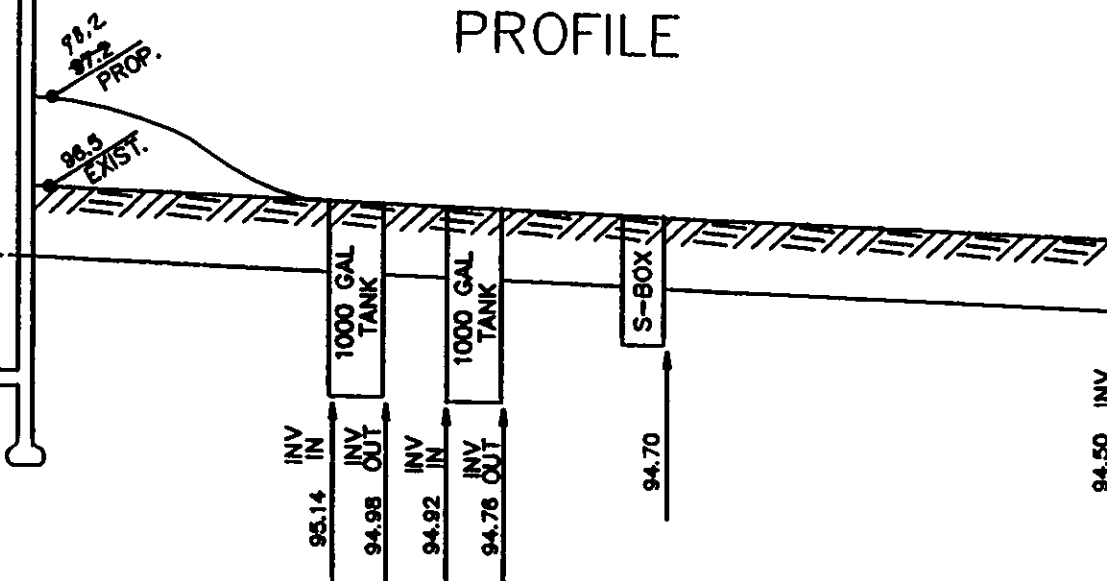

Jim Peter Land Survey
4759 Crosby-Cook Road
Rome, Ohio 44085
(216) 294-2187

Grading Plan Approved
as shown and/or noted
JAMES R. GILLS, P.E.
Lake County Engineer

By TAN Date 5/30/01
hour FG as noted
swale as shown
*surveyor stamp on attached

LEGEND

- ROAD RIGHT OF WAY
- PROPERTY LINE
- CENTERLINE OF ROAD
- 1/2" Ø IRON REBAR SET (CAPPED "PETER 6420")
- IRON PIN FOUND
- EXISTING CONTOUR ELEVATION
- PROPOSED CONTOUR ELEVATION
- EXISTING ELEVATION
- PROPOSED ELEVATION
- EXISTING EVERGREEN TREE
- EXISTING HARDWOOD TREE

SITE IMPROVEMENT PLAN FOR DAVE WELCH

THE PROPERTY OF PATRICIA WELCH
DOCUMENT FILE NUMBER 970000933

BEING A PART OF LOTS 8 & 9
TRACT 3 OF THE TOWNSHIP OF MADISON
COUNTY OF LAKE, STATE OF OHIO

10 JULY 1998 SCALE 1 In. = 20 ft.

REVISED 5/24/2001

THE FOUNDATION DIMENSIONS AND DRIVE LOCATION WERE REVISED BY COR CONSULTANTS. NO ADDITIONAL BEDROOMS WERE ADDED. ELEVATIONS SHOWN WERE VERIFIED.

David A. Rapp
DAVID A. RAPP
COR CONSULTANTS 440-466-8080