


Lorraine Zielinski

South 240.0

RAVINE

TOPO PLOT PLAN  
for  
**MICHAEL R. CHRISTOPHER**

Lot 7 TRACT 12  
MADISON TWP. LAKE CO. O  
1" = 40' Jan. 1977

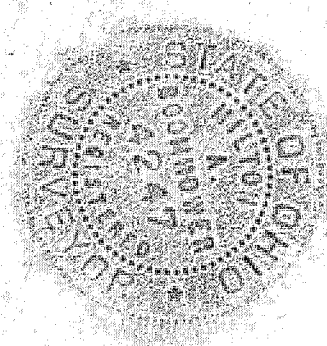

Milton H. Boomhower  
Reg. Surveyor 4247

Vacant  
acreage

Alternate  
leach area

Leach Field

2 Septic  
tanks

Proposed House


13/16" Spike  
in 10" Pipe  
100.00

Existing  
House  
110.1

Grading Plan Approved  
as shown and/or noted  
**THOMAS P. GILLES, P.E.**  
Lake County Engineer

By JWK Date 3-18-77

Joining # 9793

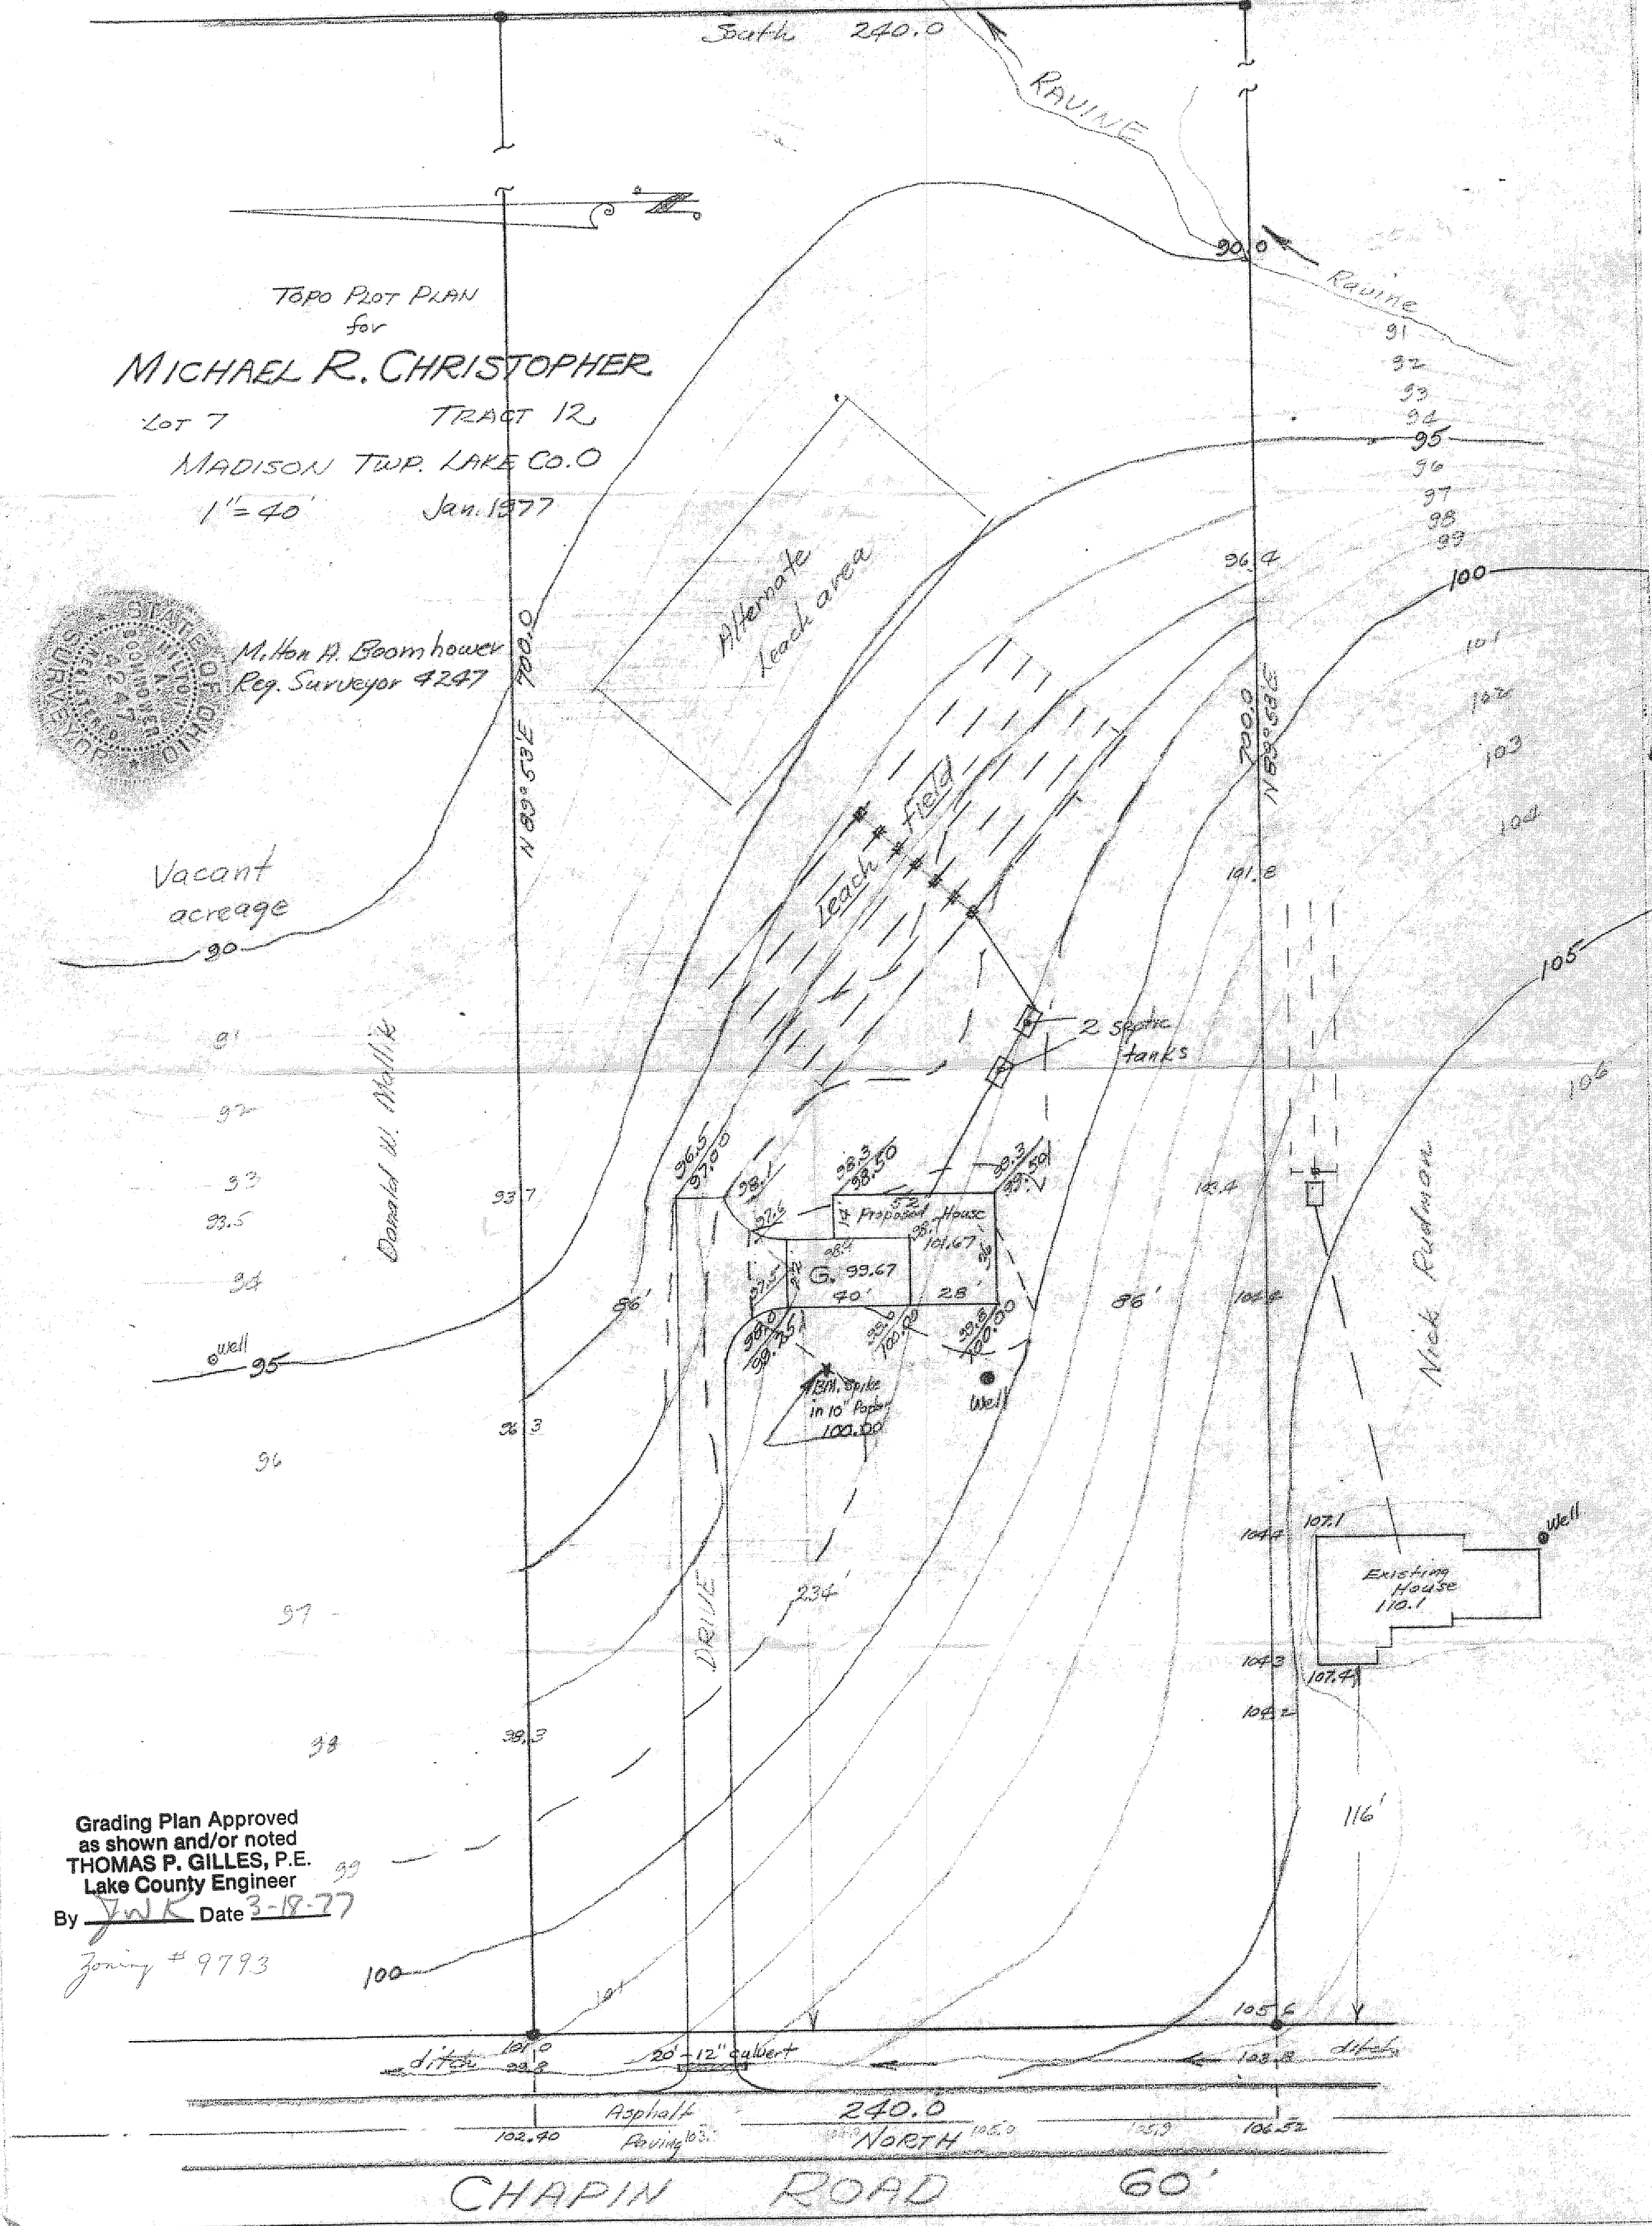

CHAPIN ROAD 60'

240.0  
NORTH