


I, the undersigned hereby certify that this topography, indicated by 1' contours, and elevations shown herein represent an actual field survey made by me on May 14, 1992 and that the elevations were taken at appropriate intervals and that as of that date they existed as indicated hereon.

J.M. Goffman

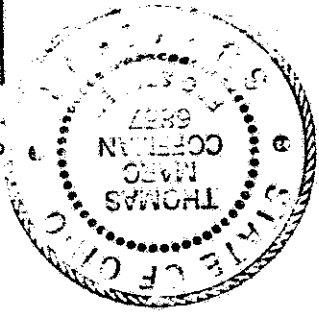

SITE PLAN

FDR

MADISON TRI AREA

HABITAT FOR HUMANITY

BEING 9/8, BLOCK No. 11, IN THE PARKVIEW SUBD., MADISON TOWNSHIP, LAKE CO., OHIO.

Grading Plan Approved

as shown and/or

THOMAS P. GILL

Lake County Engineer

By


J.H.

Date

SCALE: 1/4" = 20'



EXIST PROPOSED

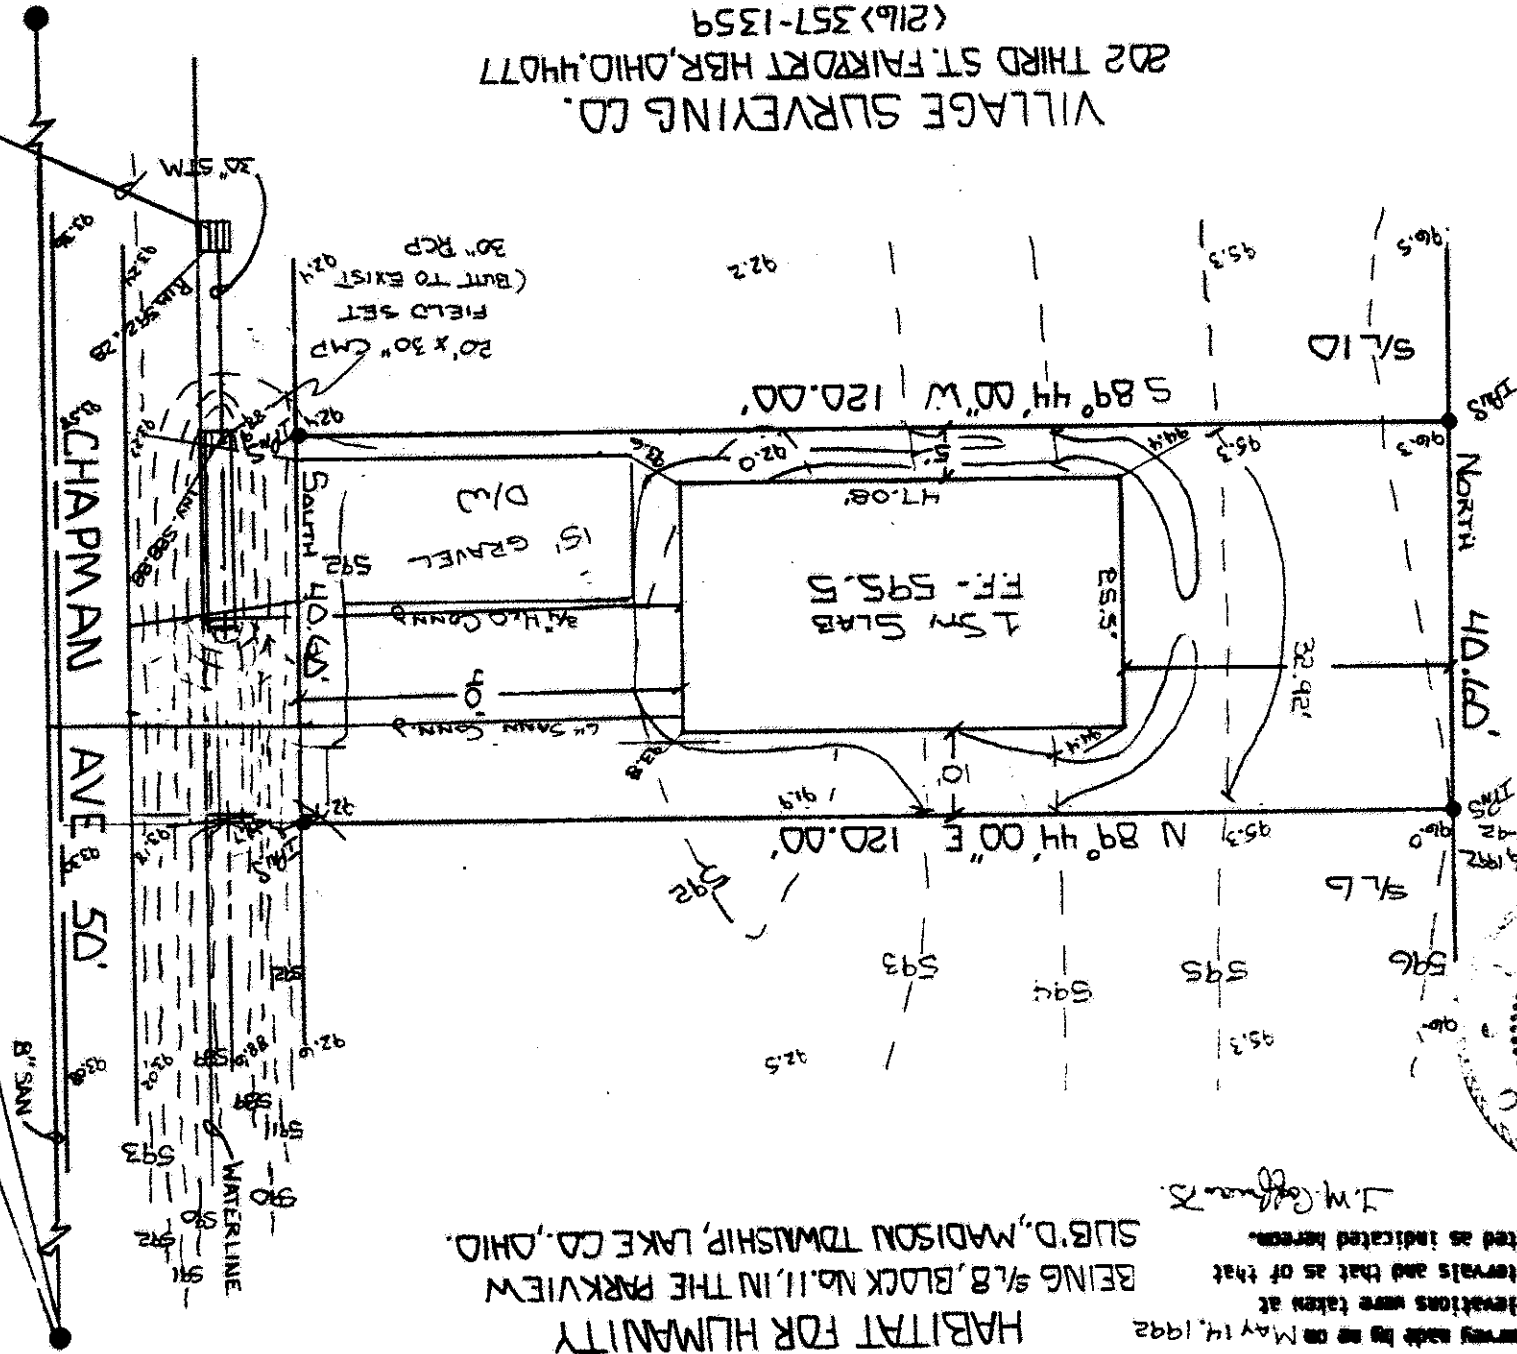

VILLAGE SURVEYING CO.
202 THIRD ST. FAIRPORT HBR, OHIO 44077
(216) 357-1359

BENCHMARK - 591.44
N. 1/4 M. SAN M.H. @ 40 TOWNSHIP - INV 583.57
1344
Zoning Inspector: JH

JUN. 10 1992