


1"=20' N

EXIST
PROP

EXIST
PROP

SITE PLAN FOR GLEN GNAGY

BEING 3/4 L.D. & N. 1/4 19' OF 3/4 L.D. PARKVIEW
SUB'D. IN THE TOWNSHIP OF MADISON,
COUNTY OF LAKE, STATE OF OHIO.

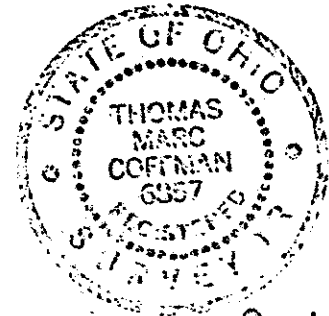


OCT. 1, 1993
REV HSE Nov. 2, 1993

Grading Plan Approved
as shown and/or noted
THOMAS P. GILLES, P.E.
Lake County Engineer

APPROVED
MADISON TWP. ZONING
13879
Being Inspector
NOV. 10 1993

VILLAGE SURVEYING CO.
FAIRPORT HARBOR OHIO 44017
(216) 357-1359

By 614 11.15.93

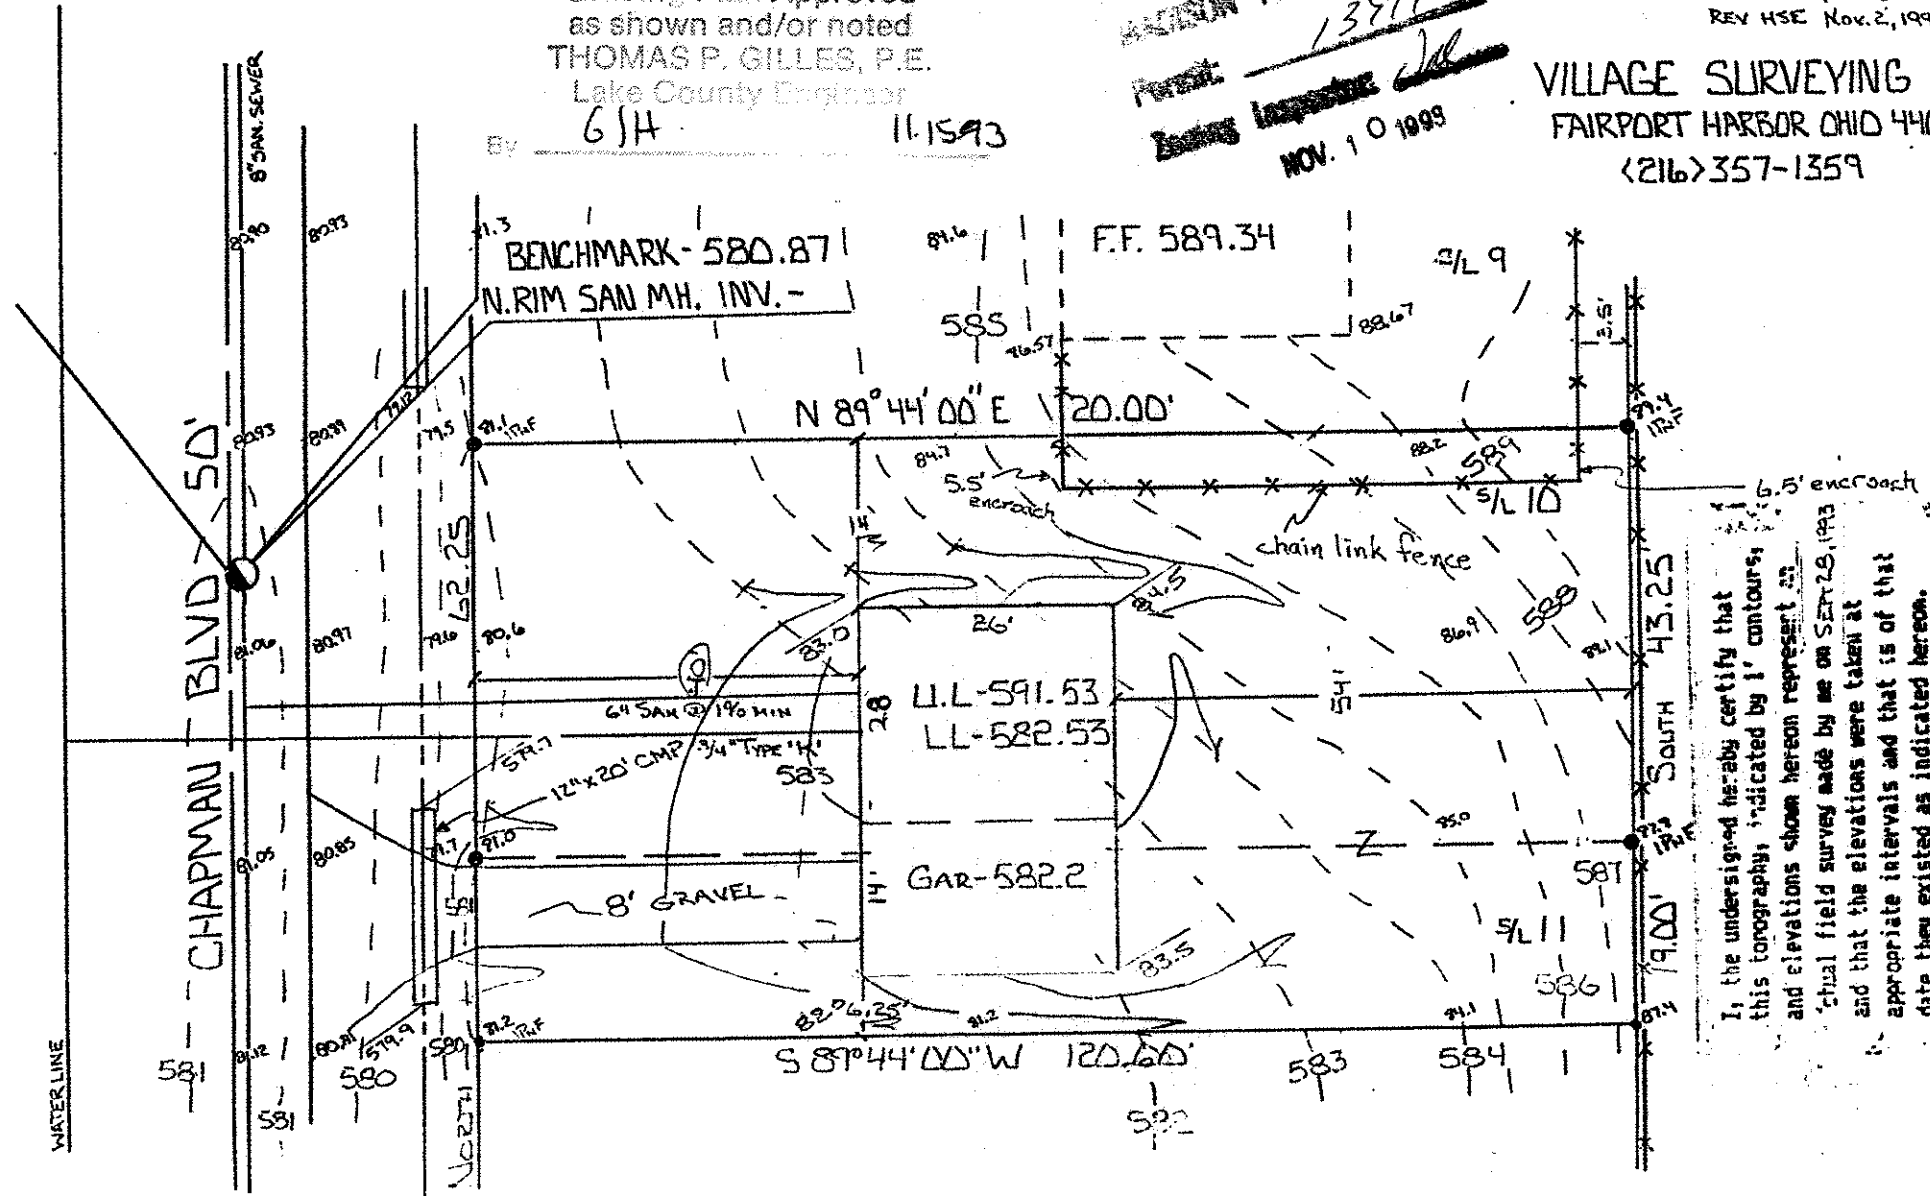

I, the undersigned hereby certify that
this topography, indicated by 1' contours,
and elevations shown hereon represent an
actual field survey made by me on SEP 25, 1993
and that the elevations were taken at
appropriate intervals and that is of that
date they existed as indicated hereon.

J. M. Coffman P.E.
No. 6357