


PERMIT # 14462
ROLLING INSPECTOR DW

S/L 18 PARKVIEW ALLOTMENT

5575 ORCHID DRIVE, MENTOR OHIO 216-257-4305

ASSUMED TOP OF IRON PIN AT

596.82

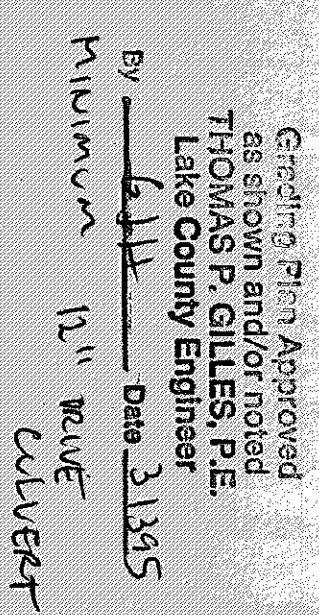

LEGEND

-
- (20' FEET)

[illegible]