



SITE PLAN FOR BILL BARBIS BEING % 26, BLOCK 12 OF THE PARKVIEW SUBD. IN THE VILLAGE OF MADISON, COUNTY OF LAKE, STATE OF OHIO.

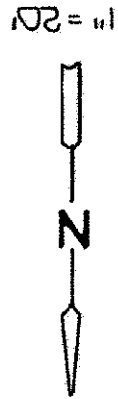

I, the undersigned hereby certify that this topography, indicated by 1' contours, and elevations shown hereon represent an actual field survey made by me on Jan. 7, 1991 and that the elevations were taken at appropriate intervals and that as of that date they existed as indicated hereon.

J. M. Coffman
Grading Plan Approved
COUNTY ENGINEER
Date 1/14/92

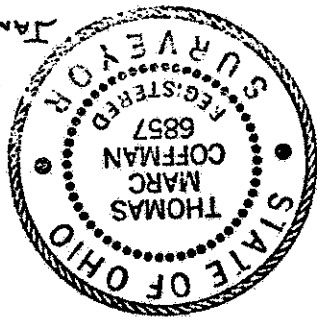

VILLAGE SURVEYING CO.
202 THIRD STREET FAIRPORT HARBOR OHIO 44077
72167 357-1359
JAN 10 1992

