


PLAT OF SURVEY

FOR THE SCHULTZ'S
BEING SUBLOT NO. 3, IN THE
CHIMNEY RIDGE SUBD. IN THE
TOWNSHIP OF MADISON, COUNTY
OF LAKE, STATE OF OHIO.
Vol. 323-186
Rouald E. Jr. & Susan D. Schultze

A.M. ANDERSON
Vol. 763-217

Grading Plan Approved
as shown and/or noted
by THOMAS P. GILLES, P.E.
Lake County Engineer
Date 2/17/90

Erving Baumit
#12850

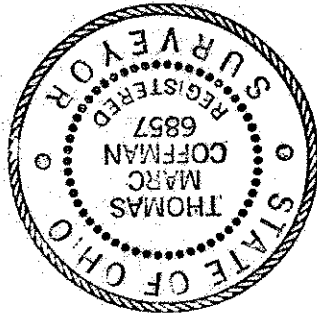

I, the undersigned hereby certify that
this topography, indicated by 1' contours,
and elevations shown herein represent an
actual field survey made by me on 9-7-90
and that the elevations were taken at
appropriate intervals and that as of that
date they existed as indicated herein.

357-1359

