




The topography, indicated by 1' contours, and elevations shown hereon represent an actual field survey made by me on the 12th day of December, 1995. The elevations were taken at appropriate intervals and as of the above date they existed as indicated hereon.
Steven N. Roessler
1/22/96
No. 7070

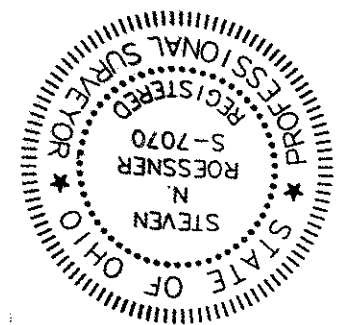

CHIMNEY RIDGE DRIVE-80'

(A) $\Delta = 04'28.49"$
 $R = 776.22'$
 $T = 30.36'$
 $L = 60.71'$
(B) $\Delta = 04'43.26"$
 $R = 776.22'$
 $T = 32.02'$
 $L = 64.00'$

Benchmark
Rim 623.70
Inv. 610.00 S
Pump
Station
Main

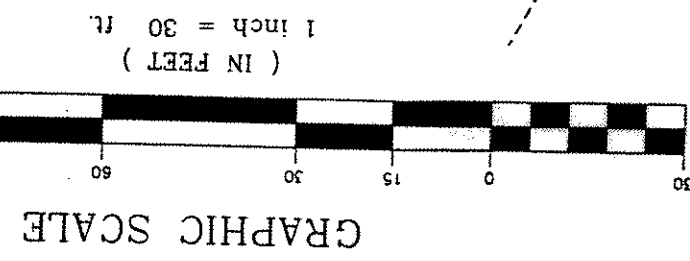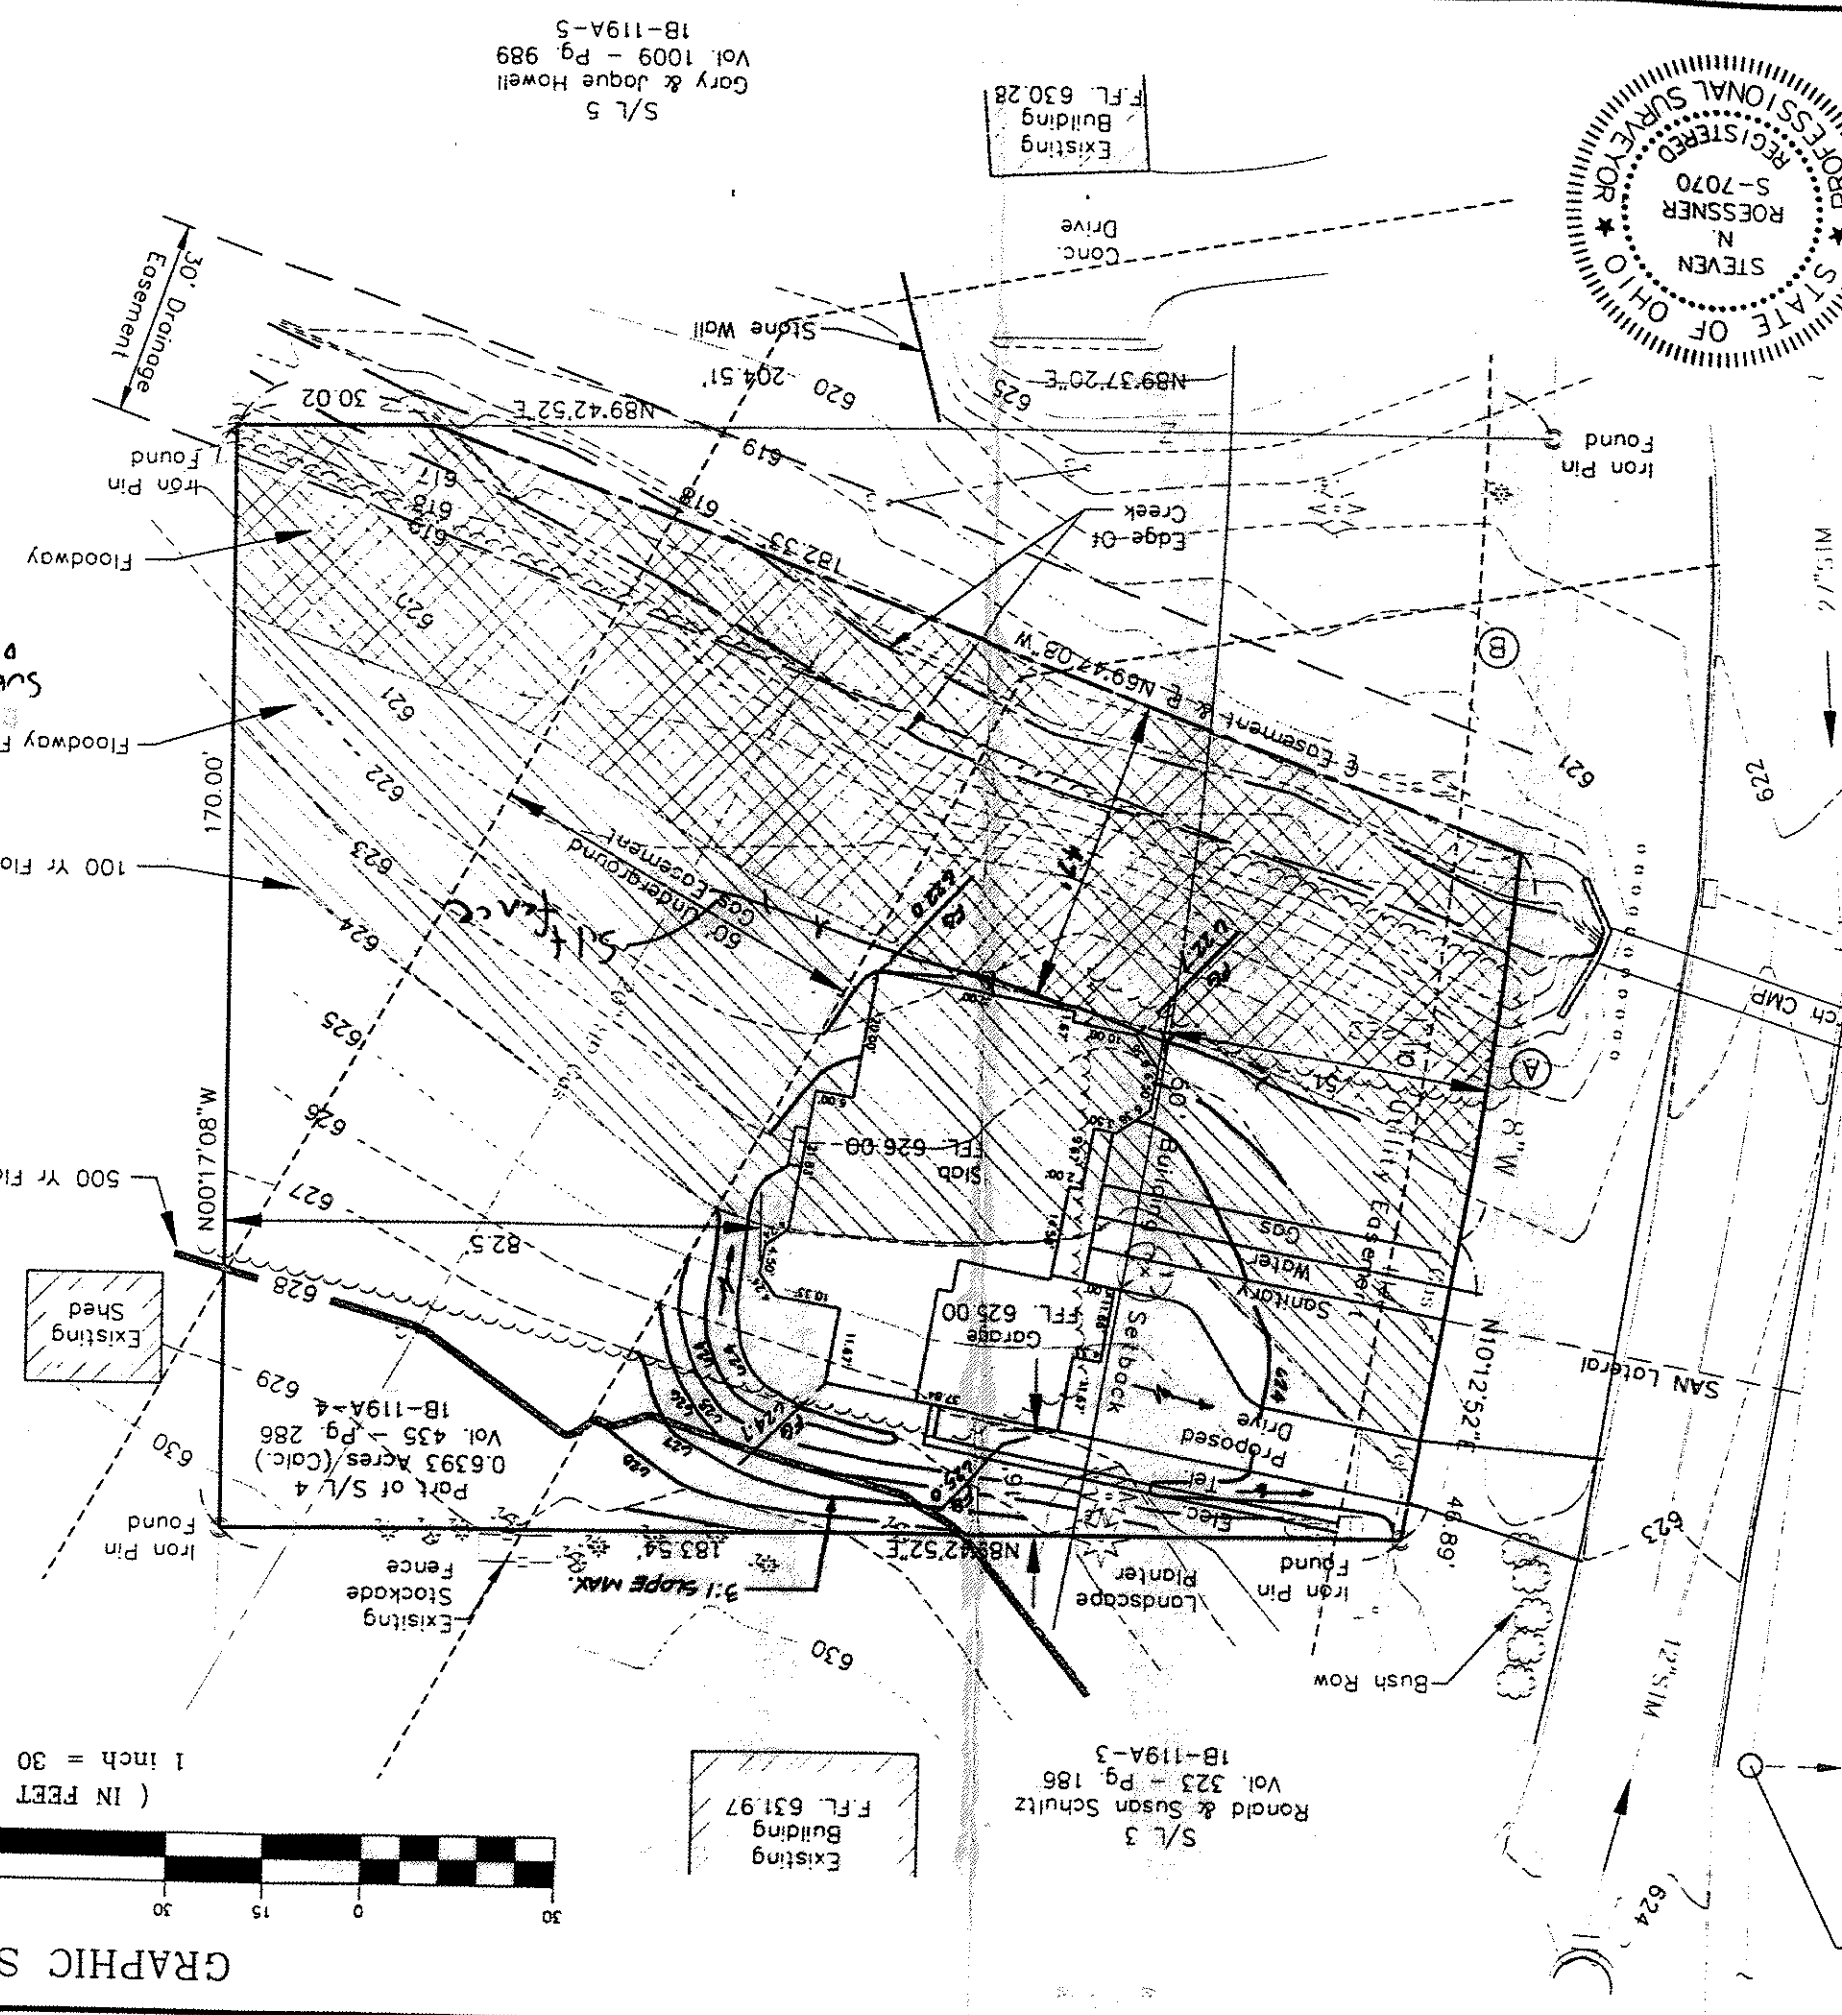

APPROVED
MADISON TOWNSHIP ZONING
FEB 1 1996
1/22/96
ZONING INSPECTOR
LEGEND
Pine & Size
Tree & Size
Telephone Soc Box
Gas Marker
Telephone Marker
Found
Iron Pin/Pipe
Found

1/1
SHEET NO.
Part of S/L 4 - Chimney Ridge Subd.
Madison Township - Lake County, Ohio
Site Plan
Foresight Engineering Group
Engineers & Surveyors
200 2nd Street, Suite 100
Cincinnati, Ohio 45202
DATE: Jan. 17, 1998
SCALE: Horiz. 1" = 30'
VERT. NONE
FEE NAME:
F. YMC19501V (OPR)
200 2nd Street, Suite 100
Cincinnati, Ohio 45202