

CURVE DATA

RADIUS - 776.22

ARC - 17.56

CHORD - 17.56



BEARING - N 82° 14' 48" E

SITE PLAN

FOR

COMRES BLDGS INC.

BEING S/L 5, IN THE CHIMNEY RIDGE SUBD. IN THE TOWNSHIP OF MADISON, IN THE COUNTY OF LAKE, STATE OF OHIO.

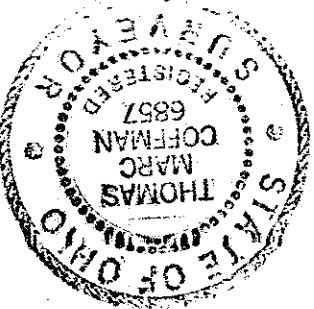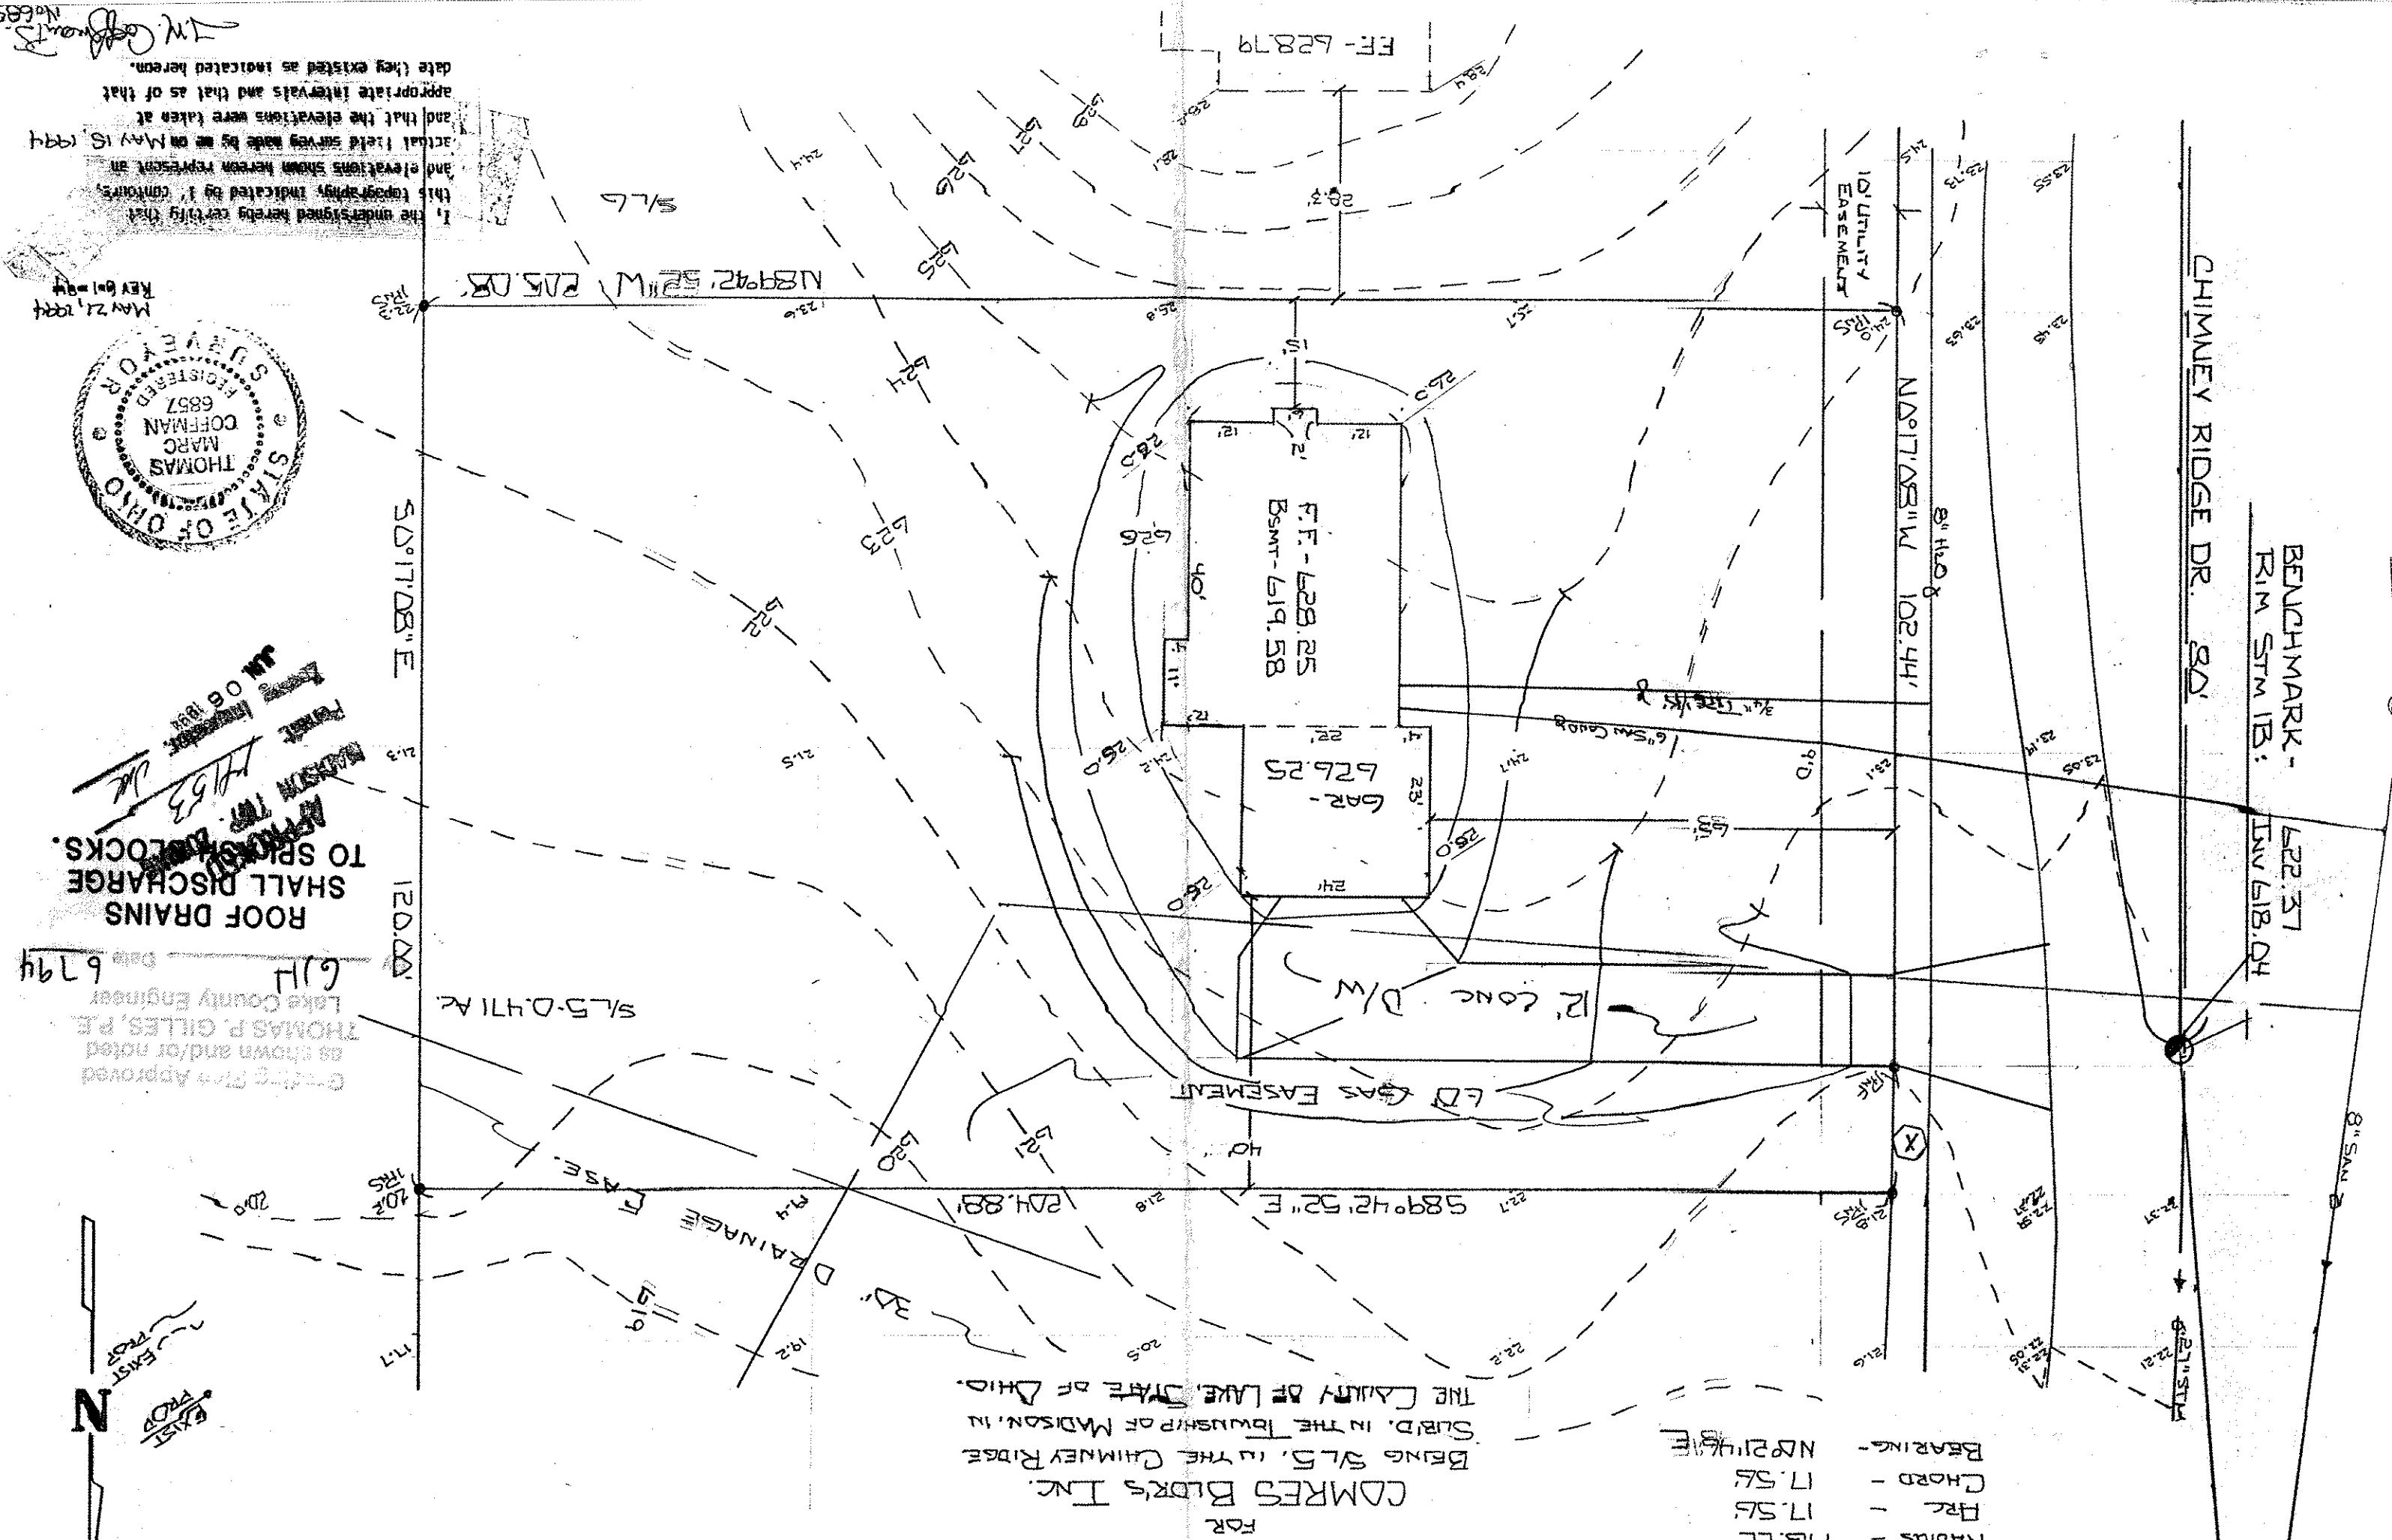

MAY 21, 1994

I, the undersigned hereby certify that this topography, indicated by contours, and elevations shown hereon represent an actual field survey made by me on May 18, 1994, and that the elevations were taken at appropriate intervals and that as of that date they existed as indicated hereon.

CRACKING FROM APPROVED AS SHOWN AND/OR NOTED THOMAS P. GILLES, P.E. Lake County Engineer
 6/14
 ROOF DRAINS TO SPILL BLOCKS.
 APPROVED FOR
 6/14
 DATE 6/14/94