


REG. SURVEYOR NO. 5244

DESIGN CERTIFICATION  
THIS PLAT WAS PREPARED BY ME AND I HEREBY CERTIFY THAT THE CIRCLED GRADES AND IS CORRECT TO THE BEST OF MY KNOWLEDGE AND BELIEF.  
FIELD ON  
SURVEY IS CORRECT TO THE BEST OF MY KNOWLEDGE AND BELIEF.

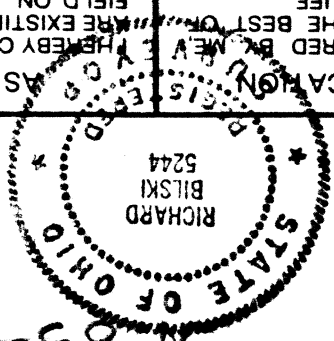

**COLPETZER • WOODS**  
CONSULTANTS, INC.  
9470 MENTOR AVENUE • MENTOR, OHIO 44060 • (216) 357-7569

DATE 2.25.86  
SCALE 1"=20'  
DRWN BY RJB  
CHKD BY RJB  
JOB NO. 87-251  
PG 18

SITE PLAN for KEN TOLUL  
of S/L 30 IN THE CHIMNEY RIDGE SUBD.  
MADISON TWP LAKE COUNTY OHIO

