

SITE PLAN

FOR

70100843
120423

JOE KOWSIOWSKI
BEING SUELOY No. 24 OF THE
CHIMNEY RIDGE SUBD. TOWNSHIP
OF MADISON, LAKE COUNTY, OHIO

Grading Plan Approved
as shown and/or noted
THOMAS P. GILLES, P.E.
Lake County Engineer

2-21-89

EXIST.
AREA
EXIST.
AREA


PAUL L. GATES
Vol. 315-399

S/L 23
S/L 24
1 Δ. 489

PAUL L. GATES
Vol. 315-401

RIDGE MANDR NURSERY
Vol. 358-1053


MADISON COUNTY CLUB CO.
Vol. 753-422

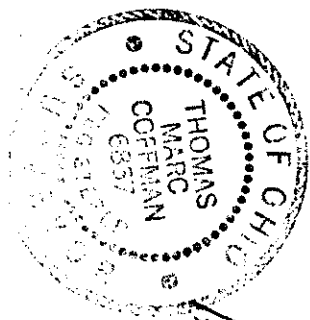

THIS PLAN WAS PREPARED BY ME AND IS
ACCURATE TO THE BEST OF MY KNOWLEDGE
AND BELIEF.

Thomas M. Coffman

VILLAGE SURVEYING CO.
202 THIRD ST. FAIRPORT HBR. OH 44017
216 (357-1359)

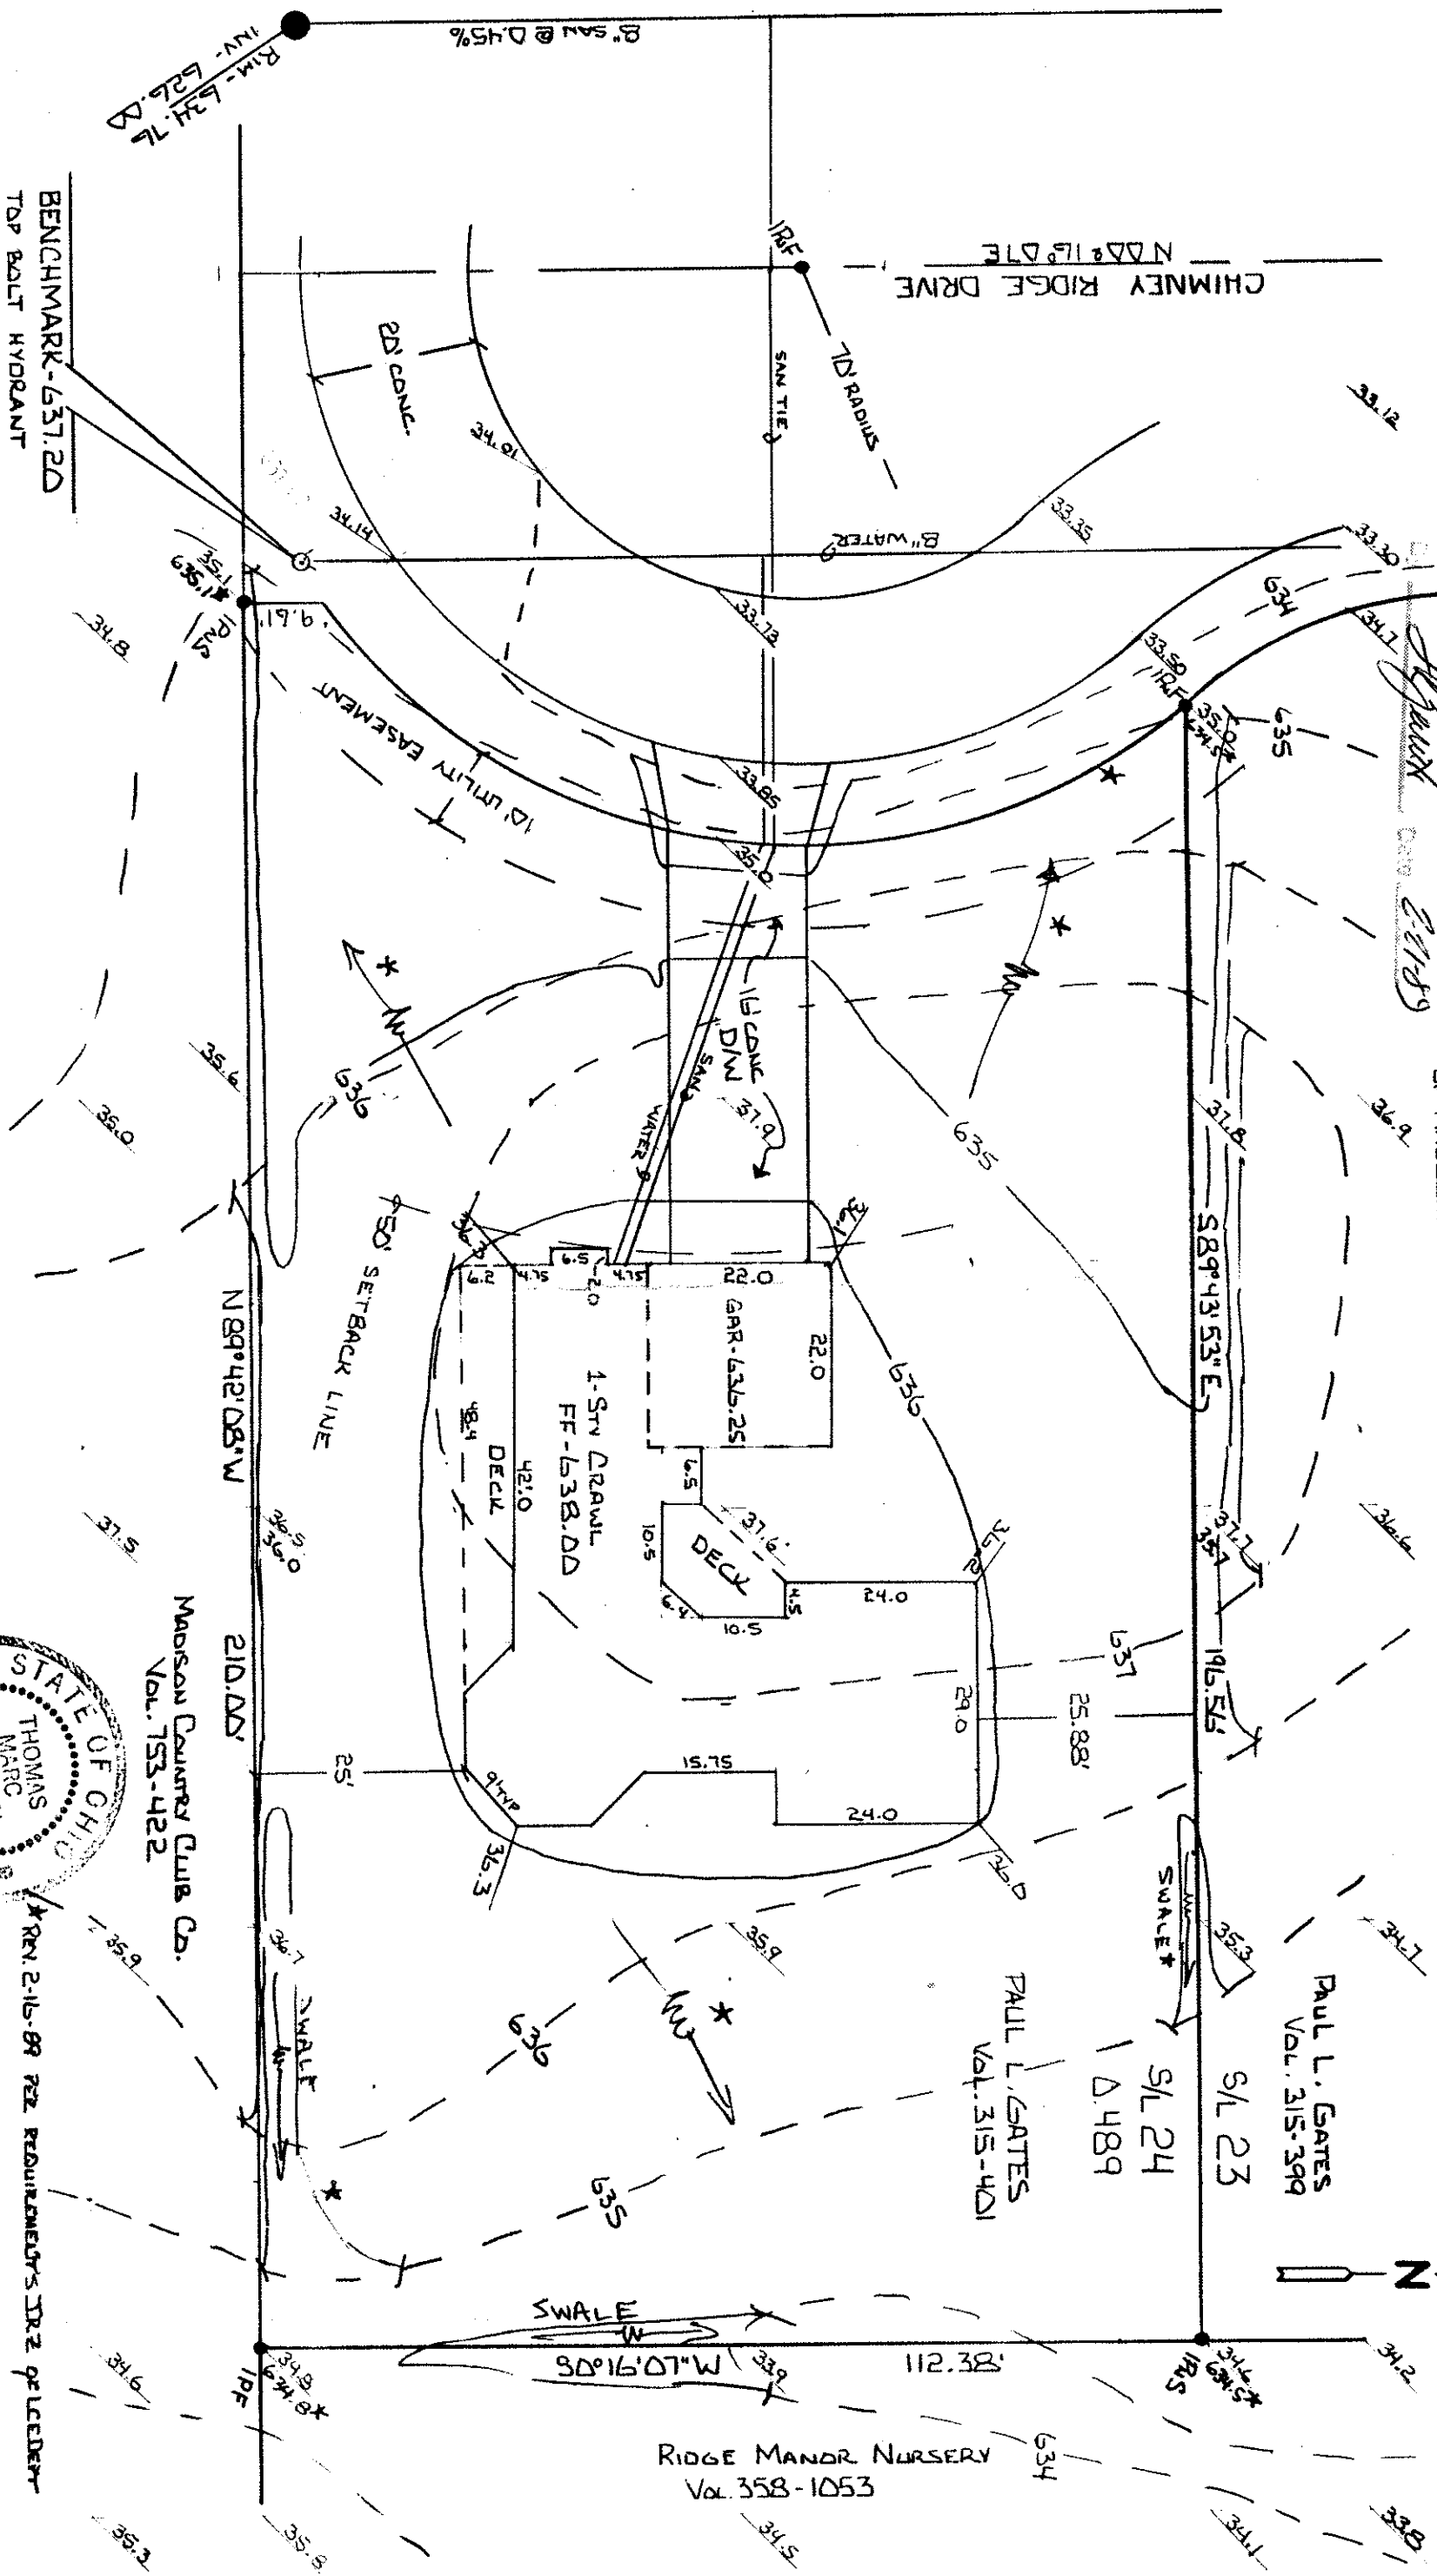

BENCHMARK-637.20
TOP BOLT HYDRANT