


• DENOTES IRON PIN

SITE PLAN FOR R. WELSH INC. LOT 12 TRACT 1 MADISON TWP. LAKE CO. O.

SCALE 1"=20 FT. 6 JUNE 1994

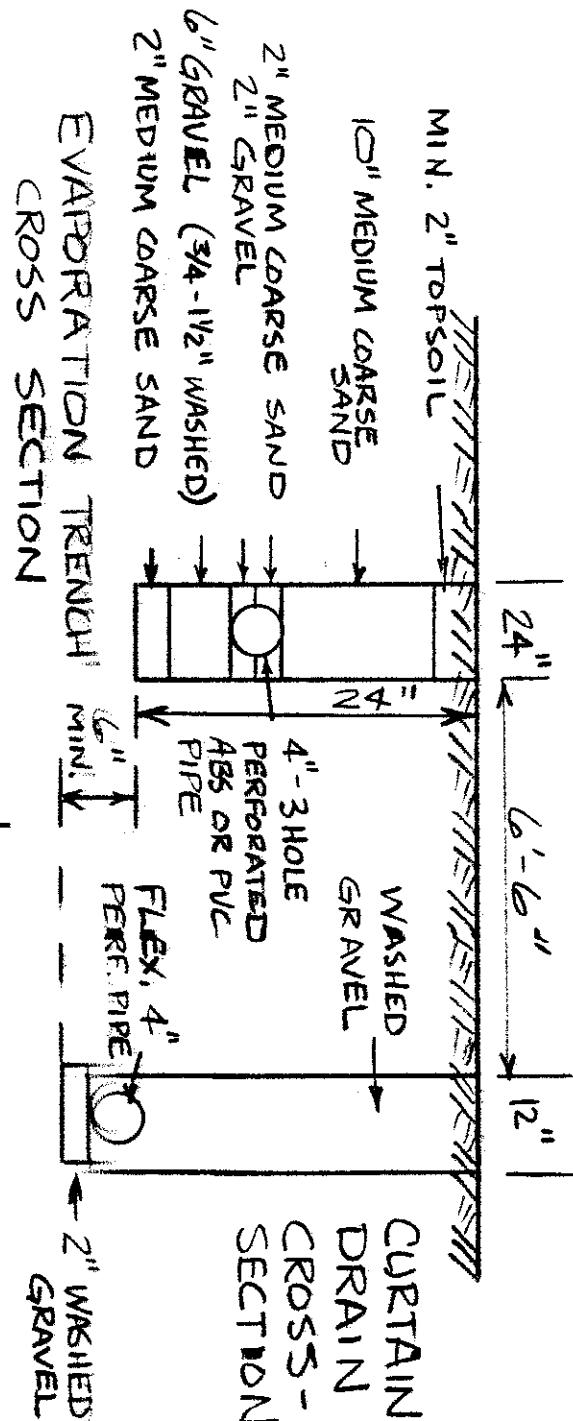

I. HEREBY CERTIFY THAT THE TOPOGRAPHY, SHOWN HEREON, REPRESENTS BY ONE FOOT CONTOUR INTERVALS, REPRESENTS AN ACTUAL FIELD TOPOGRAPHIC SURVEY MADE BY ME ON THE 4th DAY OF JUNE, 1994 AND THAT AS OF THAT DATE THE TOPOGRAPHY EXISTED AS SHOWN HEREON.

G. GEOTHERMAL INC.
V. 458 - P. 607

VACANT LOT

PROPOSED 12" CMP DRIVE PIPE 30 FT. L.
DR. AREA = 1 1/2 AC.

PROPOSED DRIVEWAY

WATER CONNECTION

60' S.B.

PROPOSED 3 BDRM. 2-1/2 STY. ON SLAB F.F. EL. 606.30'


744' R.Y.

WOODED

RONALD WELSH INC.

2.06 ACRES

EVAPOTRANSPIRATION SYSTEM PROFILE

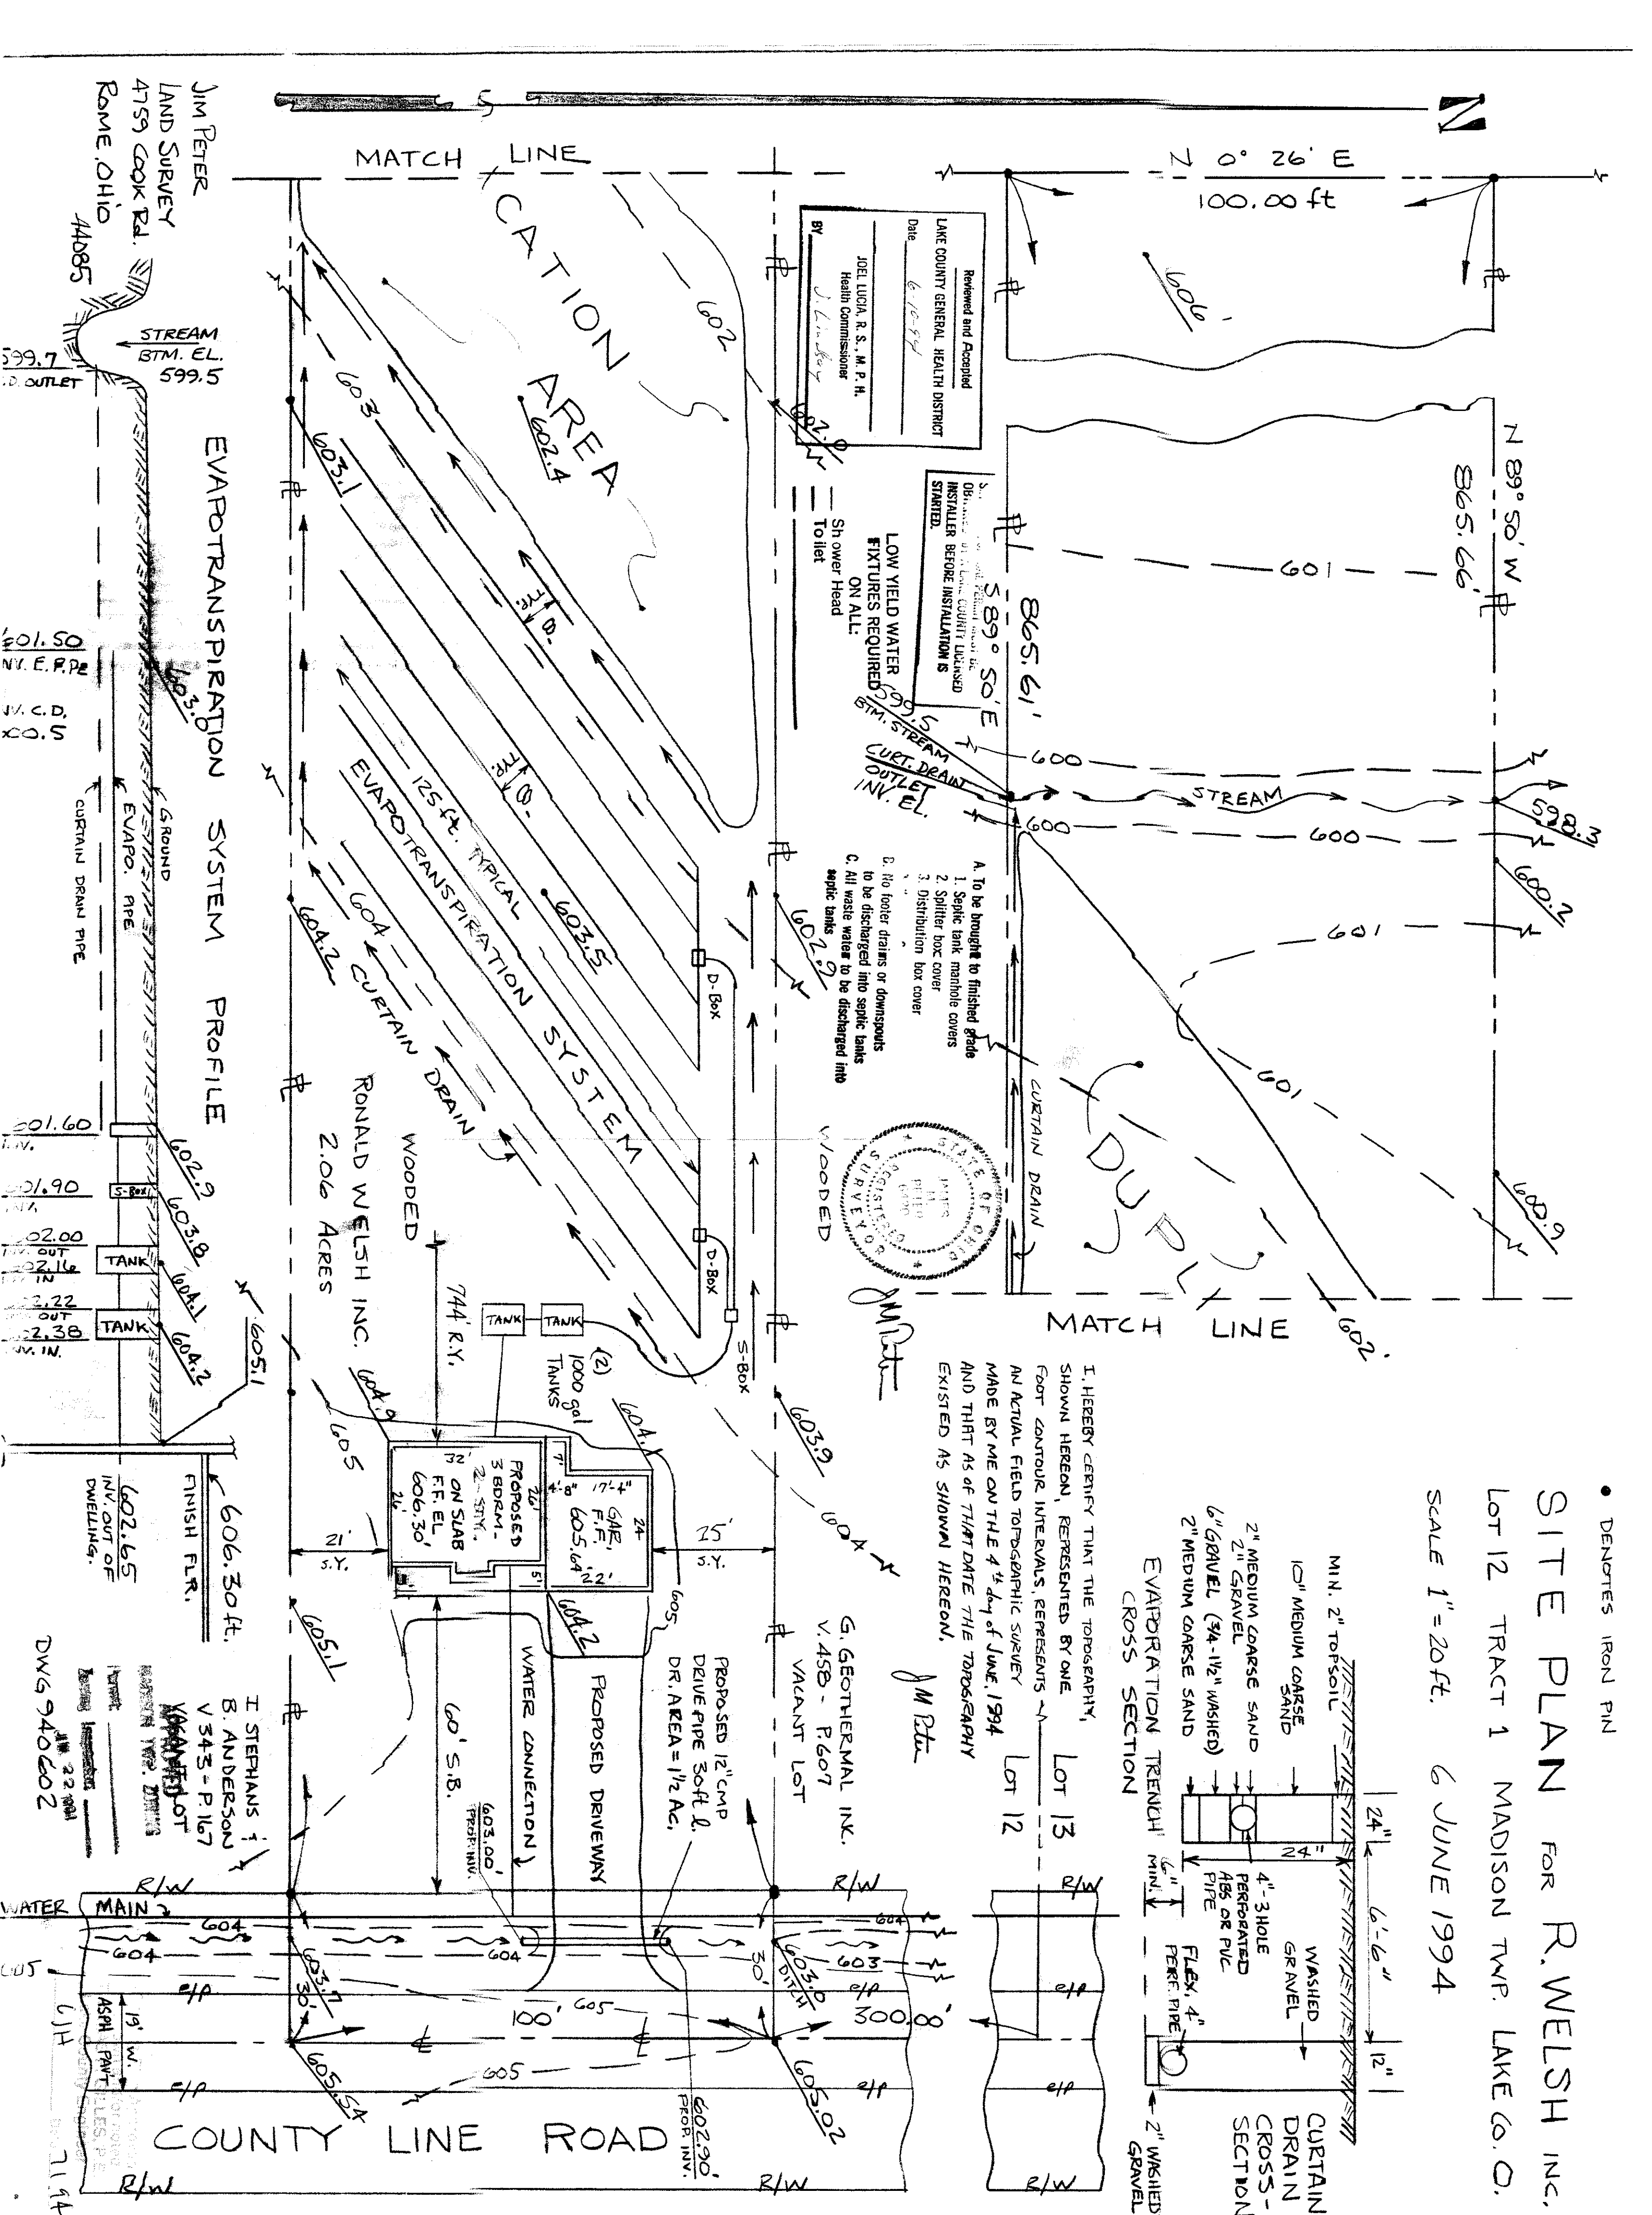

Reviewed and Accepted
LAKE COUNTY GENERAL HEALTH DISTRICT
Date: 6-10-94
JOEL LUCIA, R.S., M.P.H.
Health Commissioner
BY: J. Lucia

Obtained from Lake County Health District
INSTALLER BEFORE INSTALLATION IS
STARTED.

LOW YIELD WATER
FIXTURES REQUIRED
ON ALL:
Shower Head
Toilet

- A. To be brought to finished grade
- 1. Septic tank manhole covers
- 2. Splitter box cover
- 3. Distribution box cover
- B. No footer drains or downspouts to be discharged into septic tanks
- C. All waste water to be discharged into septic tanks

