





JAMES E. AND DONNA A. SABO
VOL. 70, PG. 1317

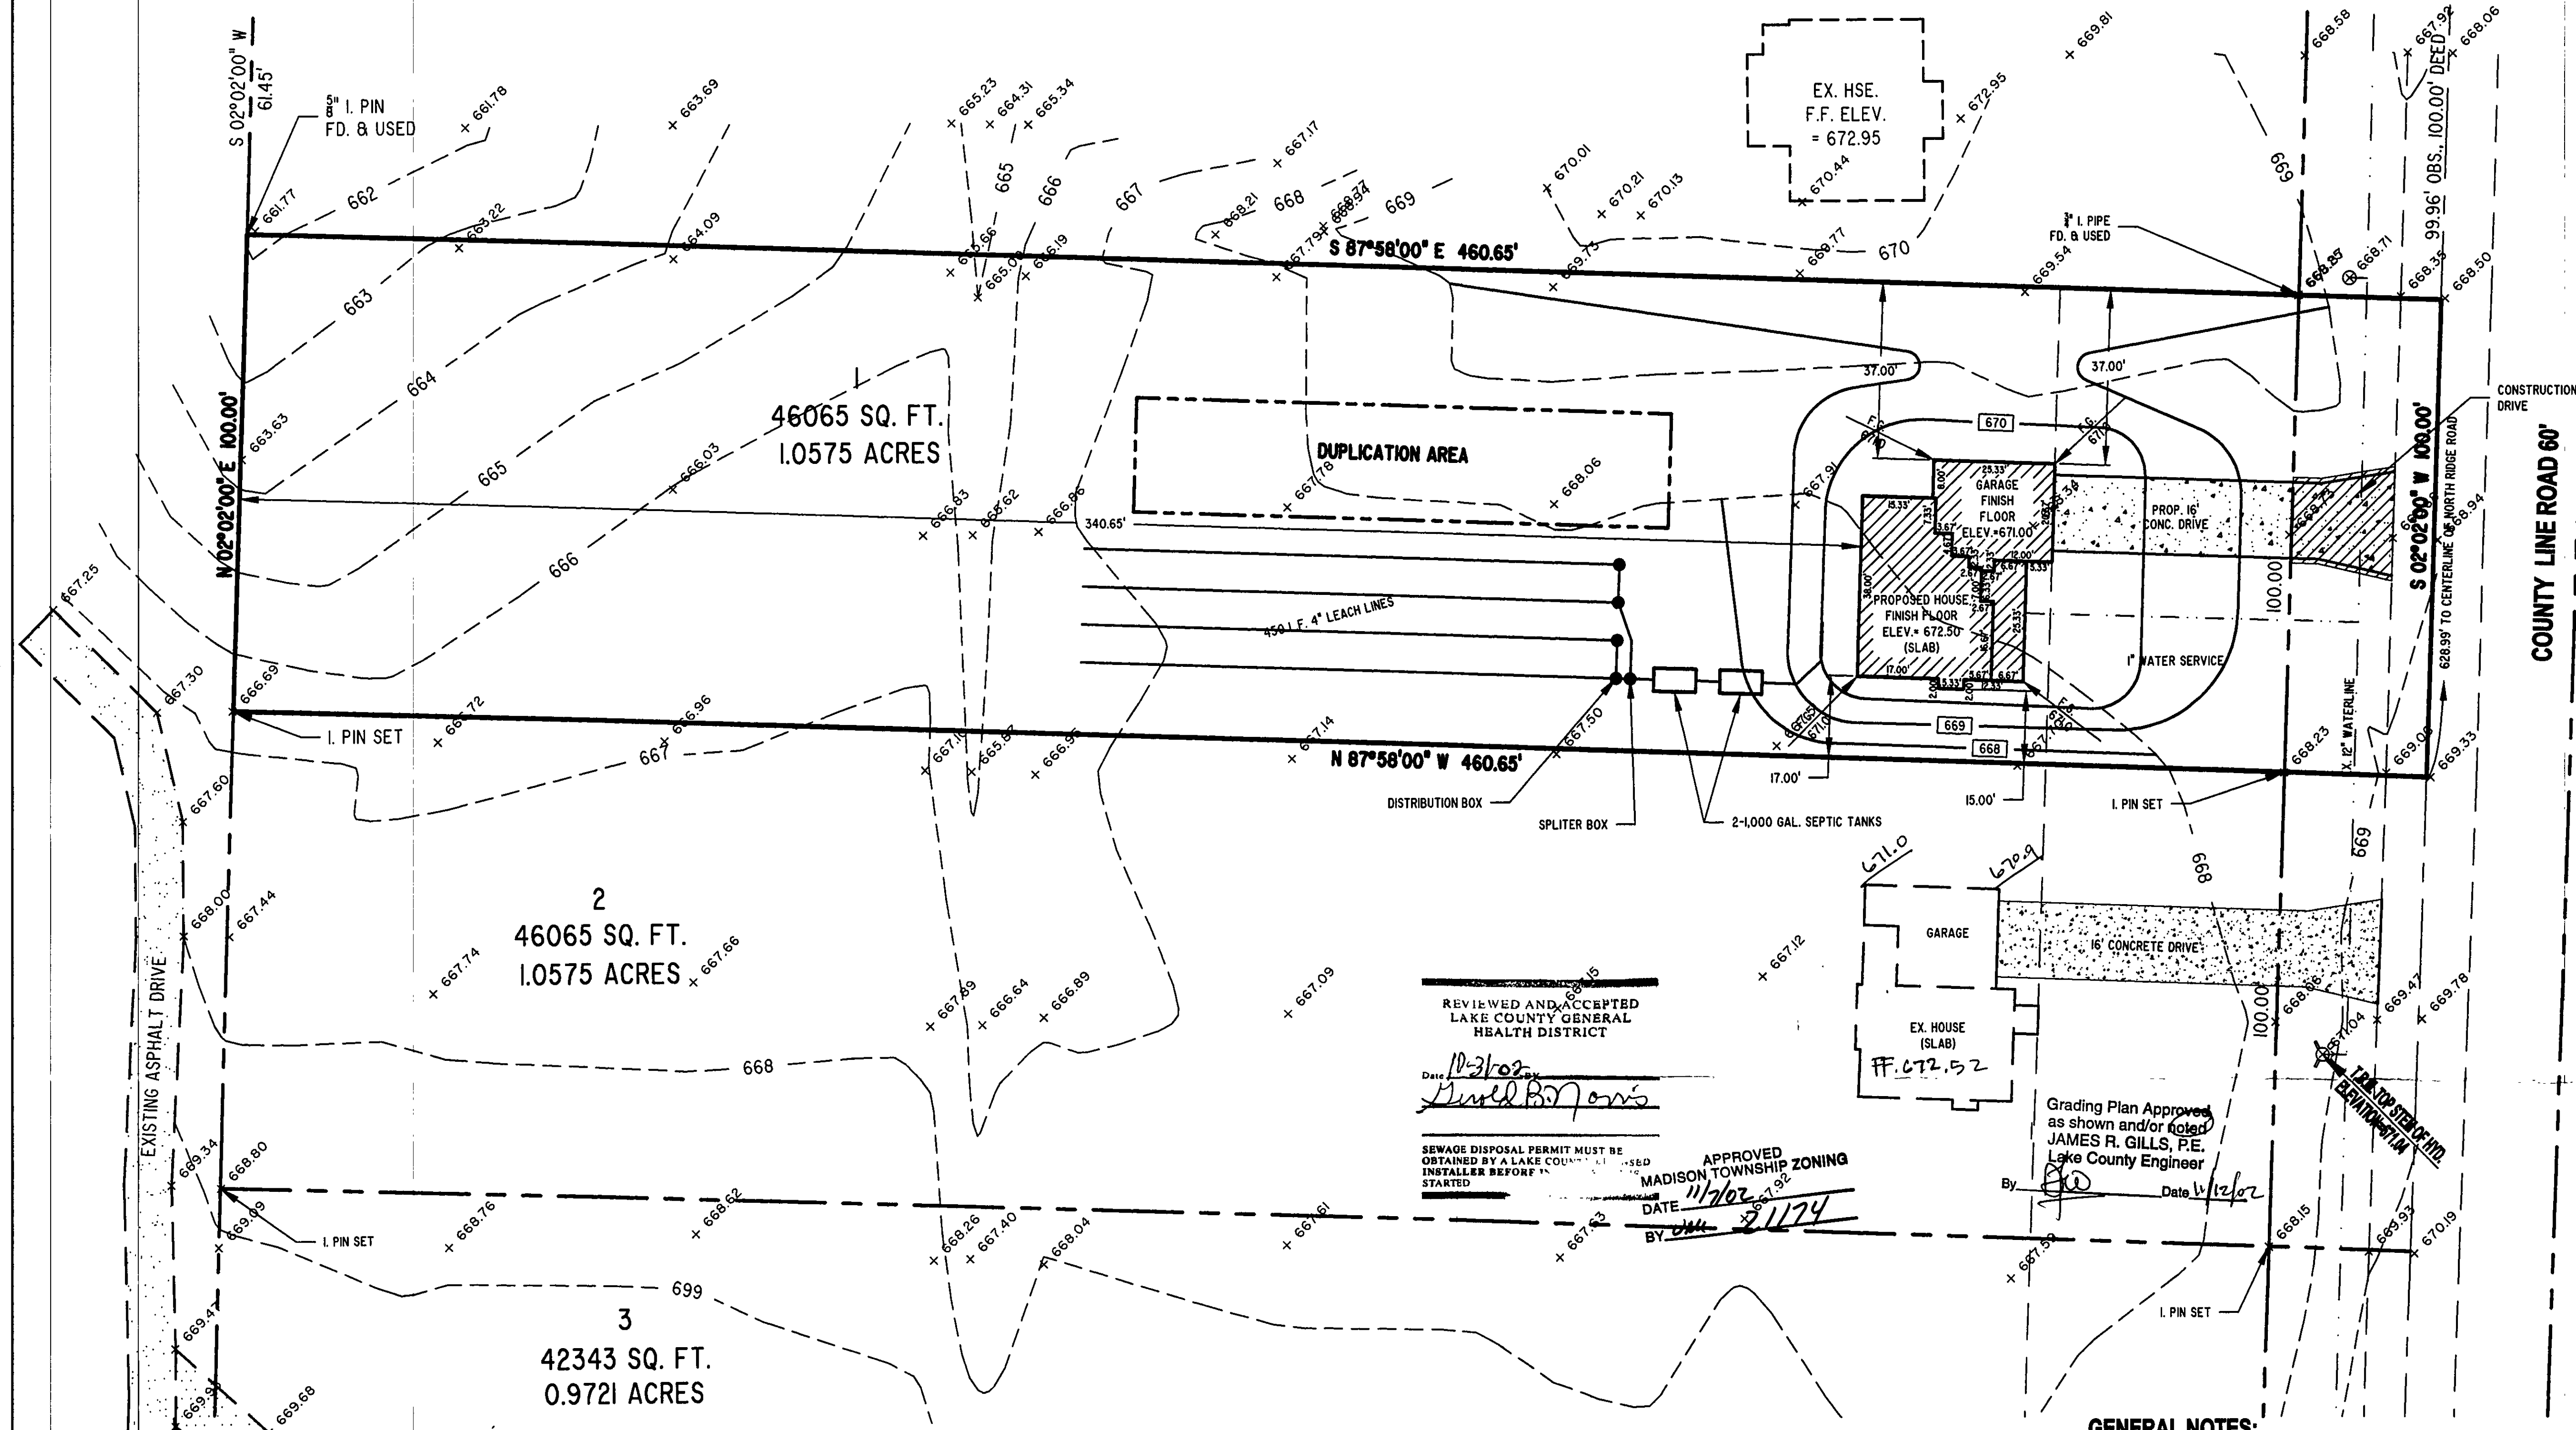

* THE STANDARD TRENCH IS 24 INCHES
HOWEVER THE TRENCH CAN VARY BETWEEN
18 INCHES TO 30 INCHES DEEP IF NECESSARY.
GRAVEL REQUIREMENT IS STANDARD
AMOUNT OF BACKFILL WOULD VARY.

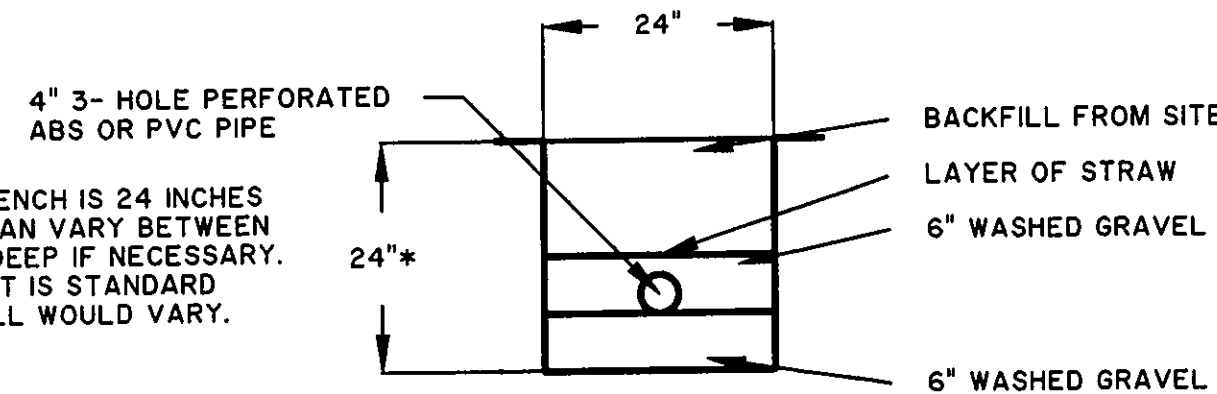

TYPICAL LEACHING TRENCH CROSS SECTION

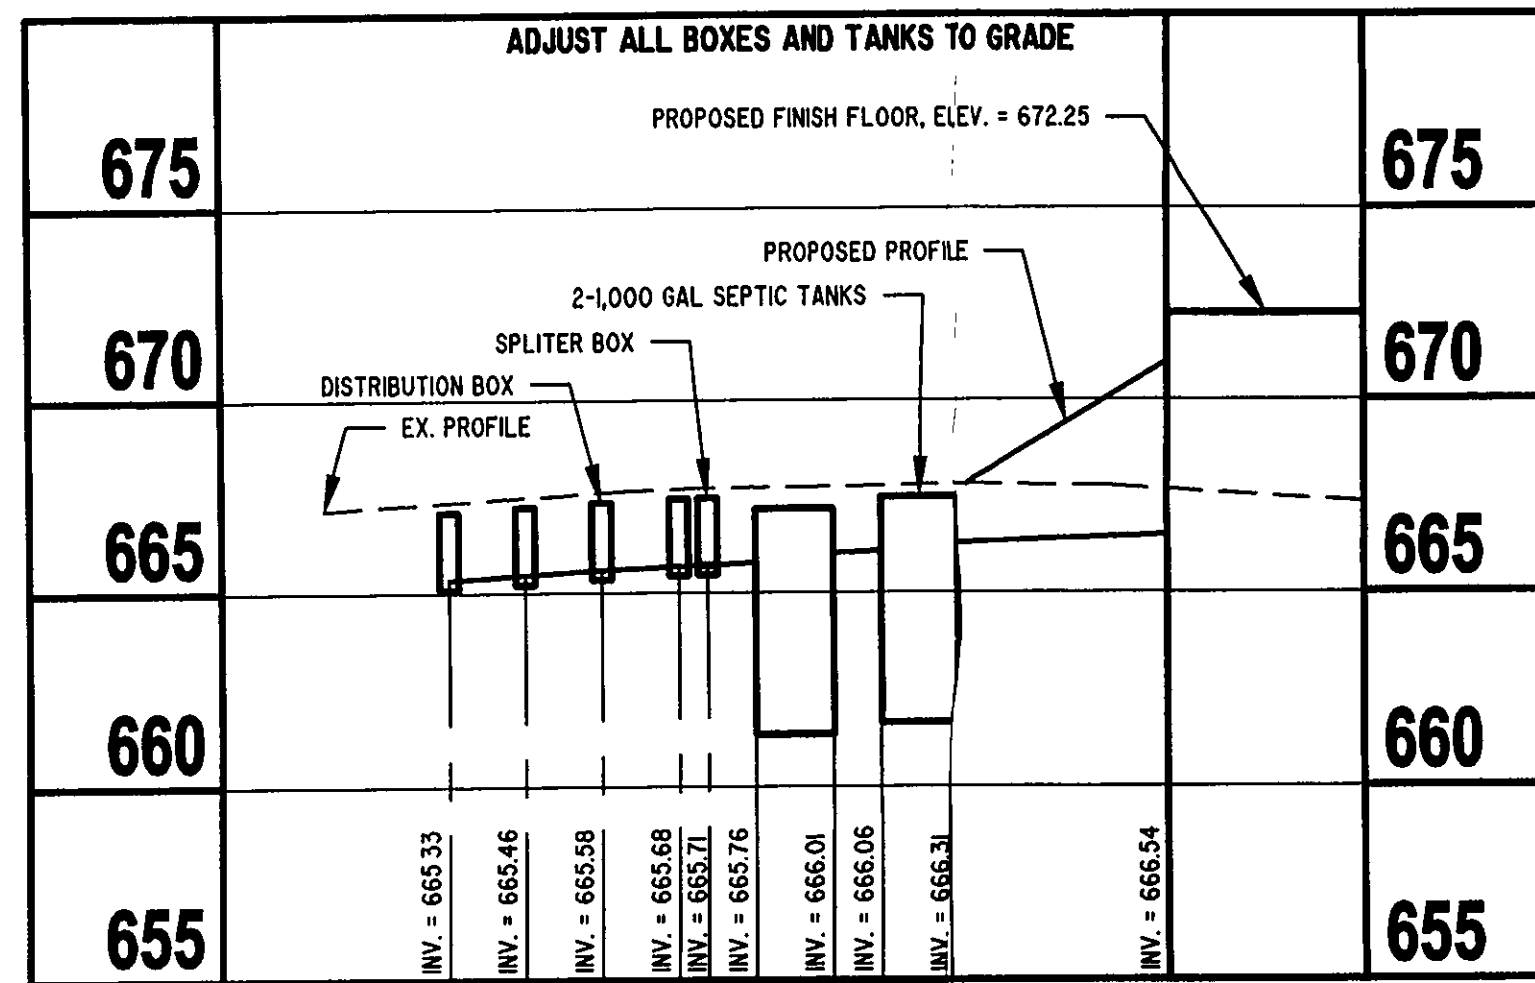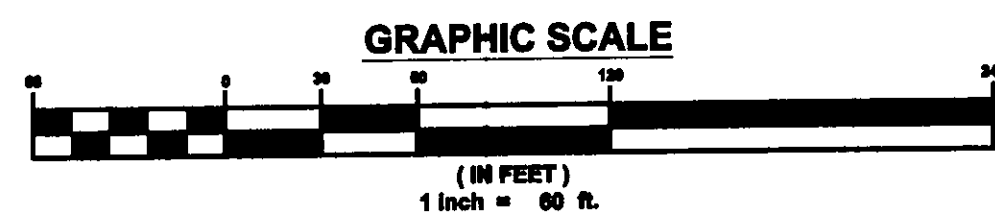

HYDRAULIC PROFILE
SCALE: 1" = 20' HORIZ., 1" = 5' VERT.

LAKE COUNTY DEPARTMENT OF UTILITIES
No L.C.D.U. SANITARY SEWERS AVAILABLE
YES L.C.D.U. WATERLINE AVAILABLE

DAVID W. NOVAK, P.S. No. 7507
DATE 11-1-02

GENERAL NOTES:

1. BENCHMARK - TOP STEM OF EXISTING FIRE HYDRANT IN FRONT OF SUBLOT No. 2, ELEVATION = 671.04.
2. DRIVEWAY APRON TO BE 6" THICK CONCRETE.
3. ALL DOWNSPOUTS TO BE OUTLETED TO SPLASH BLOCKS.
4. CONTRACTOR RESPONSIBLE FOR CONTACTING THE OHIO UTILITY PROTECTION SERVICE (1.800.382.2764) AND ALL UTILITY COMPANIES A MINIMUM OF 48 HOURS PRIOR TO CONSTRUCTION.
5. THE LOCATION BOTH HORIZONTAL AND VERTICAL OF EXISTING UNDERGROUND UTILITIES SHOWN HEREON, HAVE BEEN OBTAINED BY A DILIGENT AND COMPREHENSIVE SEARCH OF AVAILABLE RECORDS. VERIFICATION BY FIELD OBSERVATION HAS BEEN CONDUCTED WHERE PRACTICAL, HOWEVER, BARRINGTON CONSULTING GROUP, INC. DOES NOT GUARANTEE THE COMPLETENESS, NOR ACCURACY THEREOF.
6. CONTRACTOR SHALL VERIFY ELEVATIONS OF LATERAL INVERTS IN THE FIELD PRIOR TO FOUNDATION EXCAVATION.
7. EROSION AND SEDIMENT-CONTROL PRACTICES TO BE INSTALLED AS DESCRIBED IN THE RAIN WATER LAND DEVELOPMENT MANUAL AS DIRECTED BY THE LAKE COUNTY SOIL AND WATER CONSERVATION DISTRICT.
8. TEMPORARY SEEDING SHALL BE APPLIED ON ALL DISTURBED SOIL THAT WILL NOT BE REWORKED FOR WITHIN 30 DAYS. THESE IDLE AREAS TO BE SEEDDED WITHIN 7 DAYS.

CERTIFICATION:

"I THE UNDERSIGNED HEREBY CERTIFIES THAT THIS TOPOGRAPHY INDICATED BY 1 FOOT CONTOURS AND ELEVATION SHOWN HEREON REPRESENTS AN ACTUAL SURVEY MADE BY ME ON THE 31st DAY OF OCTOBER, 2001 AND THE ELEVATIONS WERE TAKEN AT AN APPROPRIATE INTERVAL AND AS OF THAT DAY THEY EXISTED AS INDICATED HEREON.

"I HEREBY CERTIFY THAT THIS PLAN WAS PREPARED BY ME AND IS CORRECT
TO THE BEST OF MY KNOWLEDGE AND BELIEF"

DAVID W. NOVAK, P.S. No. 7507

This project is exempt from
ESC Plan Review
Date 11/5/02
Lake SWCD



REVISIONS	BY

BARRINGTON
CONSULTING GROUP, INC.
38342 WESTERN PARKWAY, SUITE 10
WILLOUGHBY, OHIO 44094
PHONE 440.946.1761 FAX 440.918.0486

GENTRY HOMES, INC.
DAVID FRANZ
6358 CONLEY RD.
CONCORD, OH. 44077
440-639-2337

SITE PLAN
SUBLOT 1, COUNTY LINE ROAD
MADISON, OHIO 44057
GENTRY HOMES, INC.

OCTOBER 21, 2002
SCALE 1" = 20'
JOB NO. 01123-1
SHEET 111

OF SHEETS