



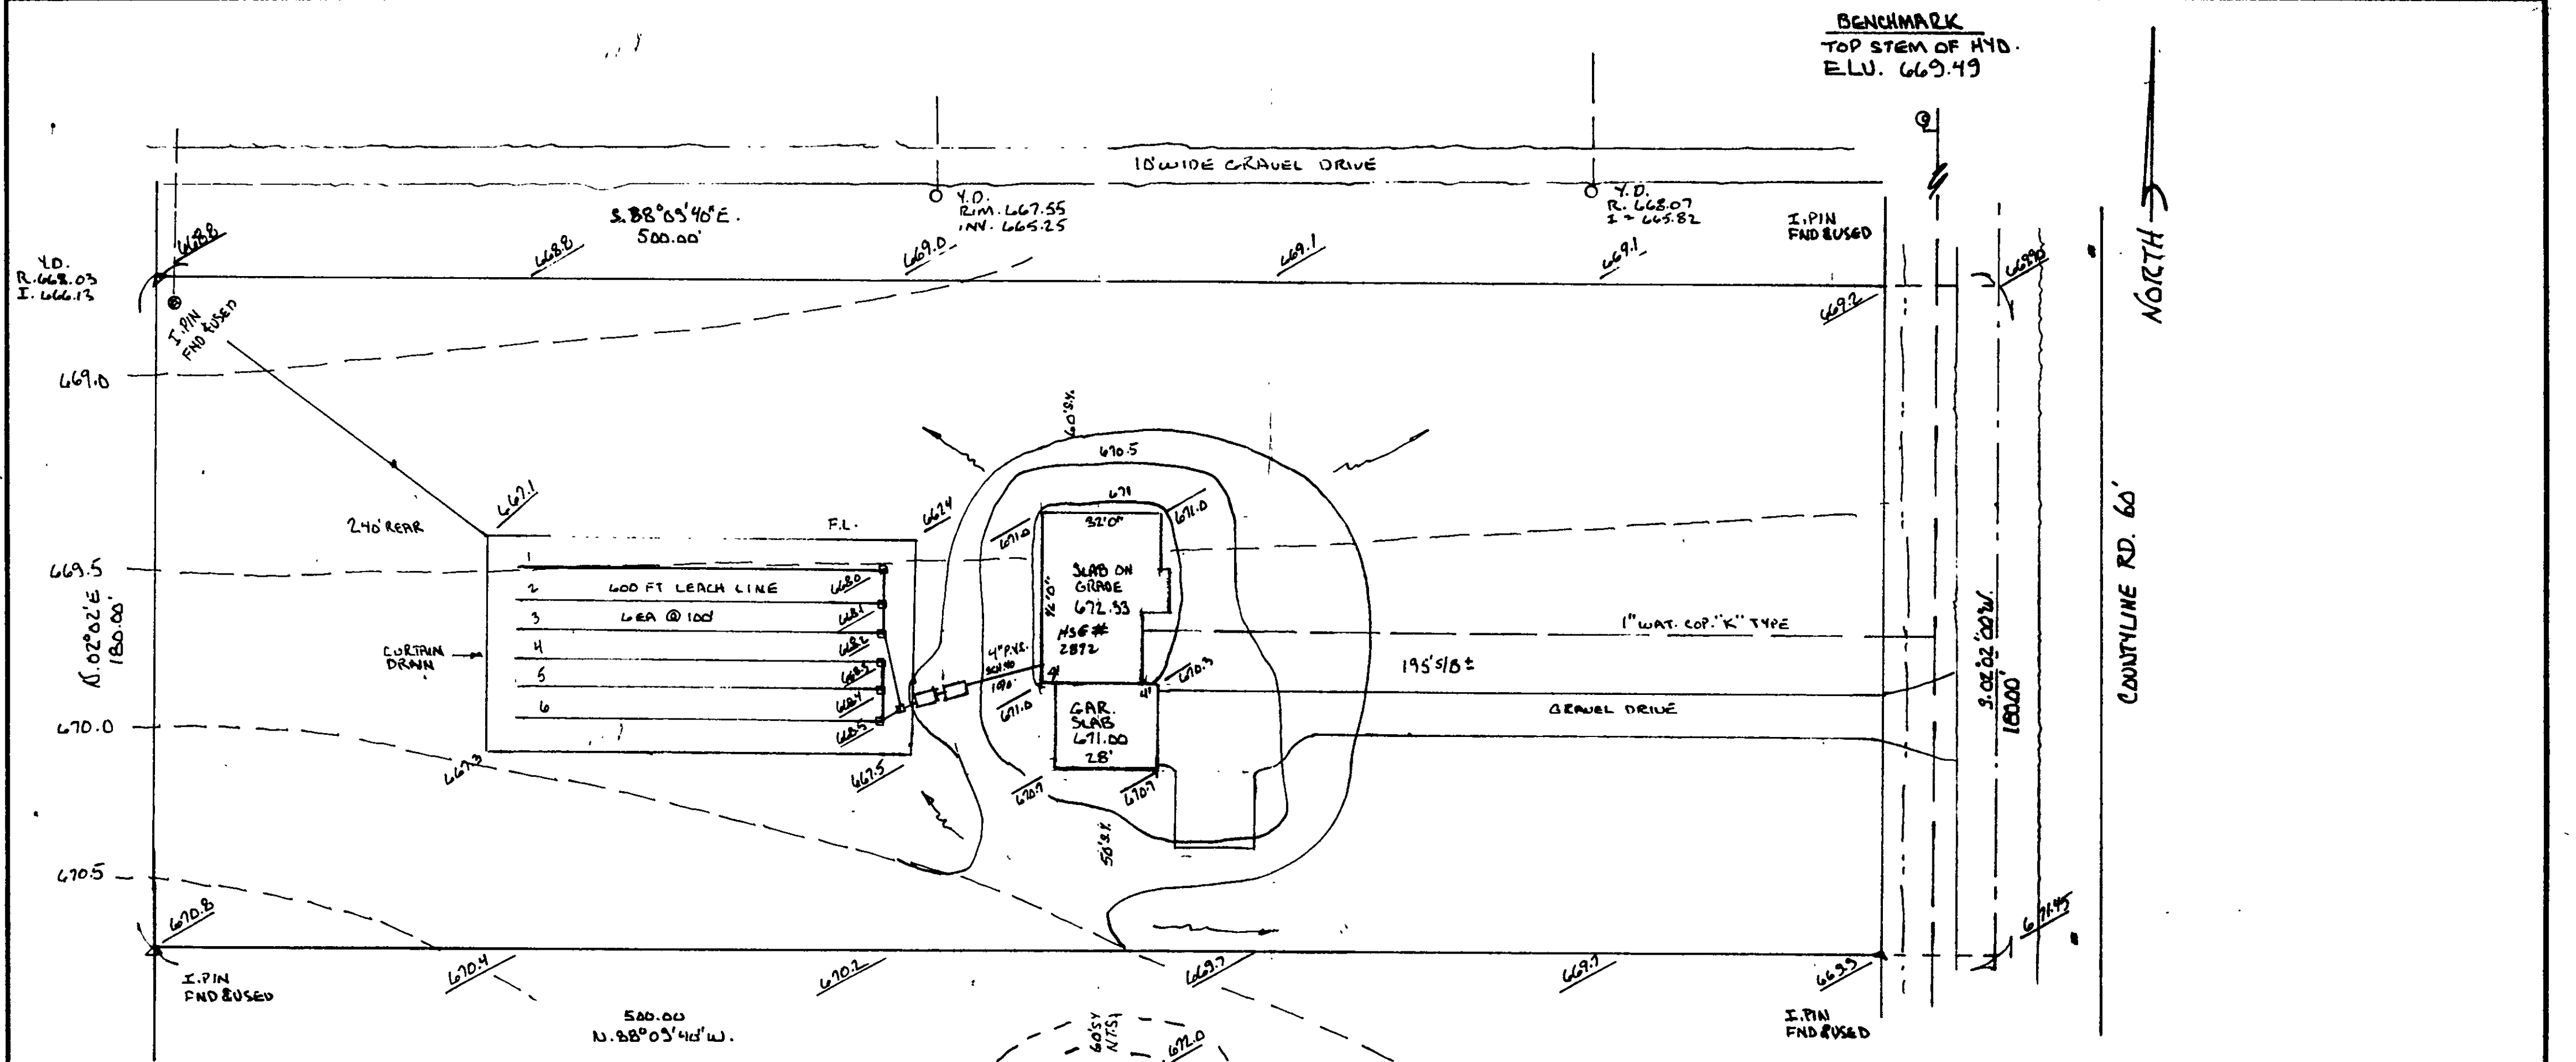



REVIEWED AND ACCEPTED
LAKE COUNTY GENERAL
HEALTH DISTRICT

Date 6/17/98 By De Lal
has trenches 18" deep

SEWAGE DISPOSAL PERMIT MUST BE
OBTAINED BY A LAKE COUNTY LICENSED
INSTALLER BEFORE INSTALLATION IS
STARTED

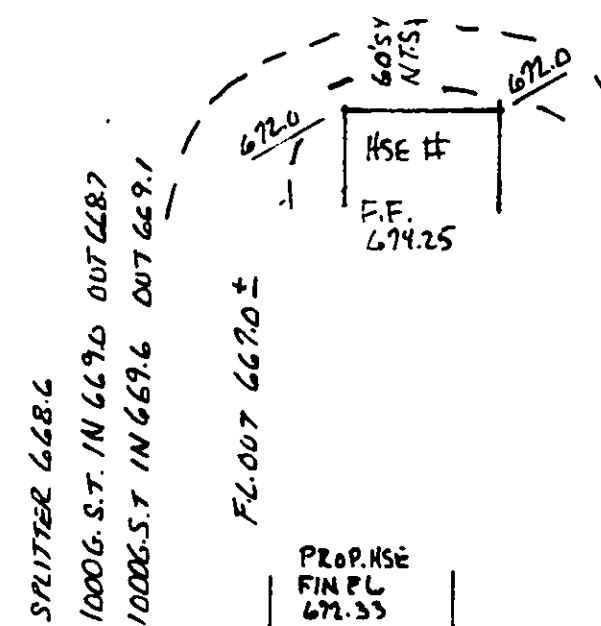

PROFILE HOR. 1" = 30'
VER. 1" = 5'

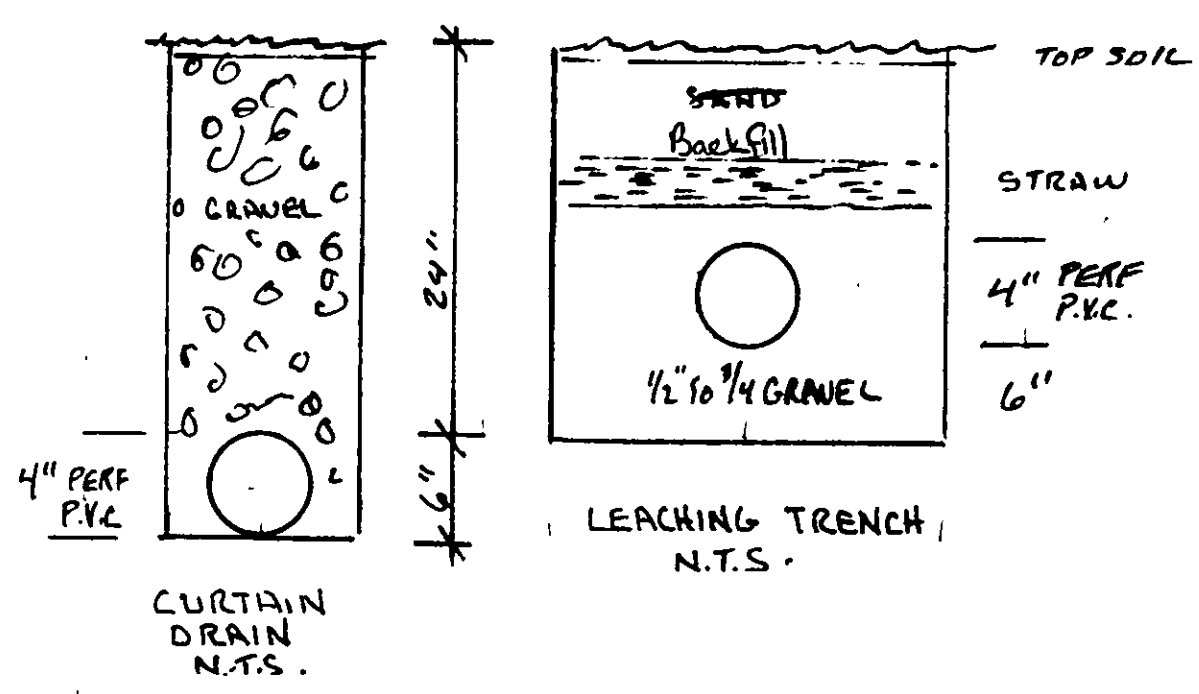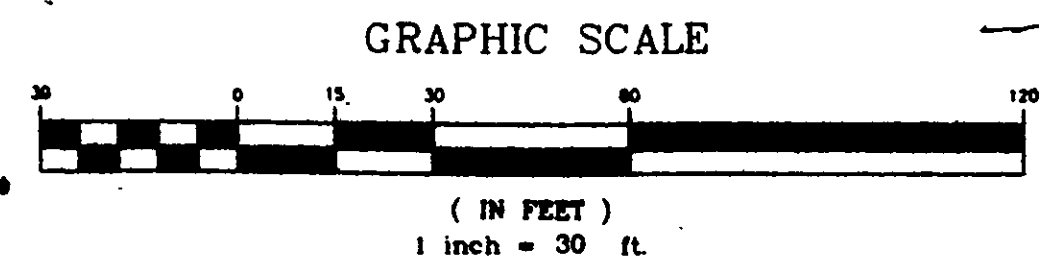

I CERTIFY THAT THIS PLAN
WAS PREPARED BY ME AND
IS CORRECT TO THE BEST OF
MY KNOWLEDGE AND BELIEF

John C. Skonieczny
REG. SURVEYOR #6356


JOHN C. SKONIECZNY
7739 VIEWMOUNT DR.
PAINESVILLE, OHIO 44077
PH. 352-7742

DESIGN CERTIFICATION

"I, THE UNDERSIGNED, HEREBY CERTIFY THAT THIS
DRAWING WAS PREPARED BY ME OR UNDER MY
SUPERVISION AND TO THE BEST OF MY KNOWLEDGE
AND BELIEF IT COMPLIES WITH ALL CITY, COUNTY
AND STATE REQUIREMENTS AND THAT THE
DRAWING IS A TRUE AND CORRECT REPRESENTATION
OF THE WORK DONE BY ME OR UNDER MY
SUPERVISION."

I, John C. Skonieczny
REG. NO. 6356

Grading Plan Approved
as shown and/or not
THOMAS P. GILLESPIE
Lake County Engineer

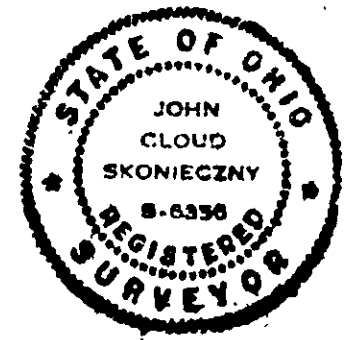

By GJH Date 7-13-98

APPROVED
MADISON TOWNSHIP ZONING
DATE 7/1/98
BY 15854

SITE PLAN FOR: LOUIS PIRC		P.O. Box 1 MADISON OHIO 44057
SCALE: 1" = 30'	APPROVED BY:	DRAWN BY J.C.S.
DATE: APR 9-98		REVISED
AS RECORDED IN VOL. 577-1085 L.C.R.D.		
TOWNSHIP OF MADISON COUNTY OF LAKE		STATE OF OHIO
JOB# 98-2583		DRAWING NUMBER 98-1660

2 WORKING DAYS
BEFORE YOU DIG

CALL TOLL FREE 800-362-2764

OHIO UTILITIES PROTECTION SERVICE