



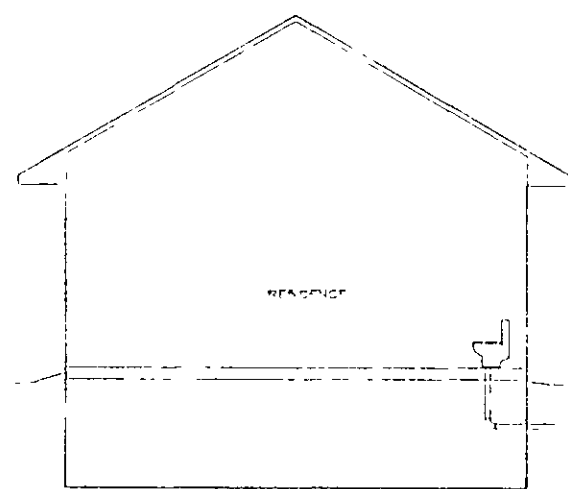


NOTE
LESS THAN 1' FOOT OF RISE BETWEEN GROUND AT TANKS
AND GROUND AT MOUND

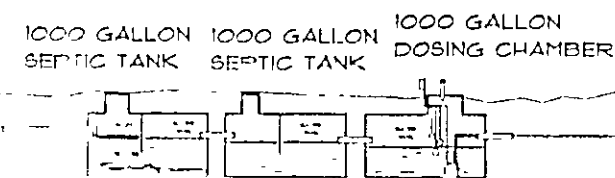

OVERALL SCHEMATIC

NTS

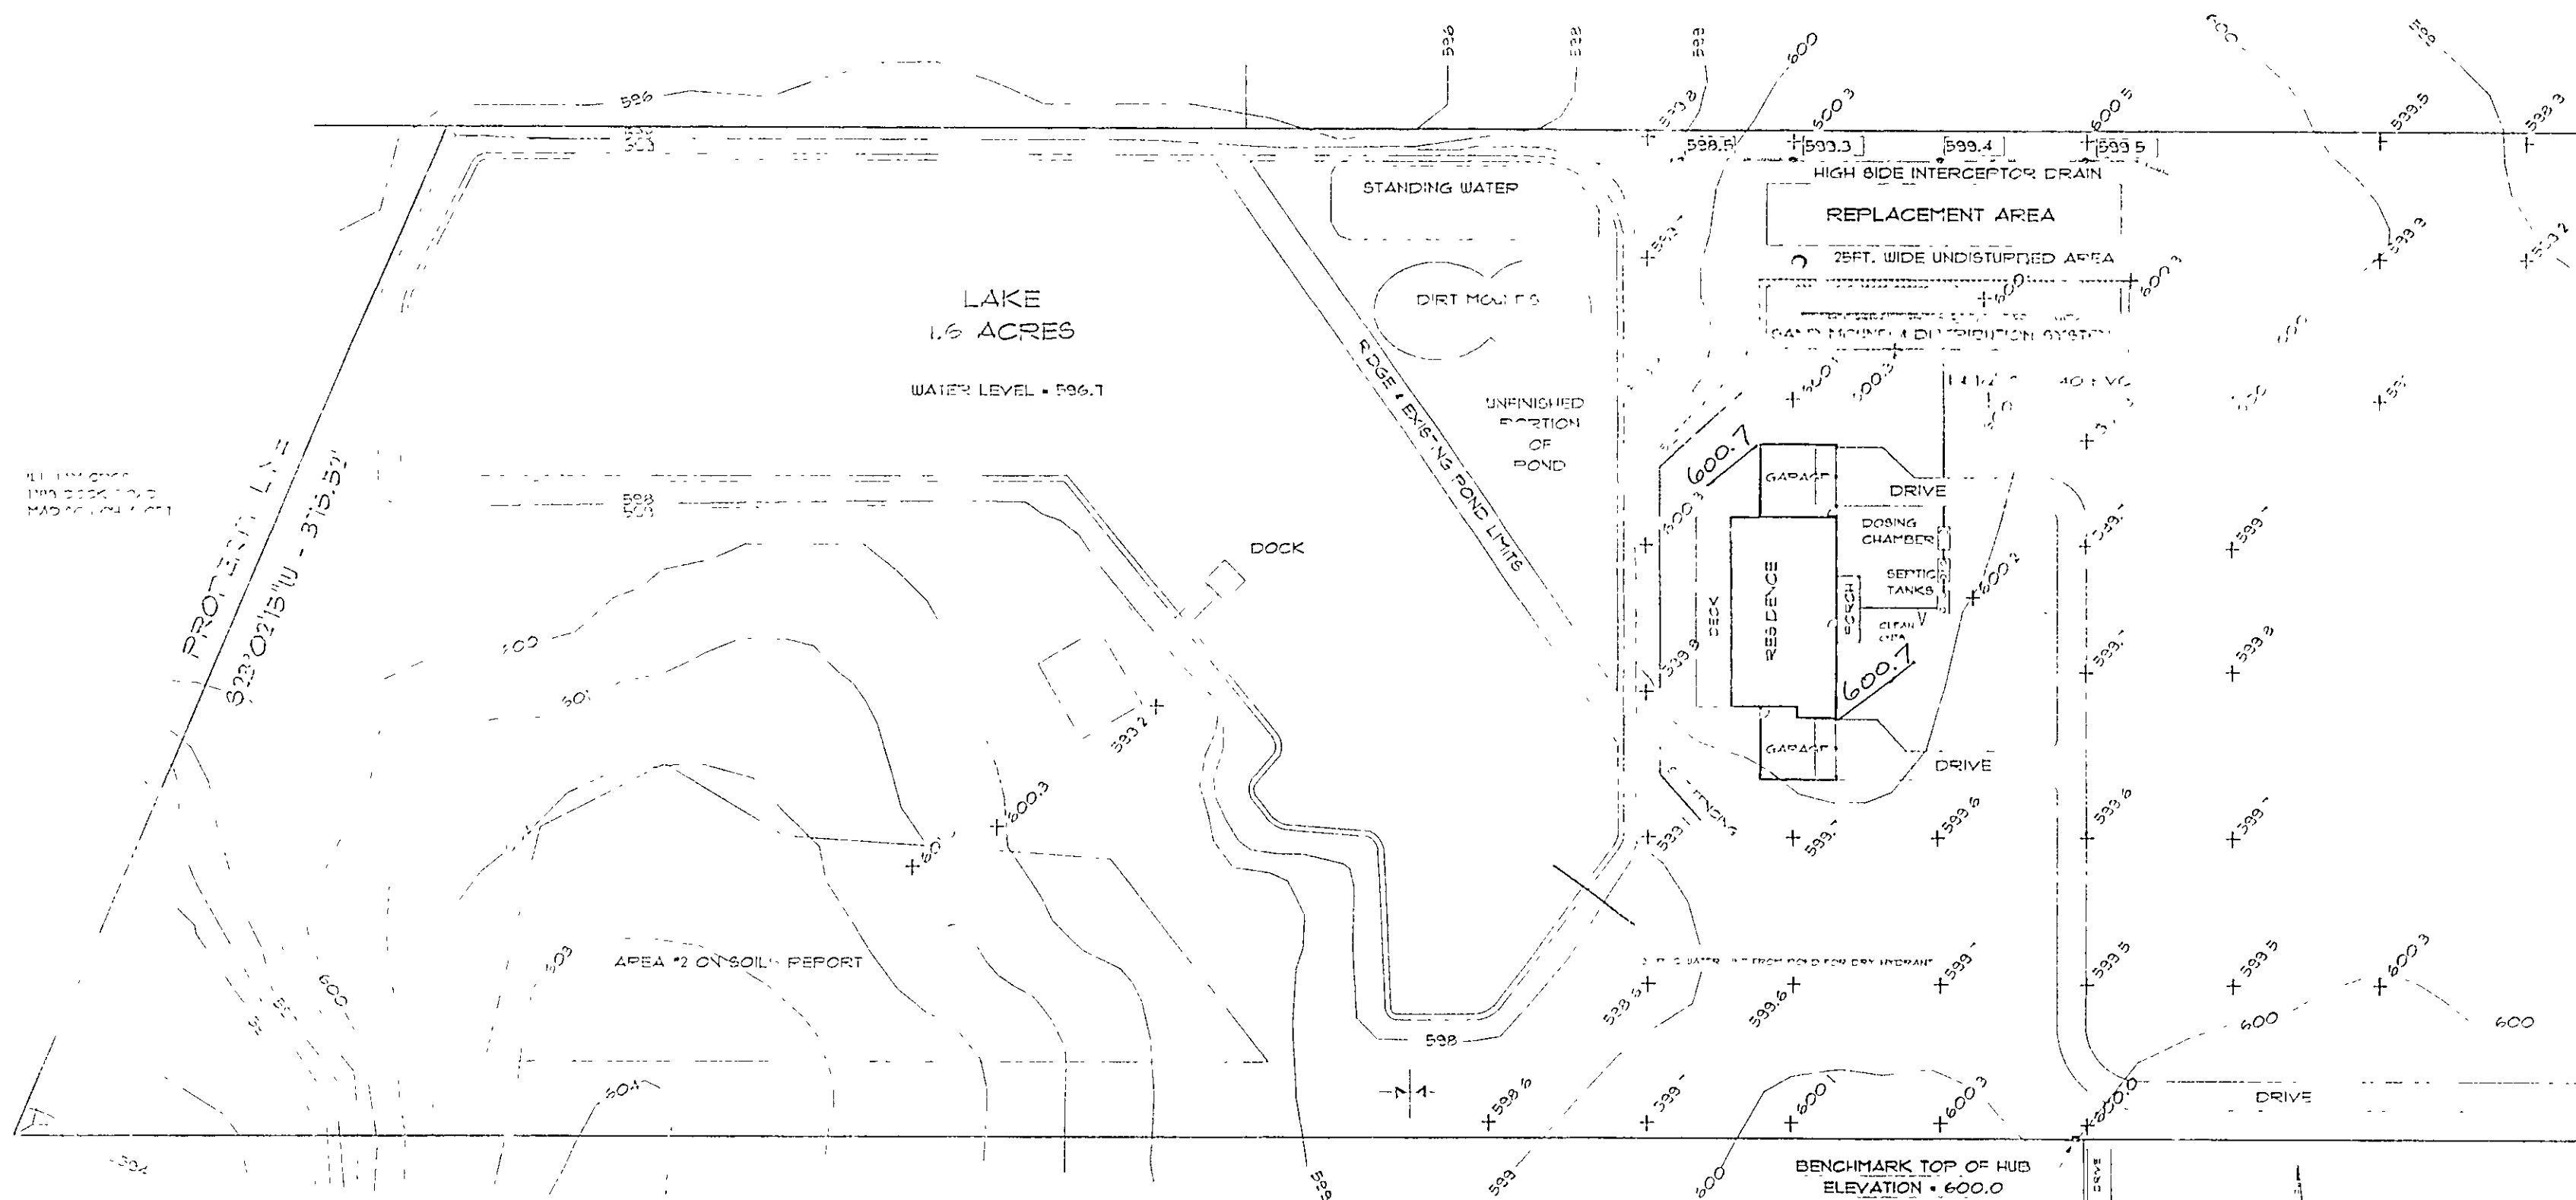


WILLIAM CROSS
1330 COUNTY LINE ROAD
MADISON OH 44041

APPROVED
MADISON TOWNSHIP ZONING
DATE 2/11/09
BY 342-3154

REVIEWED AND ACCEPTED
LAKES COUNTY GENERAL
HEALTH DISTRICT

9-21-07

CITY AND TOWNSHIP PERMIT MUST BE
OBTAINED BY A LAKES COUNTY LICENSED
INSTALLER BEFORE INSTALLATION IS
STARTED

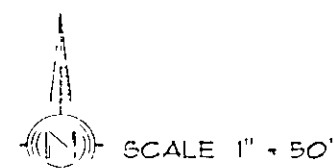

ANGLO NICKOLIC
COUNTY LINE ROAD
MADISON OH 44051

RAMOND PIKE
1314 COUNTY LINE ROAD
MADISON OH 44051

PROPERTY LINE

S89°46'19"W - 1129.36'



PERMANENT PARCEL # 01-A-088-0-00-004-0
9.8034 ACRES

N89°50'04"E - 1280.91'

PROPERTY LINE

REVISED AUGUST 18, 2001 REVISED SEPTEMBER 15, 2001

SITE PLAN OF PROPOSED RESIDENCE		
FOR DAVE M. CROSS 1330 COUNTY LINE ROAD MADISON OHIO 44041		
DRAWN BY JACK ALLMAN, CET 2131 WEST STREET GENEVA OHIO 44041 PHONE 440-466-5976 EMAIL jack.allman@ndstream.net	APPROVED BY JERRY SLAY, PE #6 3102 JEFFERSON ROAD ASHTABULA, OHIO 44004	SHEET 1

Stormwater Management Plan
Approved as shown and/or noted
JAMES R. GILLS, P.E.
County Drainage Engineer/2

By L.S. Date 3/7/09