


NOTE: INSTALL STONE ACCESS DRIVE AT ENTRANCE (SEE DETAIL)

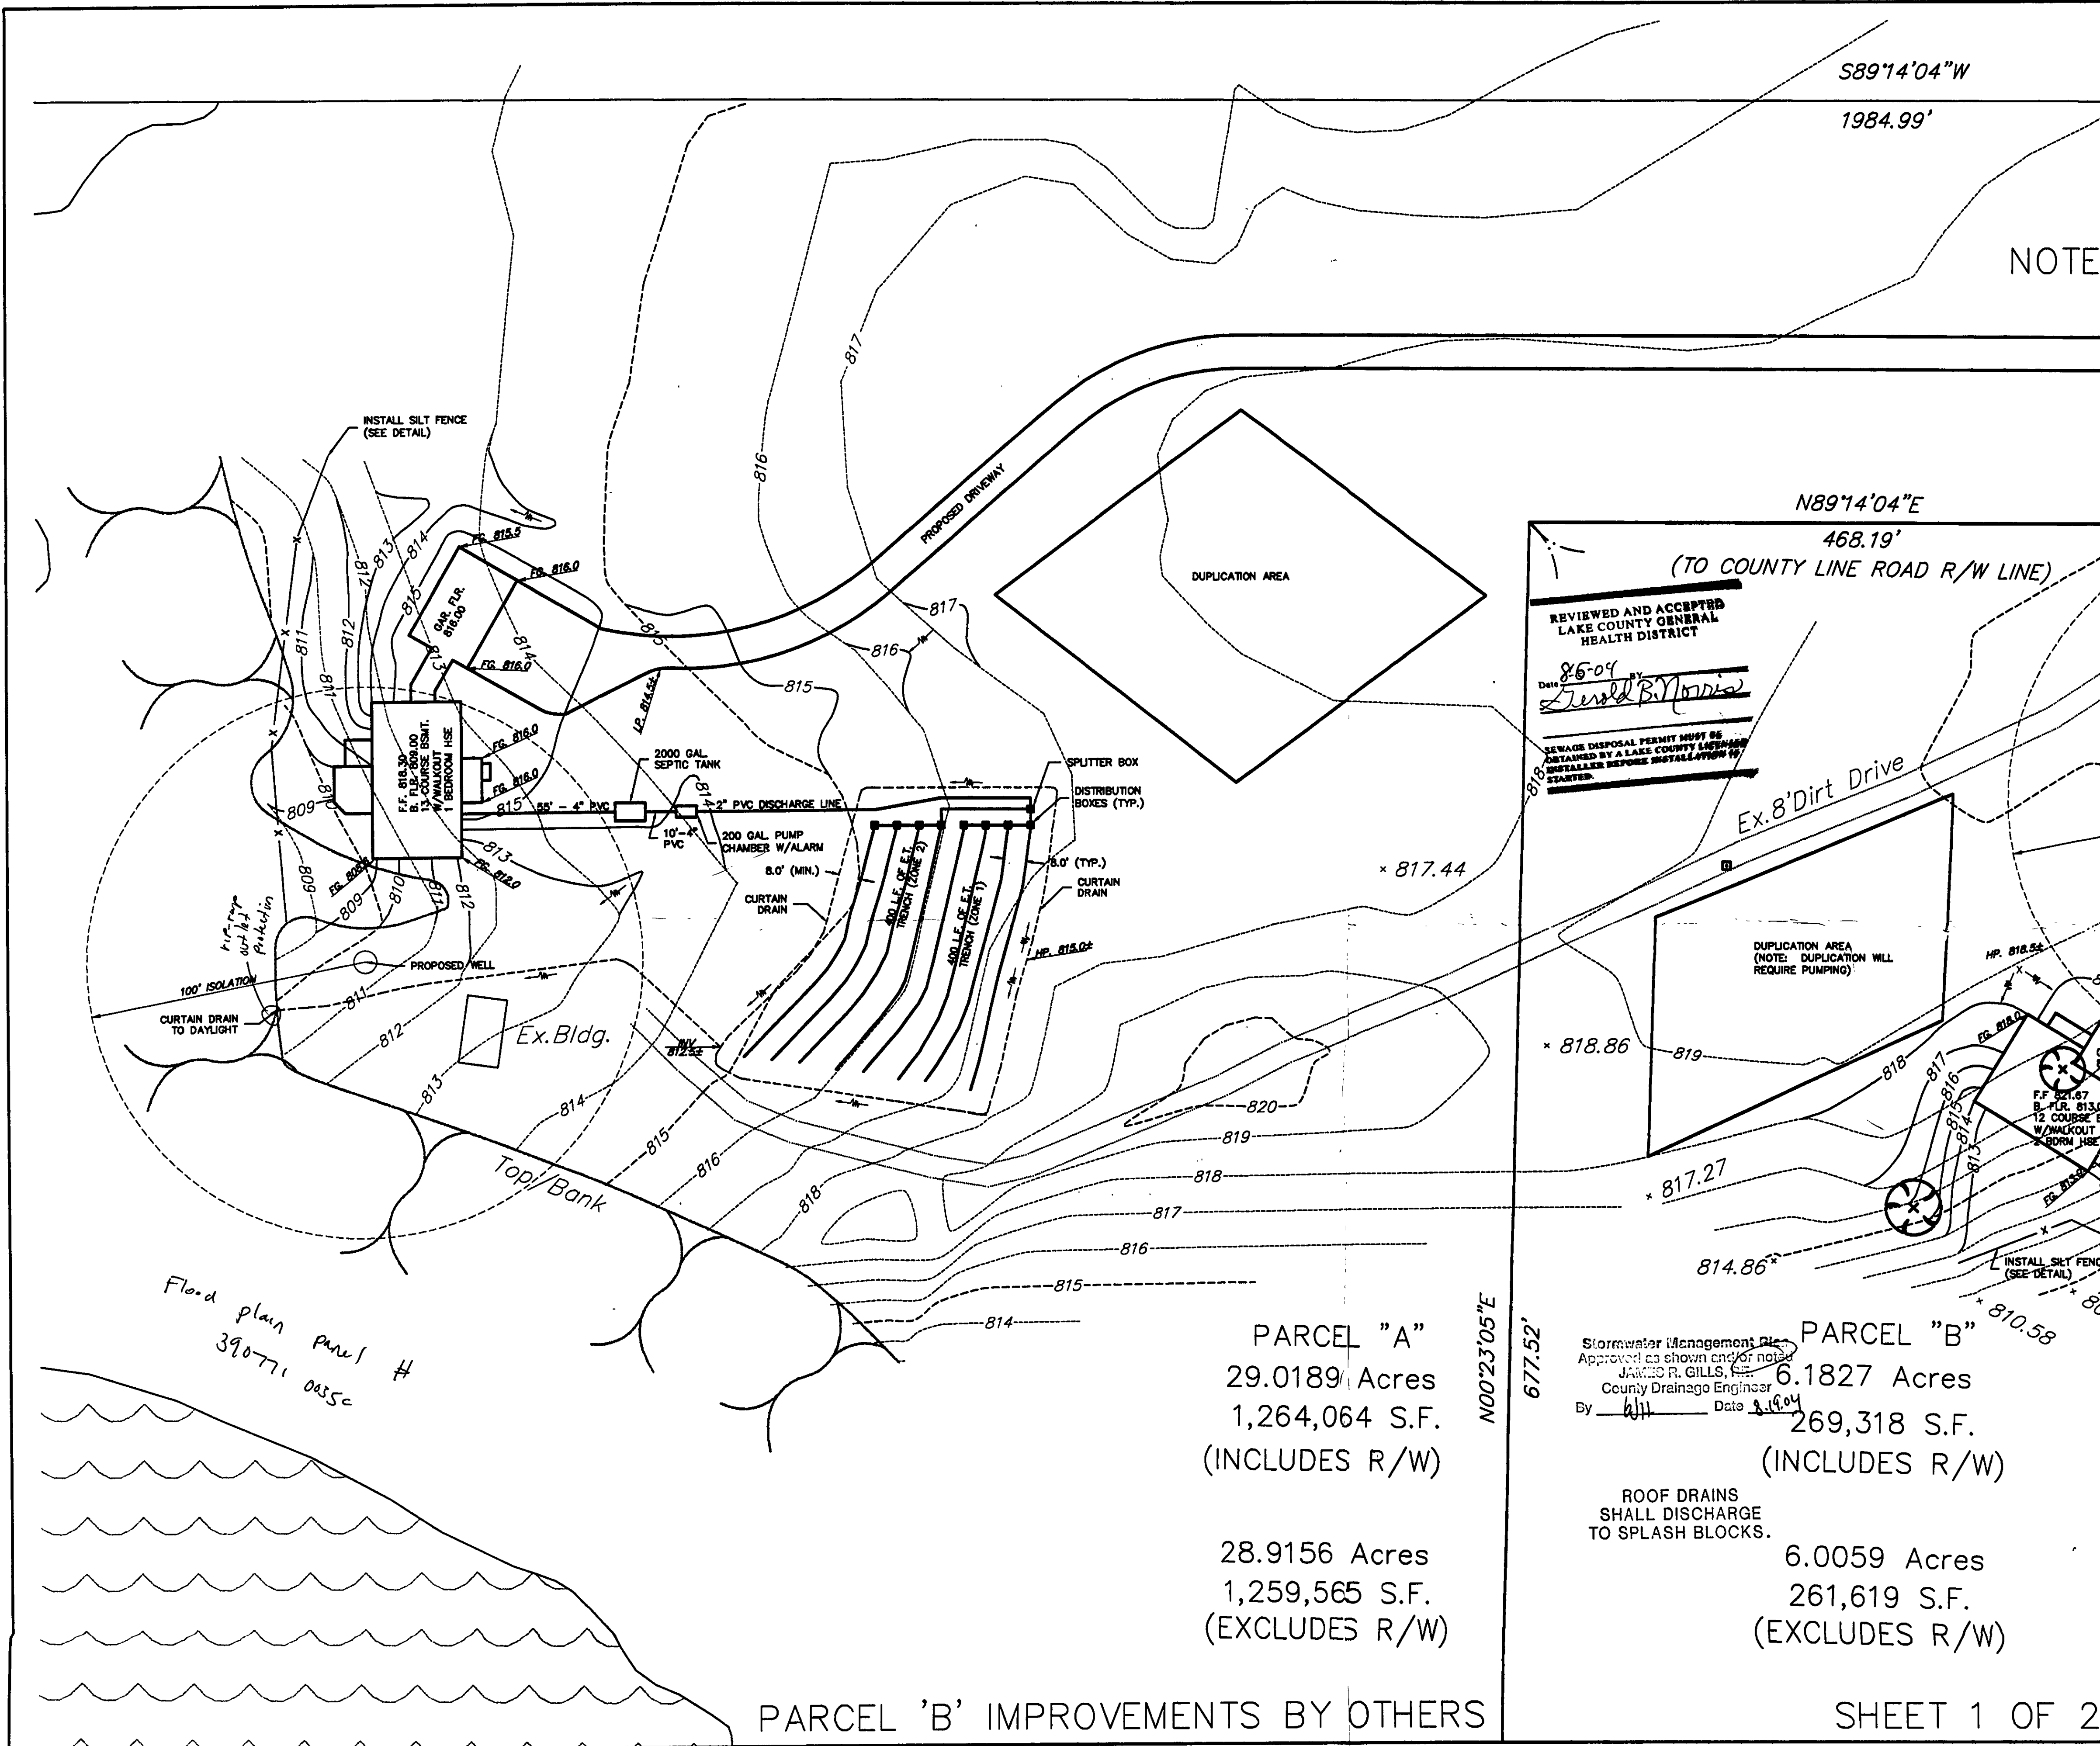

REVIEWED AND ACCEPTED
LAKE COUNTY GENERAL
HEALTH DISTRICT

DATE: 8/6/04
BY: *[Signature]*

SEWAGE DISPOSAL PERMIT MUST BE
OBTAINED BY A LAKE COUNTY LICENSED
INSTALLER BEFORE INSTALLATION IS
STARTED.

I, THE UNDERSIGNED, HEREBY CERTIFY THAT THIS TOPOGRAPHY, INDICATED BY 6", 1", OR 2" CONTOURS, AND ELEVATIONS SHOWN HEREON, REPRESENT AN ACTUAL FIELD SURVEY MADE BY ME ON THE 18th DAY OF JUNE, 2004, AND THAT THE ELEVATIONS WERE TAKEN AT APPROPRIATE INTERVALS AND THAT AS OF THAT DATE, THEY EXISTED AS INDICATED HEREON.

[Signature] 8/2/04
Dustin R. Keeney, P.E. 65515



POLARIS ENGINEERING & SURVEYING, INC.
34600 CHARDON ROAD - SUITE D
WILLOUGHBY HILLS, OHIO 44094
(440) 944-4433 (440) 944-3722 (Fax)
www.polaris-es.com


DESIGN CERTIFICATION

THIS PLAN WAS PREPARED BY ME, AND IS CORRECT TO THE BEST OF MY KNOWLEDGE AND BELIEF.

NAME: *[Signature]* DATE: 8/2/04

BENCHMARK:

B.M. = T.B.M Set On Iron Pin
Located North East Corner of Parcel 'A'
Elevation 819.12

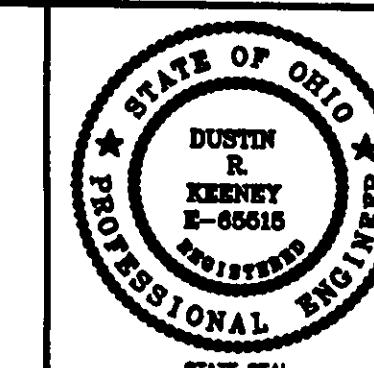

"AS-BUILT" CERTIFICATION

I HEREBY CERTIFY THAT THE CIRCLED INFORMATION IS EXISTING AS OBTAINED ON THE SITE AND IS CORRECT TO THE BEST OF MY KNOWLEDGE AND BELIEF.

NAME: _____ DATE: _____

PARCEL 'A'
CHRIS & CHERYL
BEZZEG

CITY OF MADISON-LAKE COUNTY-OHIO

CONTRACT No.

04603

DATE: 07/28/04

SCALE: HOR. 1"=30'

VERT. 1"=0'

FILENAME: SitePlan.dwg

PARCEL "A"
29.0189 Acres
1,264,064 S.F.
(INCLUDES R/W)

28.9156 Acres
1,259,565 S.F.
(EXCLUDES R/W)

PARCEL 'B' IMPROVEMENTS BY OTHERS

Stormwater Management Plan
Approved as shown and/or noted
JAMES R. GILLS, P.E.
County Drainage Engineer
By *[Signature]* Date 8/6/04

ROOF DRAINS
SHALL DISCHARGE
TO SPLASH BLOCKS.

PARCEL "B"
6.1827 Acres
269,318 S.F.
(INCLUDES R/W)

6.0059 Acres
261,619 S.F.
(EXCLUDES R/W)

SHEET 1 OF 2

APPROVED
MADISON TOWNSHIP ZONING
DATE: 8/16/04
BY: *[Signature]* 2/19/88