


APPROVED
MADISON TOWNSHIP ZONING
DATE 7/30/01
BY JH 20608


REVIEWED AND ACCEPTED
LAKE COUNTY GENERAL
HEALTH DISTRICT
DATE 2-22-01
BY David B. Norris
SEWAGE DISPOSAL PERMIT MUST BE
OBTAINED BY A LAKE COUNTY LICENSED
INSTALLER BEFORE INSTALLATION IS
STARTED.

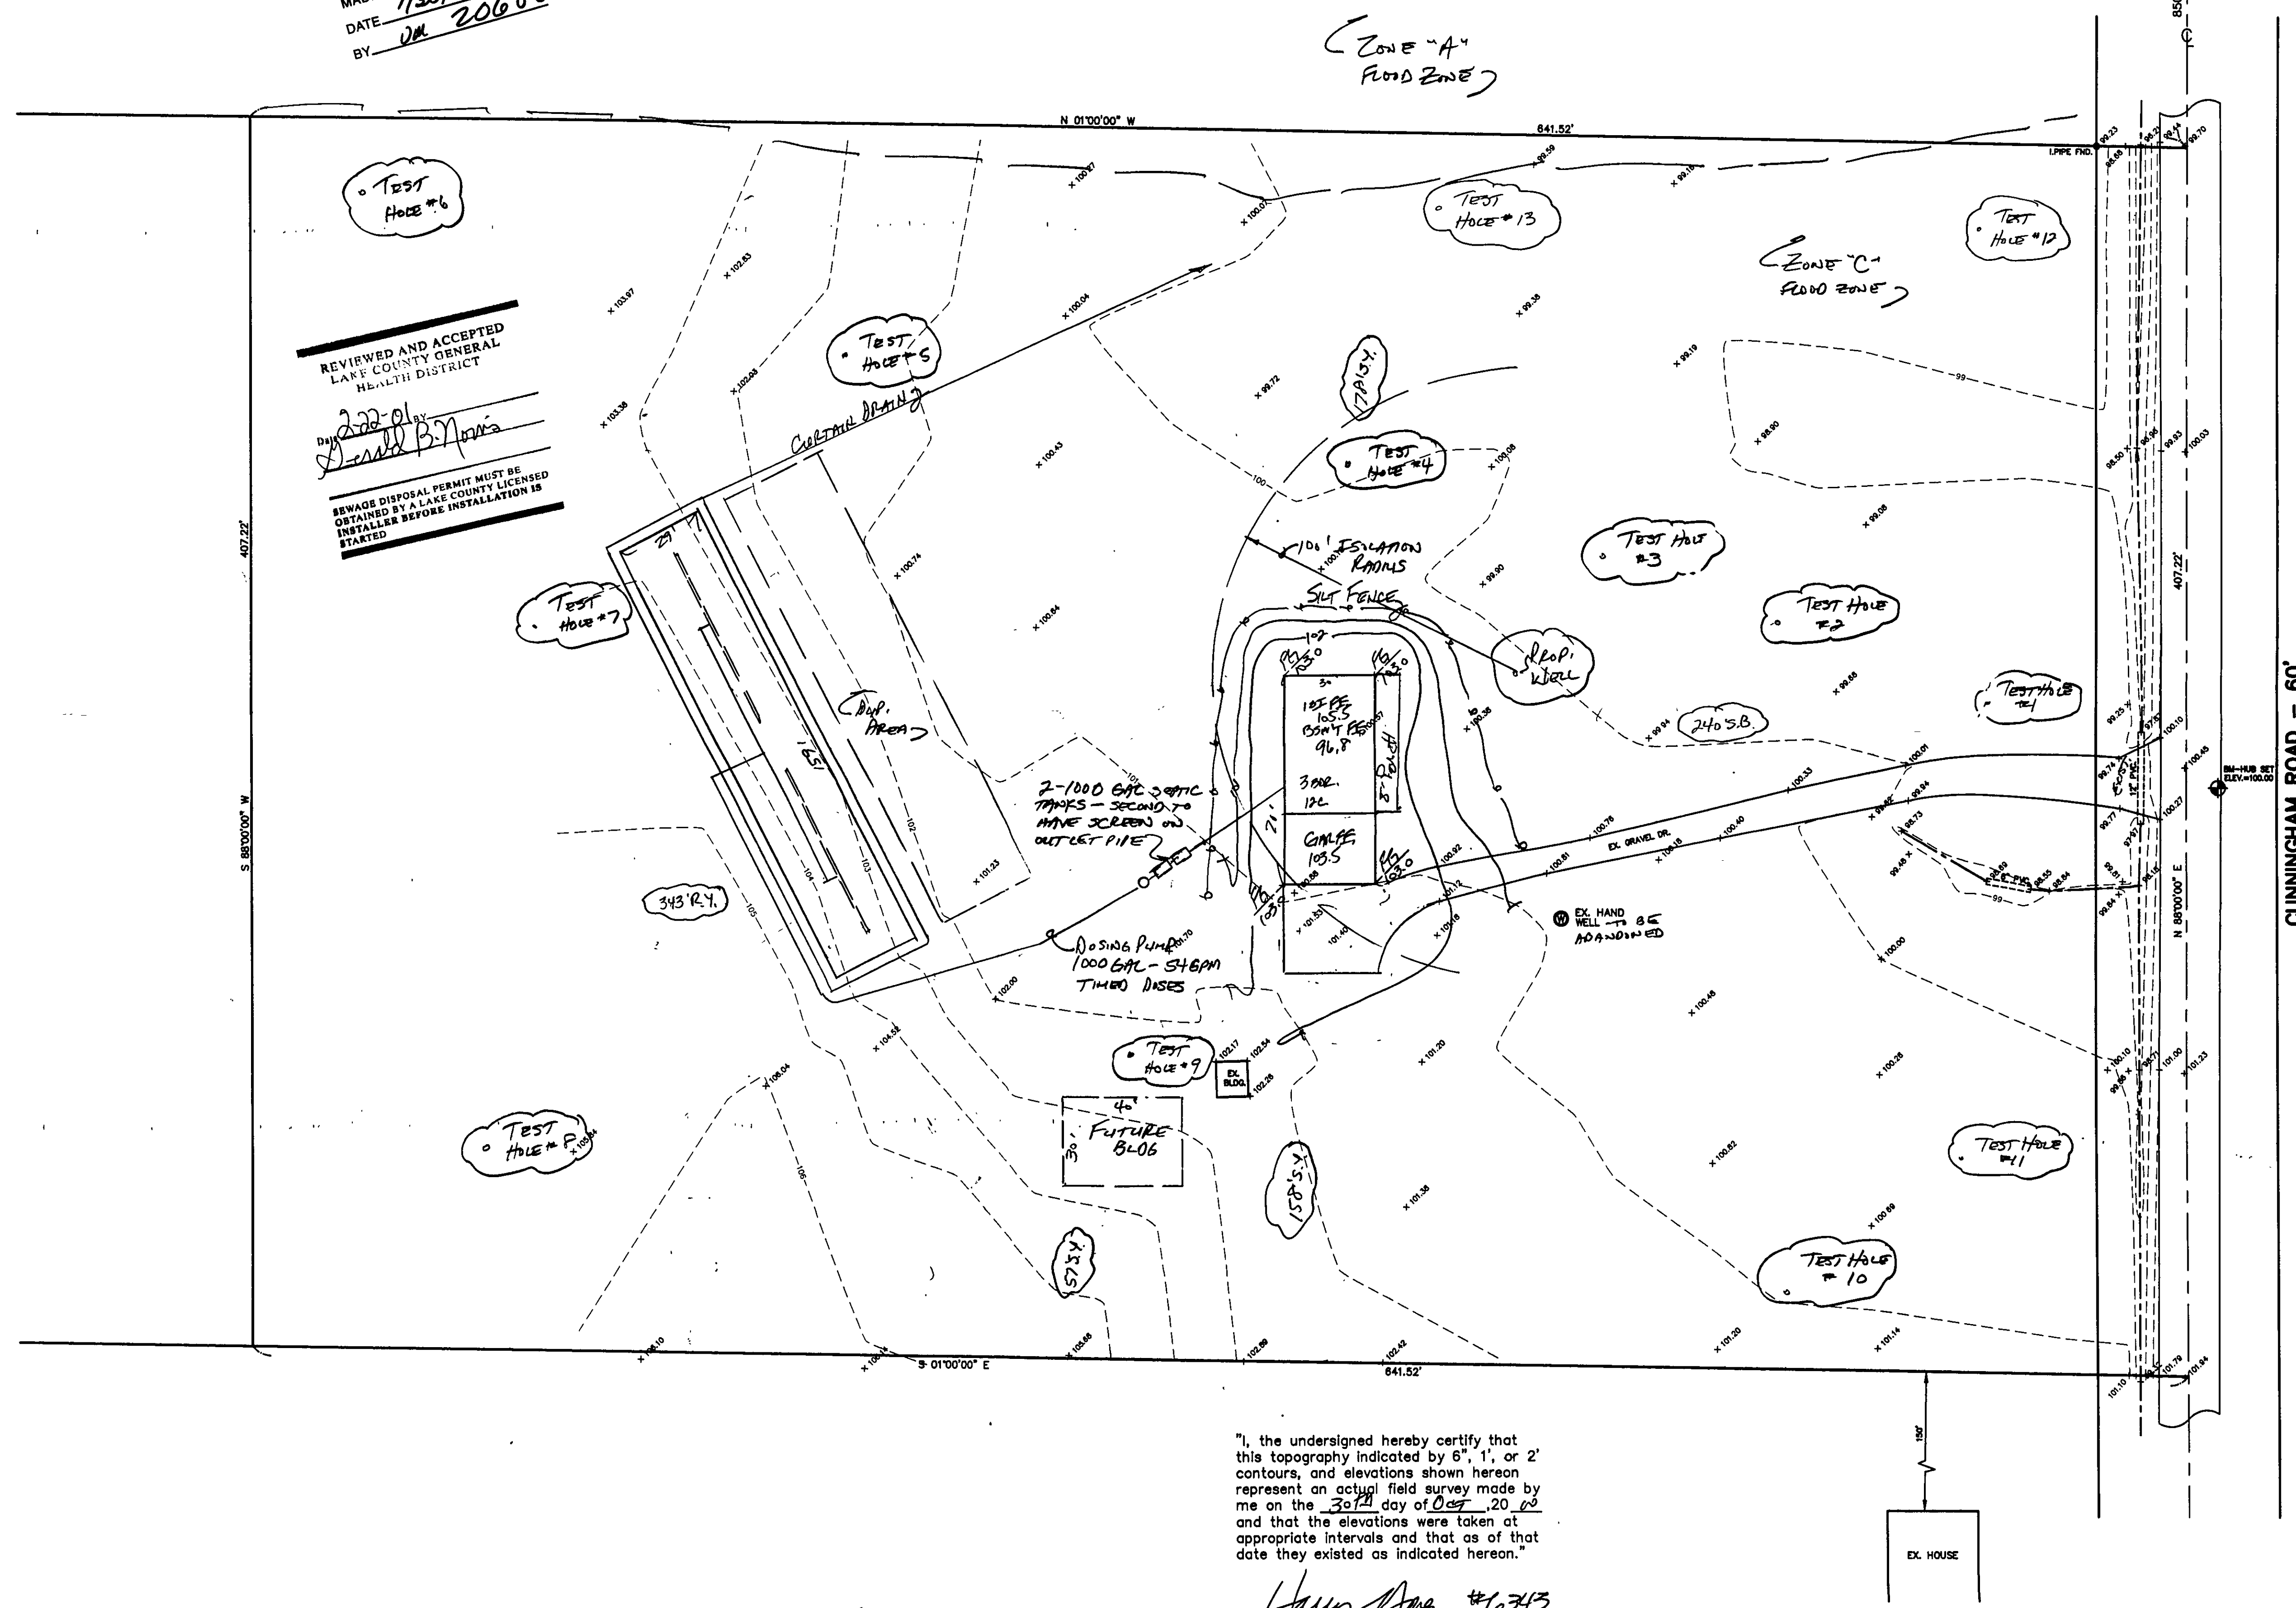

"I, the undersigned hereby certify that this topography indicated by 6", 1", or 2" contours, and elevations shown hereon represent an actual field survey made by me on the 30th day of Oct. 20 00 and that the elevations were taken at appropriate intervals and that as of that date they existed as indicated hereon."

Harry Jones #16343
Name Reg. No.

Grading Plan Approved
as shown and/or noted
JAMES R. GILLS, P.E.
Lake County Engineer
By JH Date 8-3-01

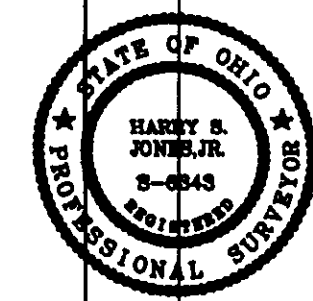

REV. NO.	DESCRIPTION	DATE	BY	CHK'D
1	REVISION HOUSE LOCATION, MONITOR	11/27/00	JH	JH
2	REVISION WELL & FUTURE BLDG	1/11/01	JH	JH
3	REVISION MONITOR & DOSING CHAMBER	1/30/01	JH	JH

bj BABCOCK, JONES AND ASSOCIATES, INC
CIVIL ENGINEERS - SURVEYORS - LAND PLANNERS
PAINESVILLE OHIO 44077

DATE 10/31/00
DESIGN BY H.J.
DRAWN BY T.R.
APPROVED BY H.J.

SITE PLAN
FOR
CHRIS GUGGENBILLER
MADISON TOWNSHIP
LAKE COUNTY

SCALE: 1"=30'
JOB NO. 00-25
SHEET