

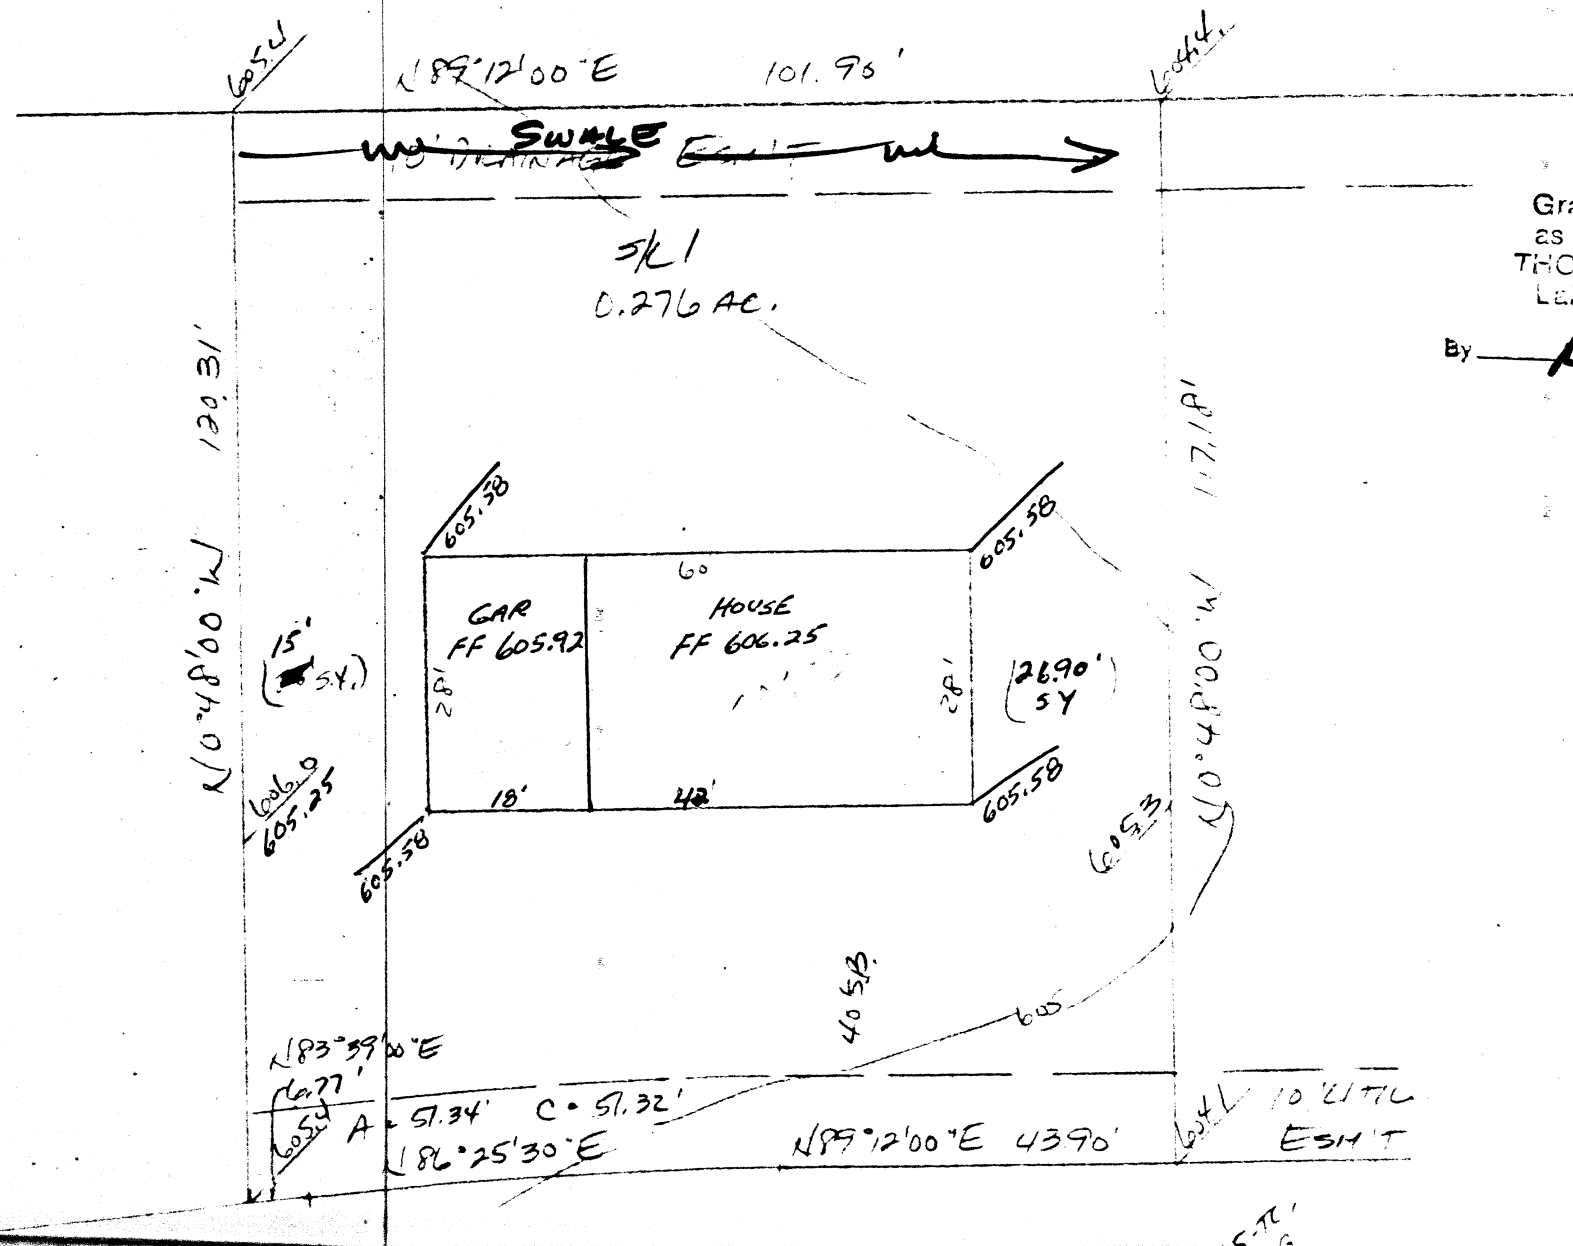


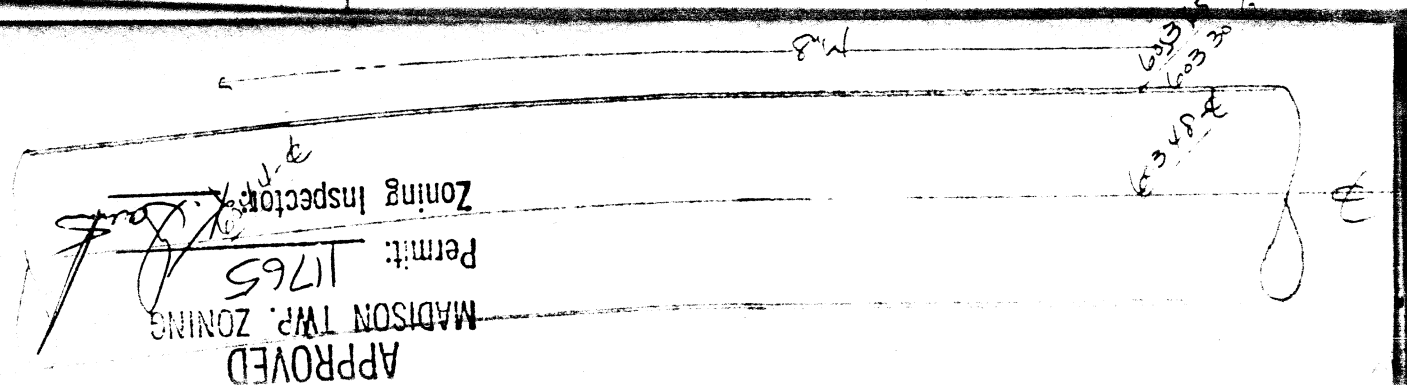

Grading Plan Approved
as shown and/or noted
THOMAS P. GILLES, P.E.
Lake County Engineer

By BMP Date 7-2-86

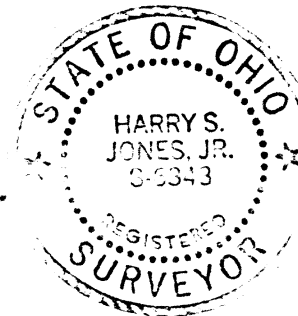

SITE PLAN

MADISON LAKE COUNTY, OHIO
TOWNSHIP

for: PENFIELD INC.
CLIENT OWNER
7596 CHIPPENAW RD. BRECKSVILLE 44141
ADDRESS STREET CITY ZIP

SUBDIVISION <u>MEADOWS SUB</u>	NAME <u>R-46</u>	LOT	TRACT
SUBLOT NO. <u>1</u>	STREET <u>DAVE DR</u>	VOLUME	PAGE
		PERM. PARCEL NO.	STREET

LEGEND

SANITARY MANHOLE	---	WATER VALVE (GAS)	---
STORM MANHOLE	---	WATER METER (GAS)	---
INLET OR CATCH BASIN	---	AS BUILT ELEVATION	100.0
HYDRANT	---	INDICATES	
EXISTING CONTOURS	---	DIRECTION OF	
PROPOSED CONTOURS	---	SURFACE DRAINAGE	
EXIST. ELEV. <u>100.0</u>		PROP. ELEV. <u>100.0</u>	

REMARKS

ALL BOUNDARY DATA SHOWN WAS OBTAINED FROM (DEEDS, RECORDED
SUBDIVISION PLAT OR OTHER PUBLIC RECORDS)

LOCATIONS AS SHOWN OF ADJACENT WELLS AND SEPTIC TANKS OBTAINED FROM
LAKE COUNTY HEALTH DEPARTMENT

DESIGN CERTIFICATION

THIS PLAT WAS PREPARED BY ME, AND IS CORRECT
TO THE BEST OF MY KNOWLEDGE AND BELIEF.

NAME Harry S. Jones, Jr. SURVEYOR REGISTRATION NO. 6343

CHECK LIST

NO. OF BEDROOMS	WATER MAIN SIZE, LOCATION
DIMENSIONS	SAN. SEWER SIZE % GR. LOC.
BEARINGS	SAN. MH. CAST. ELEV. INV. ELEV.
TIE TO NEAREST STREET	SAN. CONN. SIZE, LOC. DEPTH
SUBLOT NO. PARCEL NO.	STORM SEWER SIZE % GR. LOC.
SURROUNDING OWNERS	STORM MH. CAST ELEV. INV. ELEV.
BLDG. DIMENSIONS FIN. GR.	PAV'T TYPE GRADE CURBS
BLDG. TIES FL'R. GRADES	GAS LINE LOC. SIZE PRESSURE
APRON TYPE WIDTH THICKNESS	SEPTIC TANK LOCATION & DUPLICATION AREA
SIDEWALK TYPE WIDTH THICKNESS	WELL LOCATION
CULVERT TYPE DIA., LENGTH	ISOLATION RADIUS FROM WELL
ROCK OUTCROPPINGS	

REVISIONS

NO.	DATE	BY
1		
2		
3		
4		
5		

PLAN PREPARED BY:

BABCOCK • JONES & ASSOCIATES, INC.

PAINESVILLE, OHIO

DRAWN BY <u>HT</u>	SCALE <u>1" = 50'</u>	PHONE NO. <u>357-1811</u>
CHK'D. <u>HT</u>	DATE <u>3/4/86</u>	DRAWING NO. <u>PS-123-1</u>
CREW CHIEF <u>HT</u>	APP'D. <u>HT</u>	

"AS BUILT" CERTIFICATION

I, HEREBY CERTIFY THAT THE CIRCLED GRADES ARE EXISTING
FINISH GRADES CHECKED IN THE FIELD ON 7-2-86, 1986
AND ARE CORRECT TO THE BEST OF MY KNOWLEDGE AND BELIEF.