
CURVE TABLE						
CURVE	LENGTH	RADIUS	TANGENT	CHORD	BEARING	DELTA
C1	263.75	700.00	133.46	262.19	S8019'22"E	21'35'17"
C2	94.81	730.00	47.47	94.74	S77"11'35"E	07*26'28"

Repartoyed as shown and/or re-JAMES R. GILLS, R.E. County Drainage Engineer/ . S. Date <u>4//9/</u>ລາ

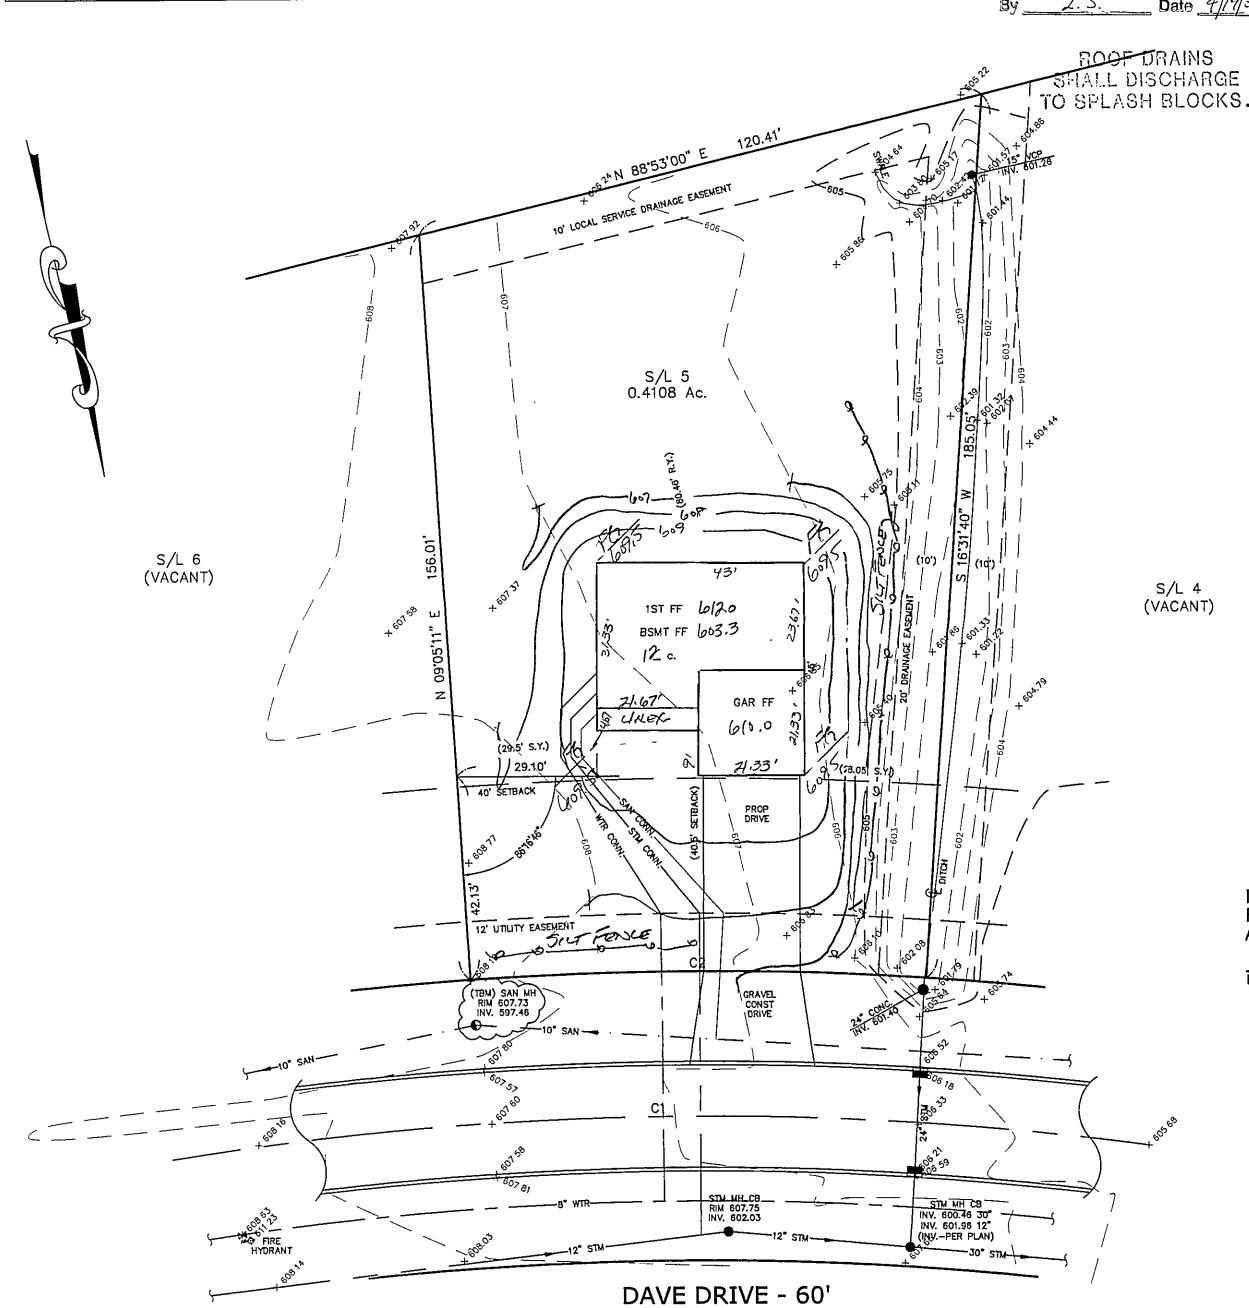

SITE PLAN

MADISON TOWNSHIP, LAKE COUNTY, OHIO

for: NORTHCOAST HOMES

ADDRESS STREET KIMBALL ESTATES #2 SUBDIVISION 48-20 STREET LOT SUBLOT NO. PERM. PARCEL NO. STREET VOL.-PG. **LEGEND** EXIST. ELEV. 5 100.0 2 PROP. ELEV. SANITARY MANHOLE ----STORM MANHOLE ---AS BUILT ELEVATION

REMARKS

ALL BOUNDARY DATA SHOWN WAS OBTAINED FROM (DEEDS, RECORDED SUBDIVISION PLAT OR OTHER PUBLIC RECORDS)

LOCATIONS AS SHOWN OF ADJACENT WELLS AND SEPTIC TANKS OBTAINED FROM LAKE COUNTY HEALTH DEPARTMENT

DESIGN CERTIFICATION

THIS, PLAT WAS PREPARED BY ME, AND IS CORRECT TO THE BEST OF MY, KNOWLEDGE AND BELIEF. SURVEYOR *10343

CHECK LIST

NO. OF BEDROOMS
DIMENSIONS
BEARINGS
TIE TO NEAREST STREET
SUBLOT NO. PARCEL NO.
SURROUNDING OWNERS
BLDG. DIES SION STATES BLDG. DIMENSIONS FIN GR.
BLDG. TIES FL'R. GRADES
APRON TYPE WIDTH THICKNESS
SIDEWALK TYPE WIDTH THICKNESS
CULVERT TYPE DIA., LENGTH
ROCK OUTCROPPINGS

NAME

INLET OR CATCH BASIN

PROPOSED CONTOURS-

WATER MAIN SIZE, LOCATION SAN. SEWER SIZE % GR. LOC. SAN. MH. CAST. ELEV. INV. ELEV. SAN. MH. CASI. ELEV. INV. ELEV.
SAN. CONN. SIZE, LOC. DEPTH
STORM SEWER SIZE % GR. LOC.
STORM MH. CAST ELEV. INV. ELEV. PAY'T TYPE GRADE CURBS GAS LINE LOC. SIZE PRESSURE SEPTIC TANK LOCATION & DUPLICATION AREA WELL LOCATION ISOLATION RADIUS FROM WELL

REGISTRATION NO.

INDICATES DIRECTION OF SURFACE DRAINAGE

PLAN PREPARED BY: BABCOCK · JONES & ASSOCIATES, INC. PAINESVILLE, OHIO

IONE NO. 440–357–1811 CALE 1"=20' YB.P. DATE 1/27/05 DRAWING NO. H.J. 04-243-5 W.B.

"AS BUILT" CERTIFICATION , HEREBY CERTIFY THAT THE CIRCLED GRADES ARE EXISTING FINISH GRADES CHECKED IN THE FIELD ON _ AND ARE CORRECT TO THE BEST OF MY KNOWLEDGE AND BELIEF.

REGISTERED SURVEYOR

REG. NO.

TBM - SANITARY MANHOLE ELEV - 607.73

3/14/05

EXISTING UTILITIES NOTE: THE SIZE AND LOCATION, BOTH HORIZONTAL AND VERTICAL OF THE UNDERGROUND UTILITIES SHOWN HEREON, HAVE BEEN OBTAINED BY A SEARCH OF AVAILABLE RECORDS. VERIFICATION BY FIELD OBSERVATION HAS BEEN CONDUCTED WHERE PRACTICAL, HOWEVER, BABCOCK, JONES AND ASSOCIATES INC. DOES NOT GUARANTEE THE COMPLETENESS NOR ACCURACY

