

SCALE: 1"=50'

GERARD F. & FLORENCE A. WETZEL
VOL. 236 PG. 187


EXIST. WELL
O

EXIST. DWELLING

18' MACADAM PAVEMENT

97.67

Z

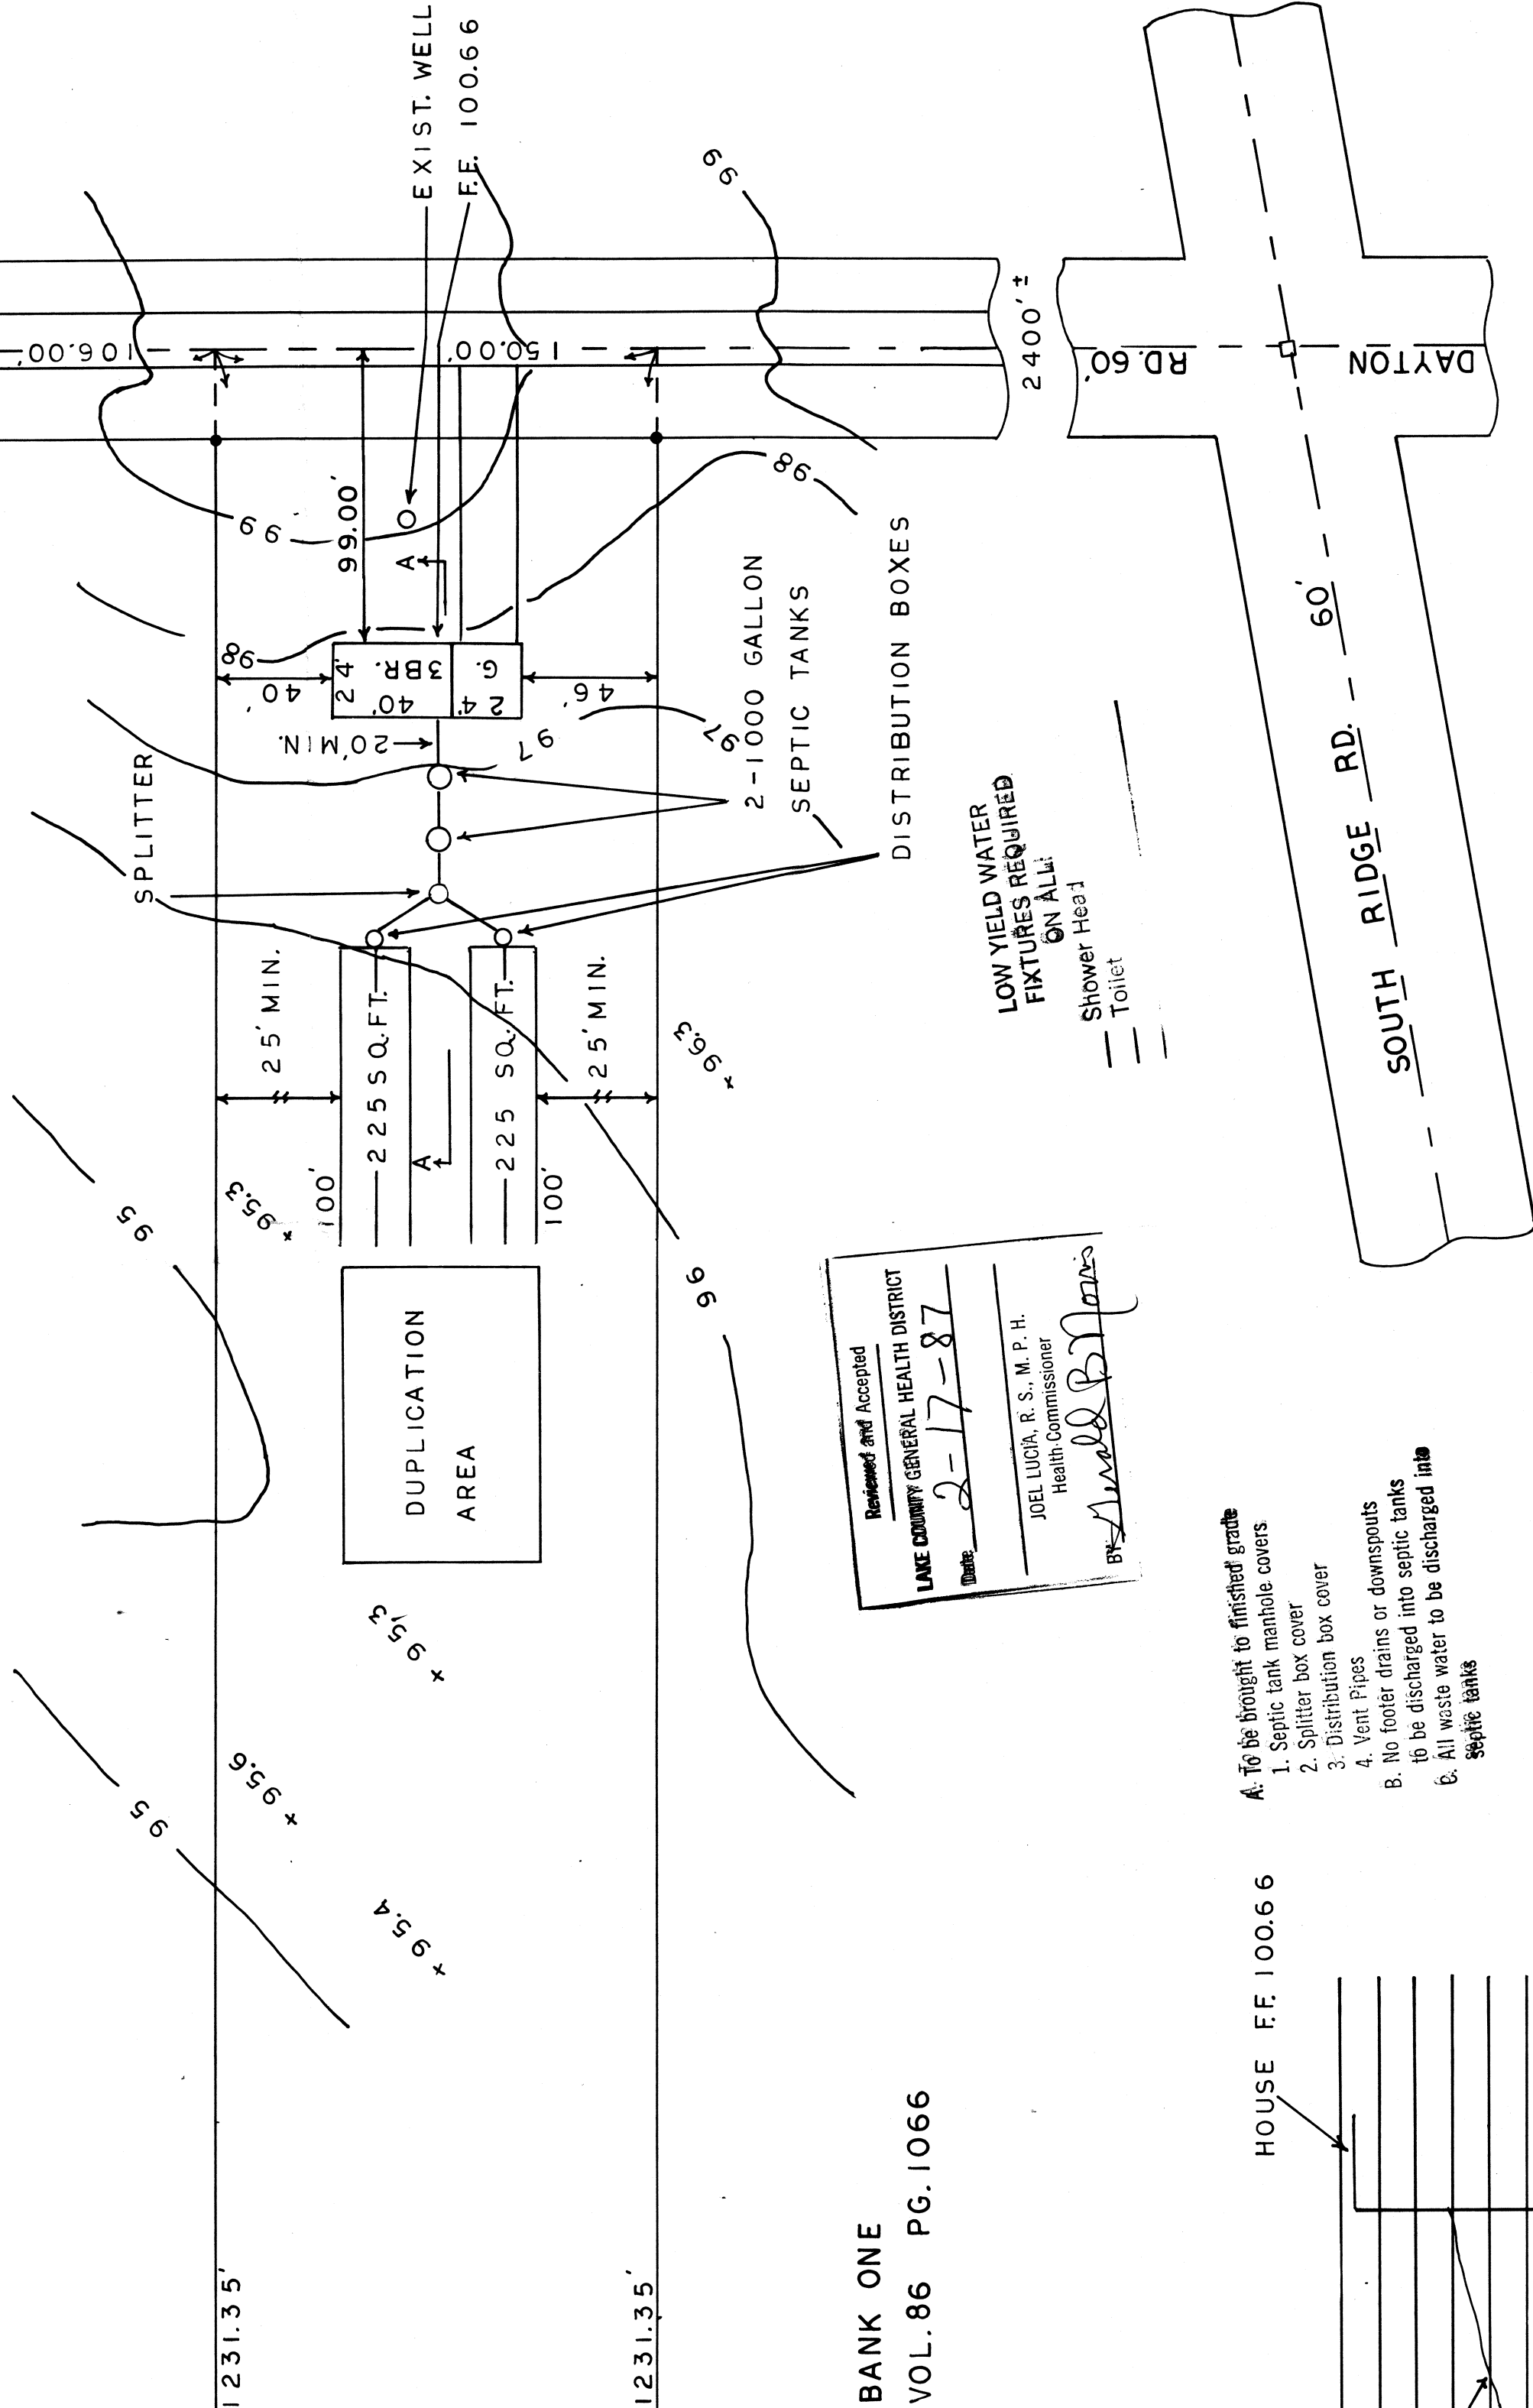


BANK ONE
VOL. 86 PG. 1066


Reviewed and Accepted
LAKE COUNTY GENERAL HEALTH DISTRICT
Date: 2-17-87
JOEL LUCIA, R. S., M. P. H.
Health Commissioner
By: [Signature]

- A. To be brought to finished grade
1. Septic tank manhole covers
 2. Splitter box cover
 3. Distribution box cover
 4. Vent Pipes
- B. No footer drains or downspouts to be discharged into septic tanks.
- C. All waste water to be discharged into septic tanks

SEWER DISPOSAL PERMIT MUST BE OBTAINED BY LAKE COUNTY LICENSED INSTALLER BEFORE INSTALLATION IS STARTED.

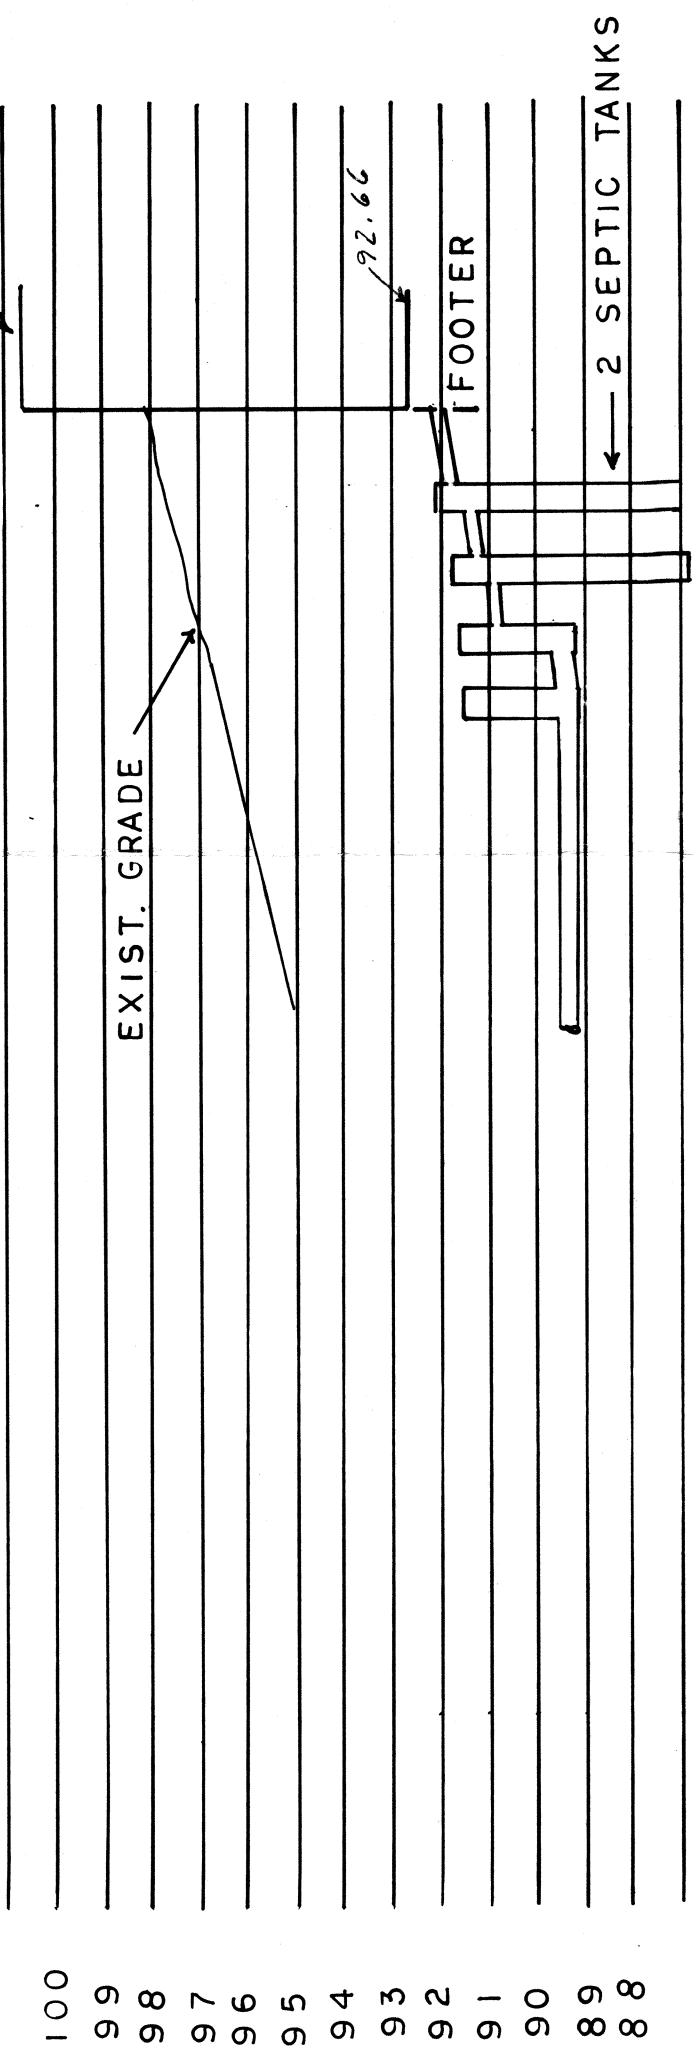

PROFILE A-A
HOR: 1"=40' VERT: 1"=4'

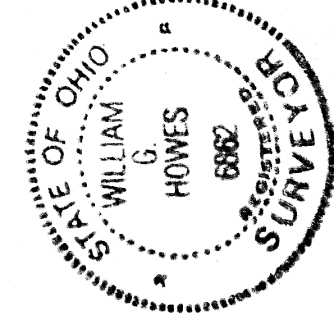

SURVEY FOR
JOHN W. WATTS
Mykon Rd. South of South Ridge Rd.

APPROVED
MADISON TWP. ZONING
Permit 12005
Zoning [Signature]

Grading Plan Approved
as shown and described
by THOMAS P. GUILLES, P.E.
Lake County Engineer
By: [Signature] Date: 2-12-87