


SCALE: Horiz: 1" = 50'
VERT: 1" = 5'

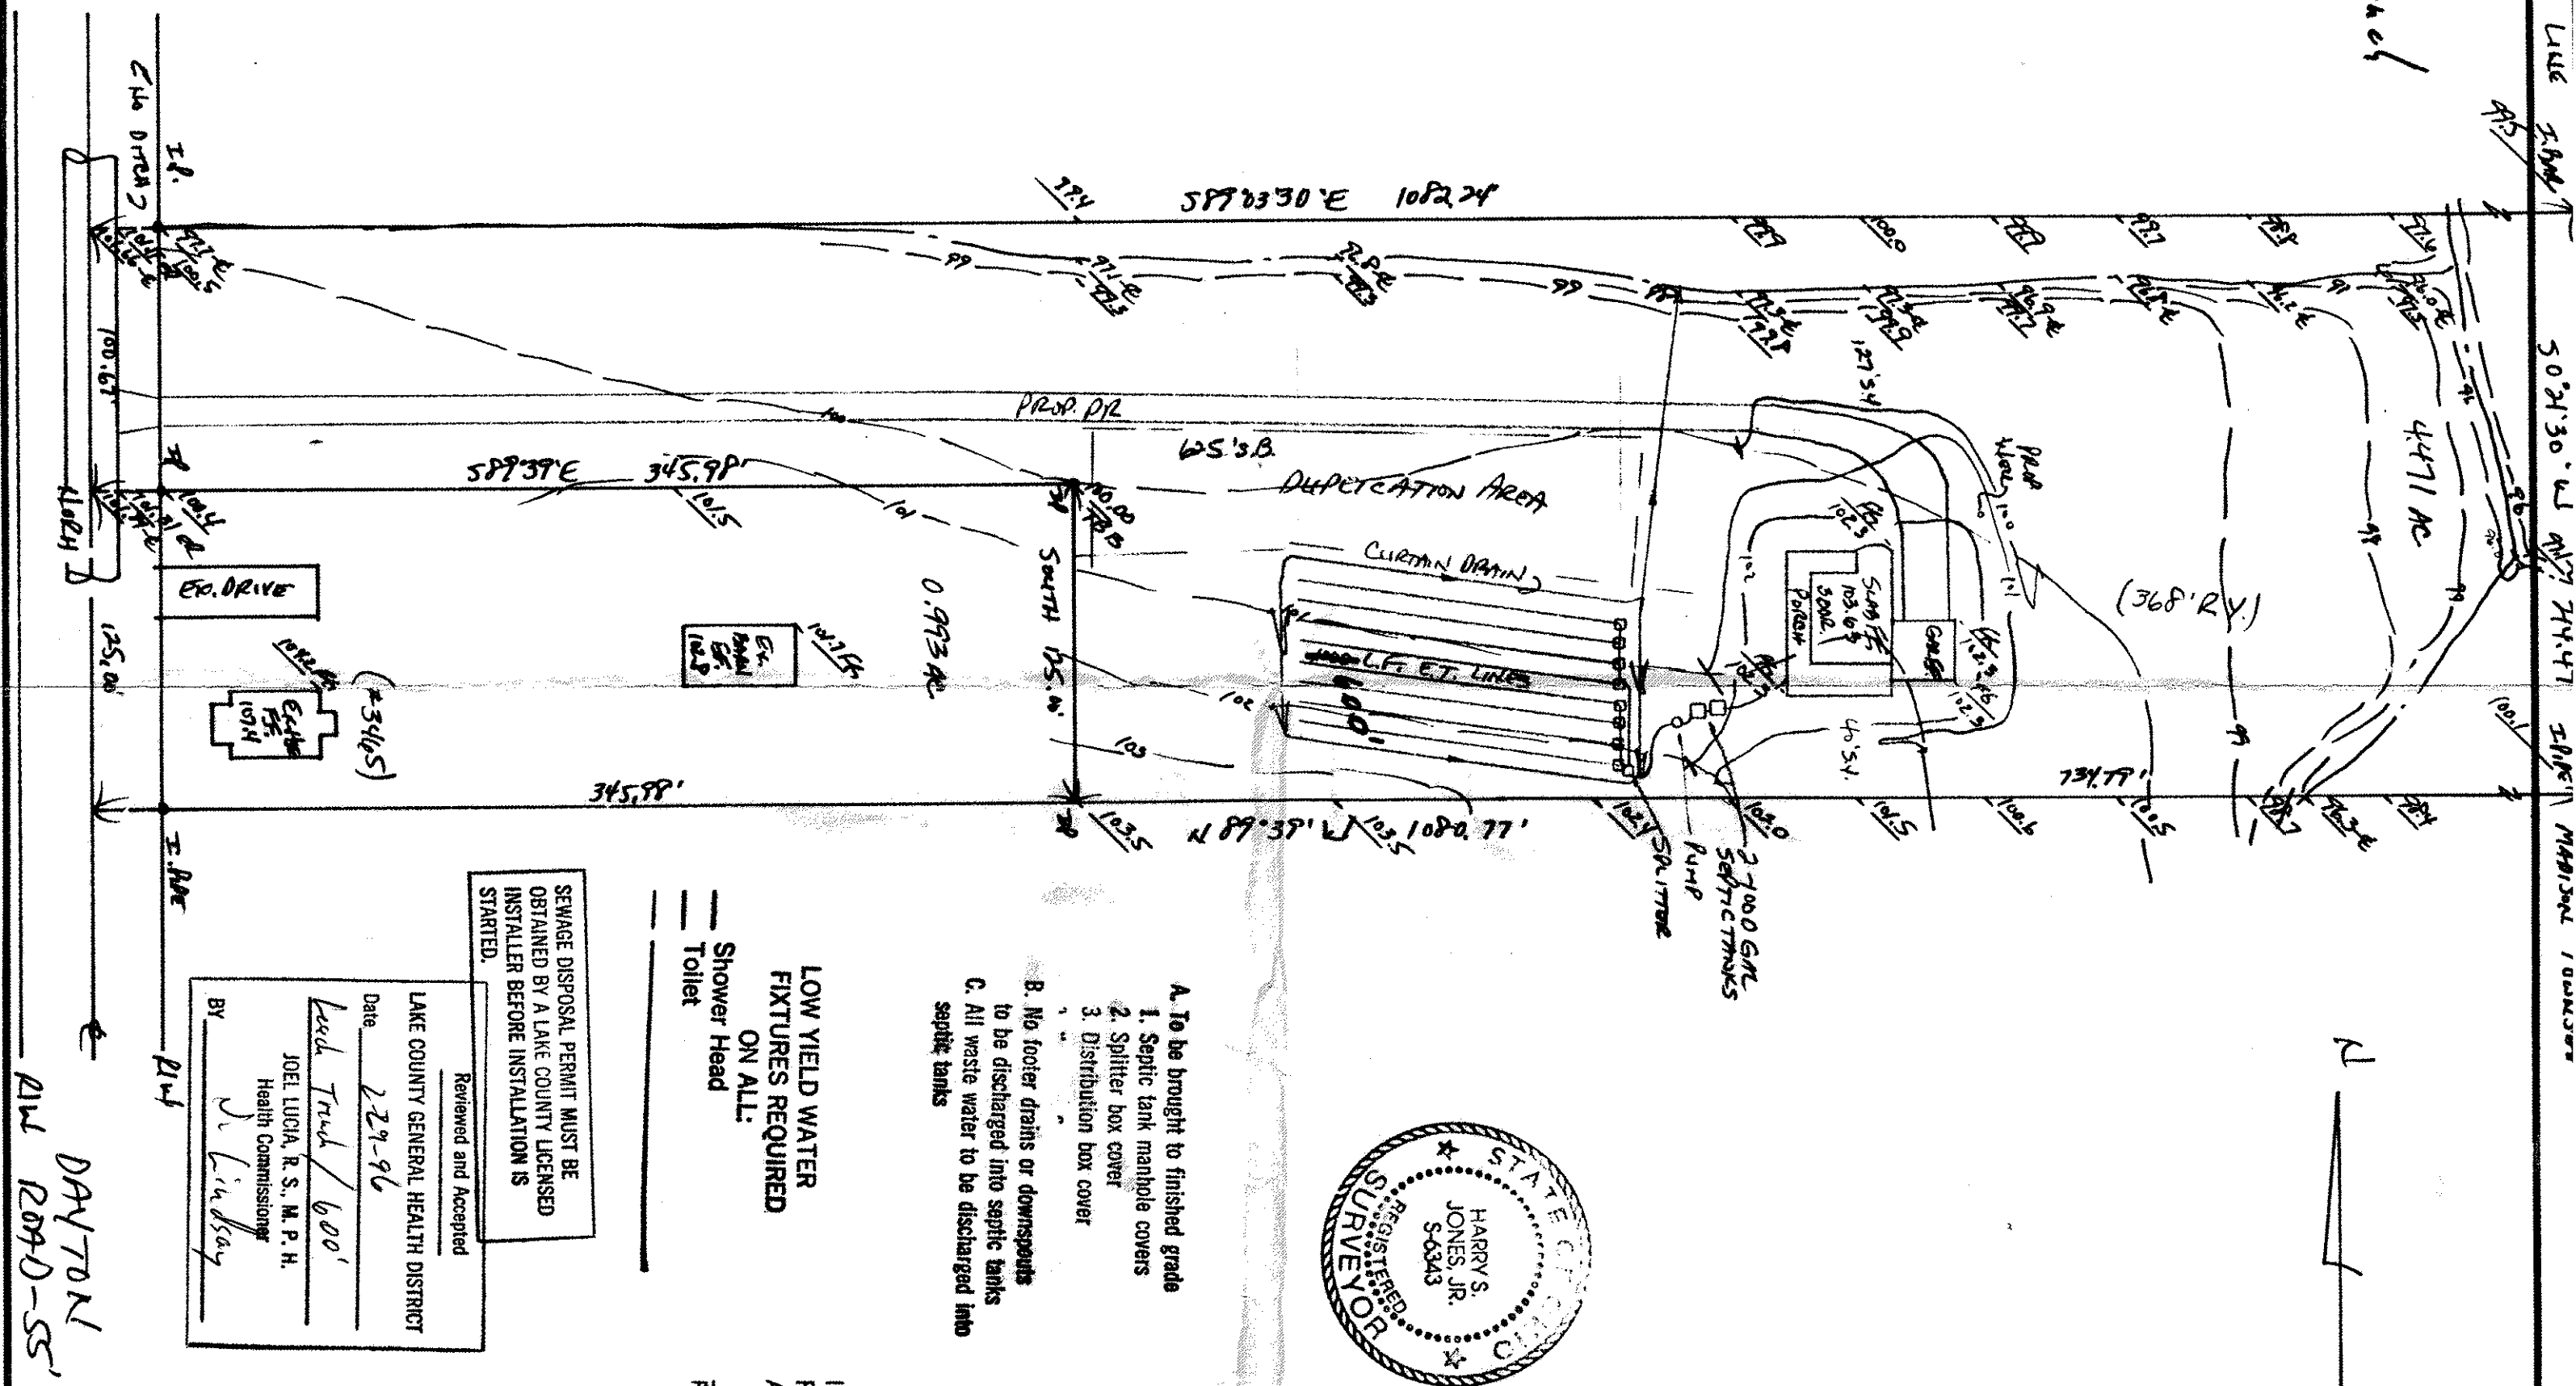

- A. To be brought to finished grade
 1. Septic tank manhole covers
 2. Splitter box cover
 3. Distribution box cover
- B. No footer drains or downspouts to be discharged into septic tanks
- C. All waste water to be discharged into septic tanks

**LOW YIELD WATER
FIXTURES REQUIRED
ON ALL:
Shower Head
Toilet**

SEWAGE DISPOSAL PERMIT MUST BE OBTAINED BY A LAKE COUNTY LICENSED INSTALLER BEFORE INSTALLATION IS STARTED.

Reviewed and Accepted

LAKE COUNTY GENERAL HEALTH DISTRICT

Date 2-29-96

Leeds Truck / 600'

JOEL LUCIA, R. S., M. P. H.

16

BY Eric L. Hays

PLW

DA/7

01.10.2020

10-10-74

I, HEREBY CERTIFY THAT THE CIRCLED GRADES ARE EXISTING
FINISH GRADES CHECKED IN THE FIELD ON _____, 19____,
AND ARE CORRECT TO THE BEST OF MY KNOWLEDGE AND BELIEF

REG. NO

734-7 of 760 pin @ K.E. CONNER

of 1.079 Ae. LOT SPRT. -ELEV. - 100.00

1996
WADSWORTH
Grading Plan Approved

MAR 16 1964
U.S. GOVERNMENT PRINTING OFFICE

1900
County of
1900

1957-1958

17. The undersigned hereby certify that
18. the information indicated by 6" 1" or 2"
19. is correct.

contour interval indicated by 0, 1, or 2 contours, and elevations shown hereon

represent an actual field survey made by
11/27 day of Feb 1986

and that the elevations were taken at

appropriate intervals and that as of that date no new provisions existed as indicated hereon."

CONFIDENTIAL
10/1/11
202 4/23/13

1987-1988

10
