


SITE PLAN
FOR
MICHAEL SCHAFER
KNOWN AS BEING PART OF LOT 2, TRACT 3
IN RANGE 6, TOWNSHIP 11 OF THE
CONNECTICUT WESTERN RESERVE

COUNTY OF LAKE STATE OF OHIO
TOWNSHIP OF MADISON

REVIEWED AND ACCEPTED
LAKE COUNTY GENERAL
HEALTH DISTRICT
Date: 3-21-02
David B. Jones R.S.
SEWAGE DISPOSAL PERMIT MUST BE
OBTAINED BY A LAKE COUNTY LICENSED
INSTALLER BEFORE INSTALLATION IS
STARTED




- NOTES: 1) WATER SAVING TOILETS AND SHOWER
HEADS TO BE INSTALLED.
2) DOWNSPOUTS AND FOOTER DRAINS TO
BE DIRECTED AWAY FROM SEPTIC SYSTEM.
3) BACKFILL FOR HOUSE TO COME FROM ON-SITE.

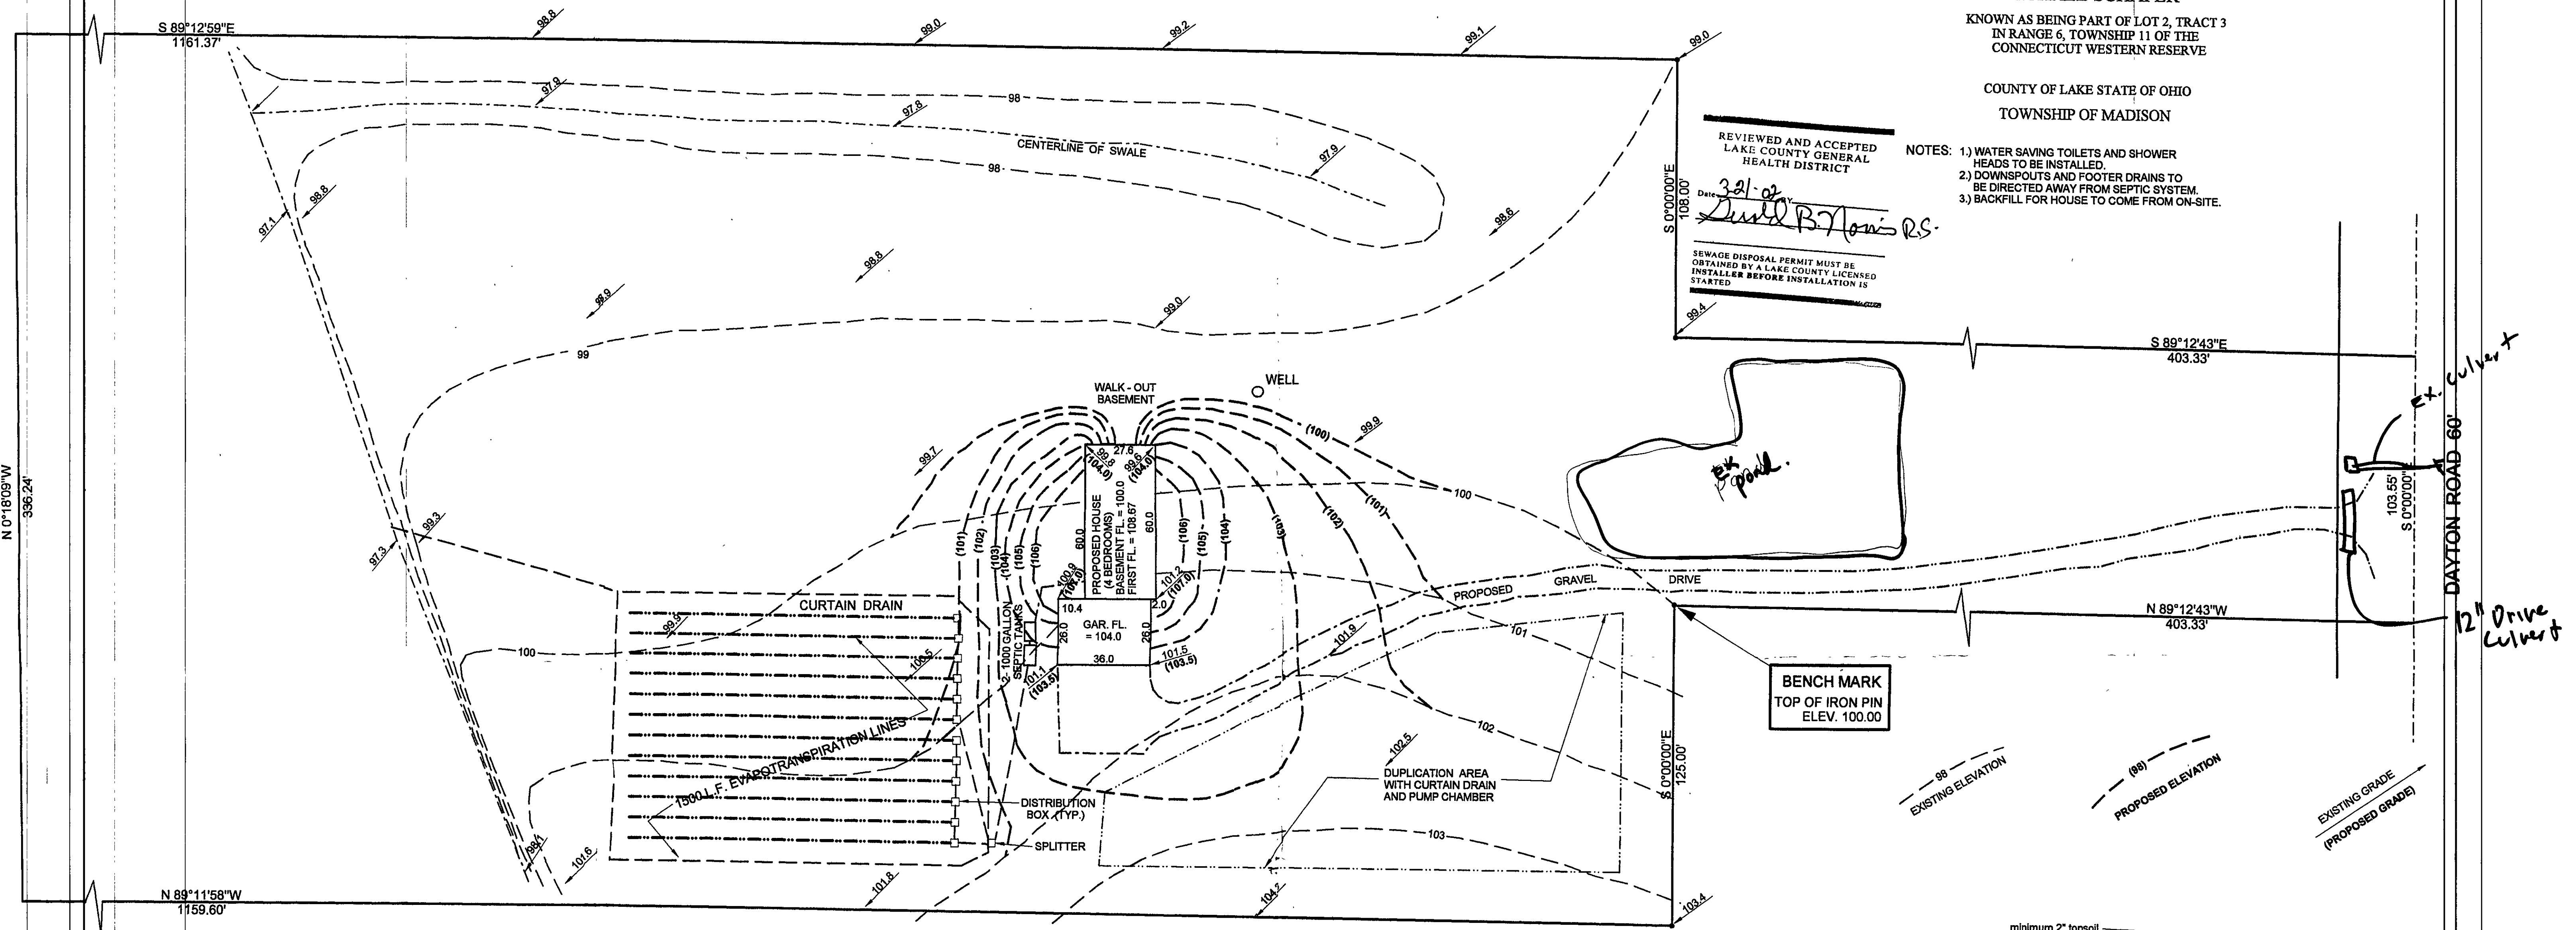

"I, THE UNDERSIGNED HEREBY CERTIFY THAT THE TOPOGRAPHY SHOWN HEREON, INDICATED BY 1 FOOT CONTOURS AND ELEVATIONS REPRESENTS AN ACTUAL FIELD TOPOGRAPHIC SURVEY MADE BY ME ON THE 8th DAY OF FEBRUARY, 2002 AND THAT THE ELEVATIONS WERE TAKEN AT APPROPRIATE INTERVALS AND THAT AS OF THAT DATE THEY EXISTED AS INDICATED HEREON".


James A. Ziemba
JAMES A. ZIEMBA, PROFESSIONAL SURVEYOR #7094
STATE OF OHIO
JAMES A. ZIEMBA
7094
PROFESSIONAL SURVEYOR

428-8599
BENCHMARK SURVEY COMPANY
5944 SOUTH RIDGE ROAD
MADISON, OHIO 44057-9741
FEBRUARY 8, 2002

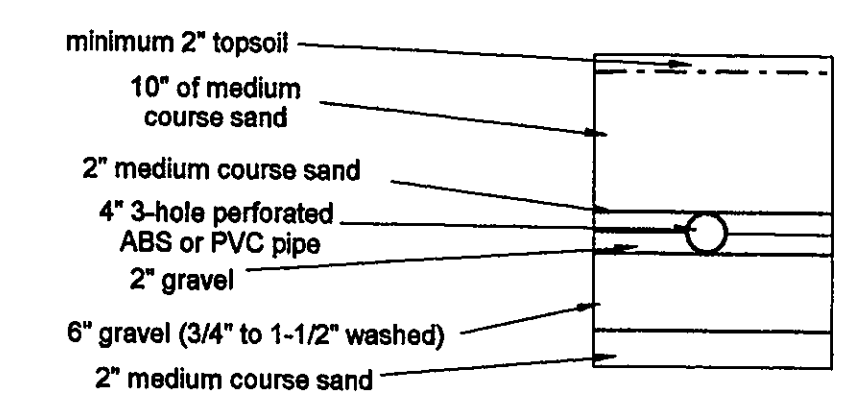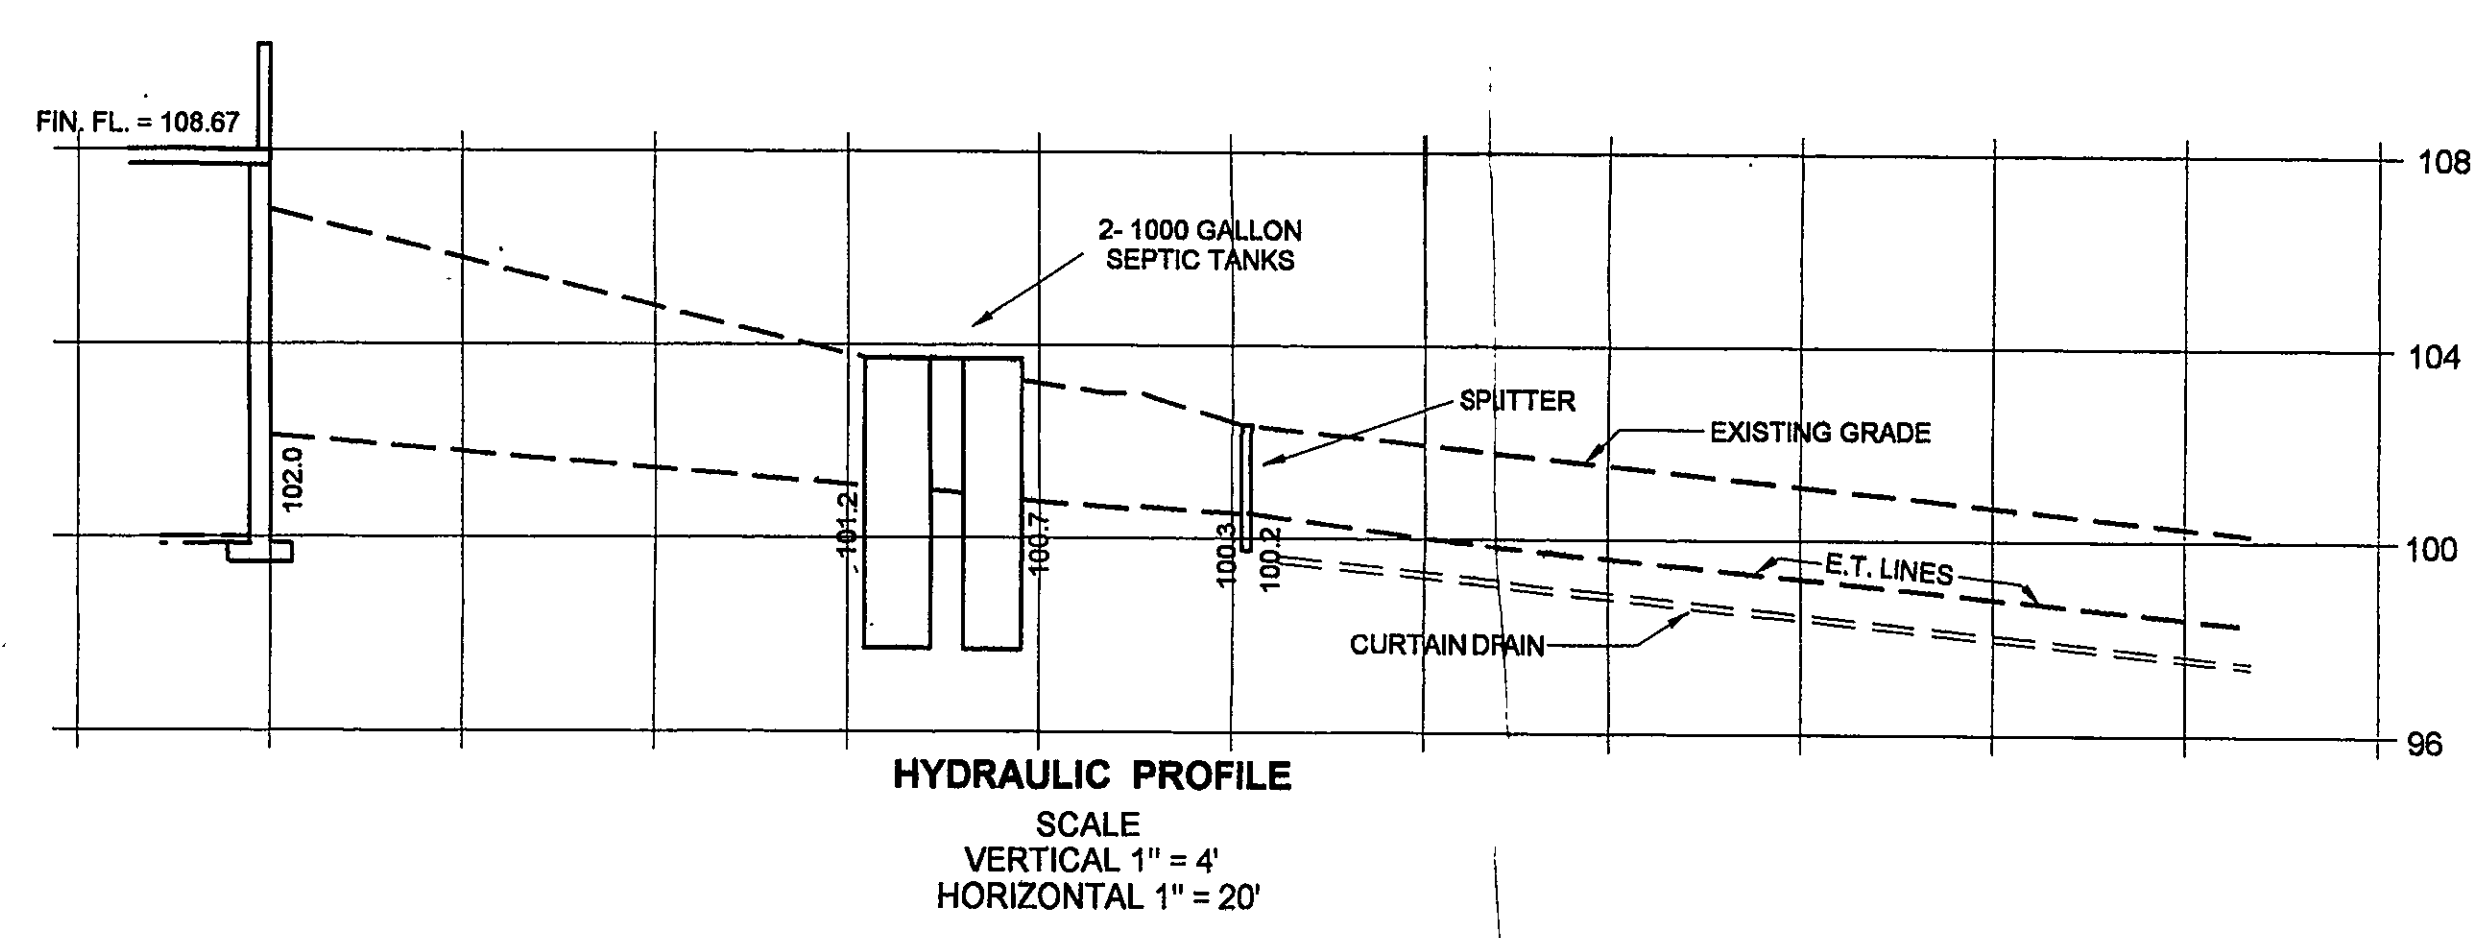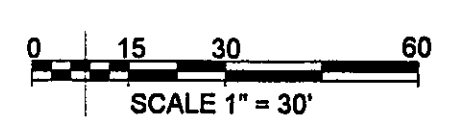

TYPICAL EVAPOTRANSPIRATION
TRENCH CROSS SECTION

APPROVED
MADISON TOWNSHIP ZONING
DATE: 4/1/02
BY: Dm 20814

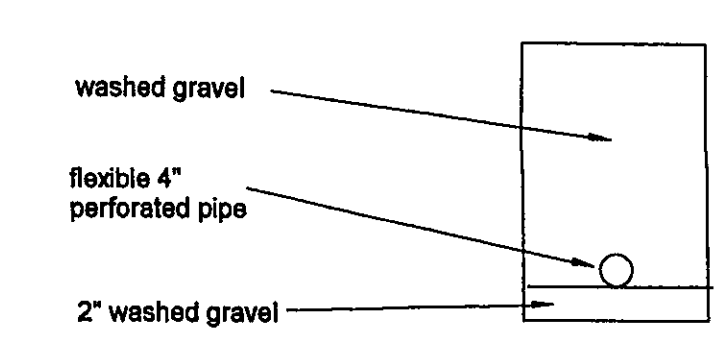

TYPICAL CURTAIN DRAIN
CROSS SECTION

Grading Plan Approved
as shown and/or noted
JAMES R. GILS, P.E.
Lake County Engineer
By: G.H. Date: 04/05/02
as noted.