


IMPROVEMENT PLAN

RTIS

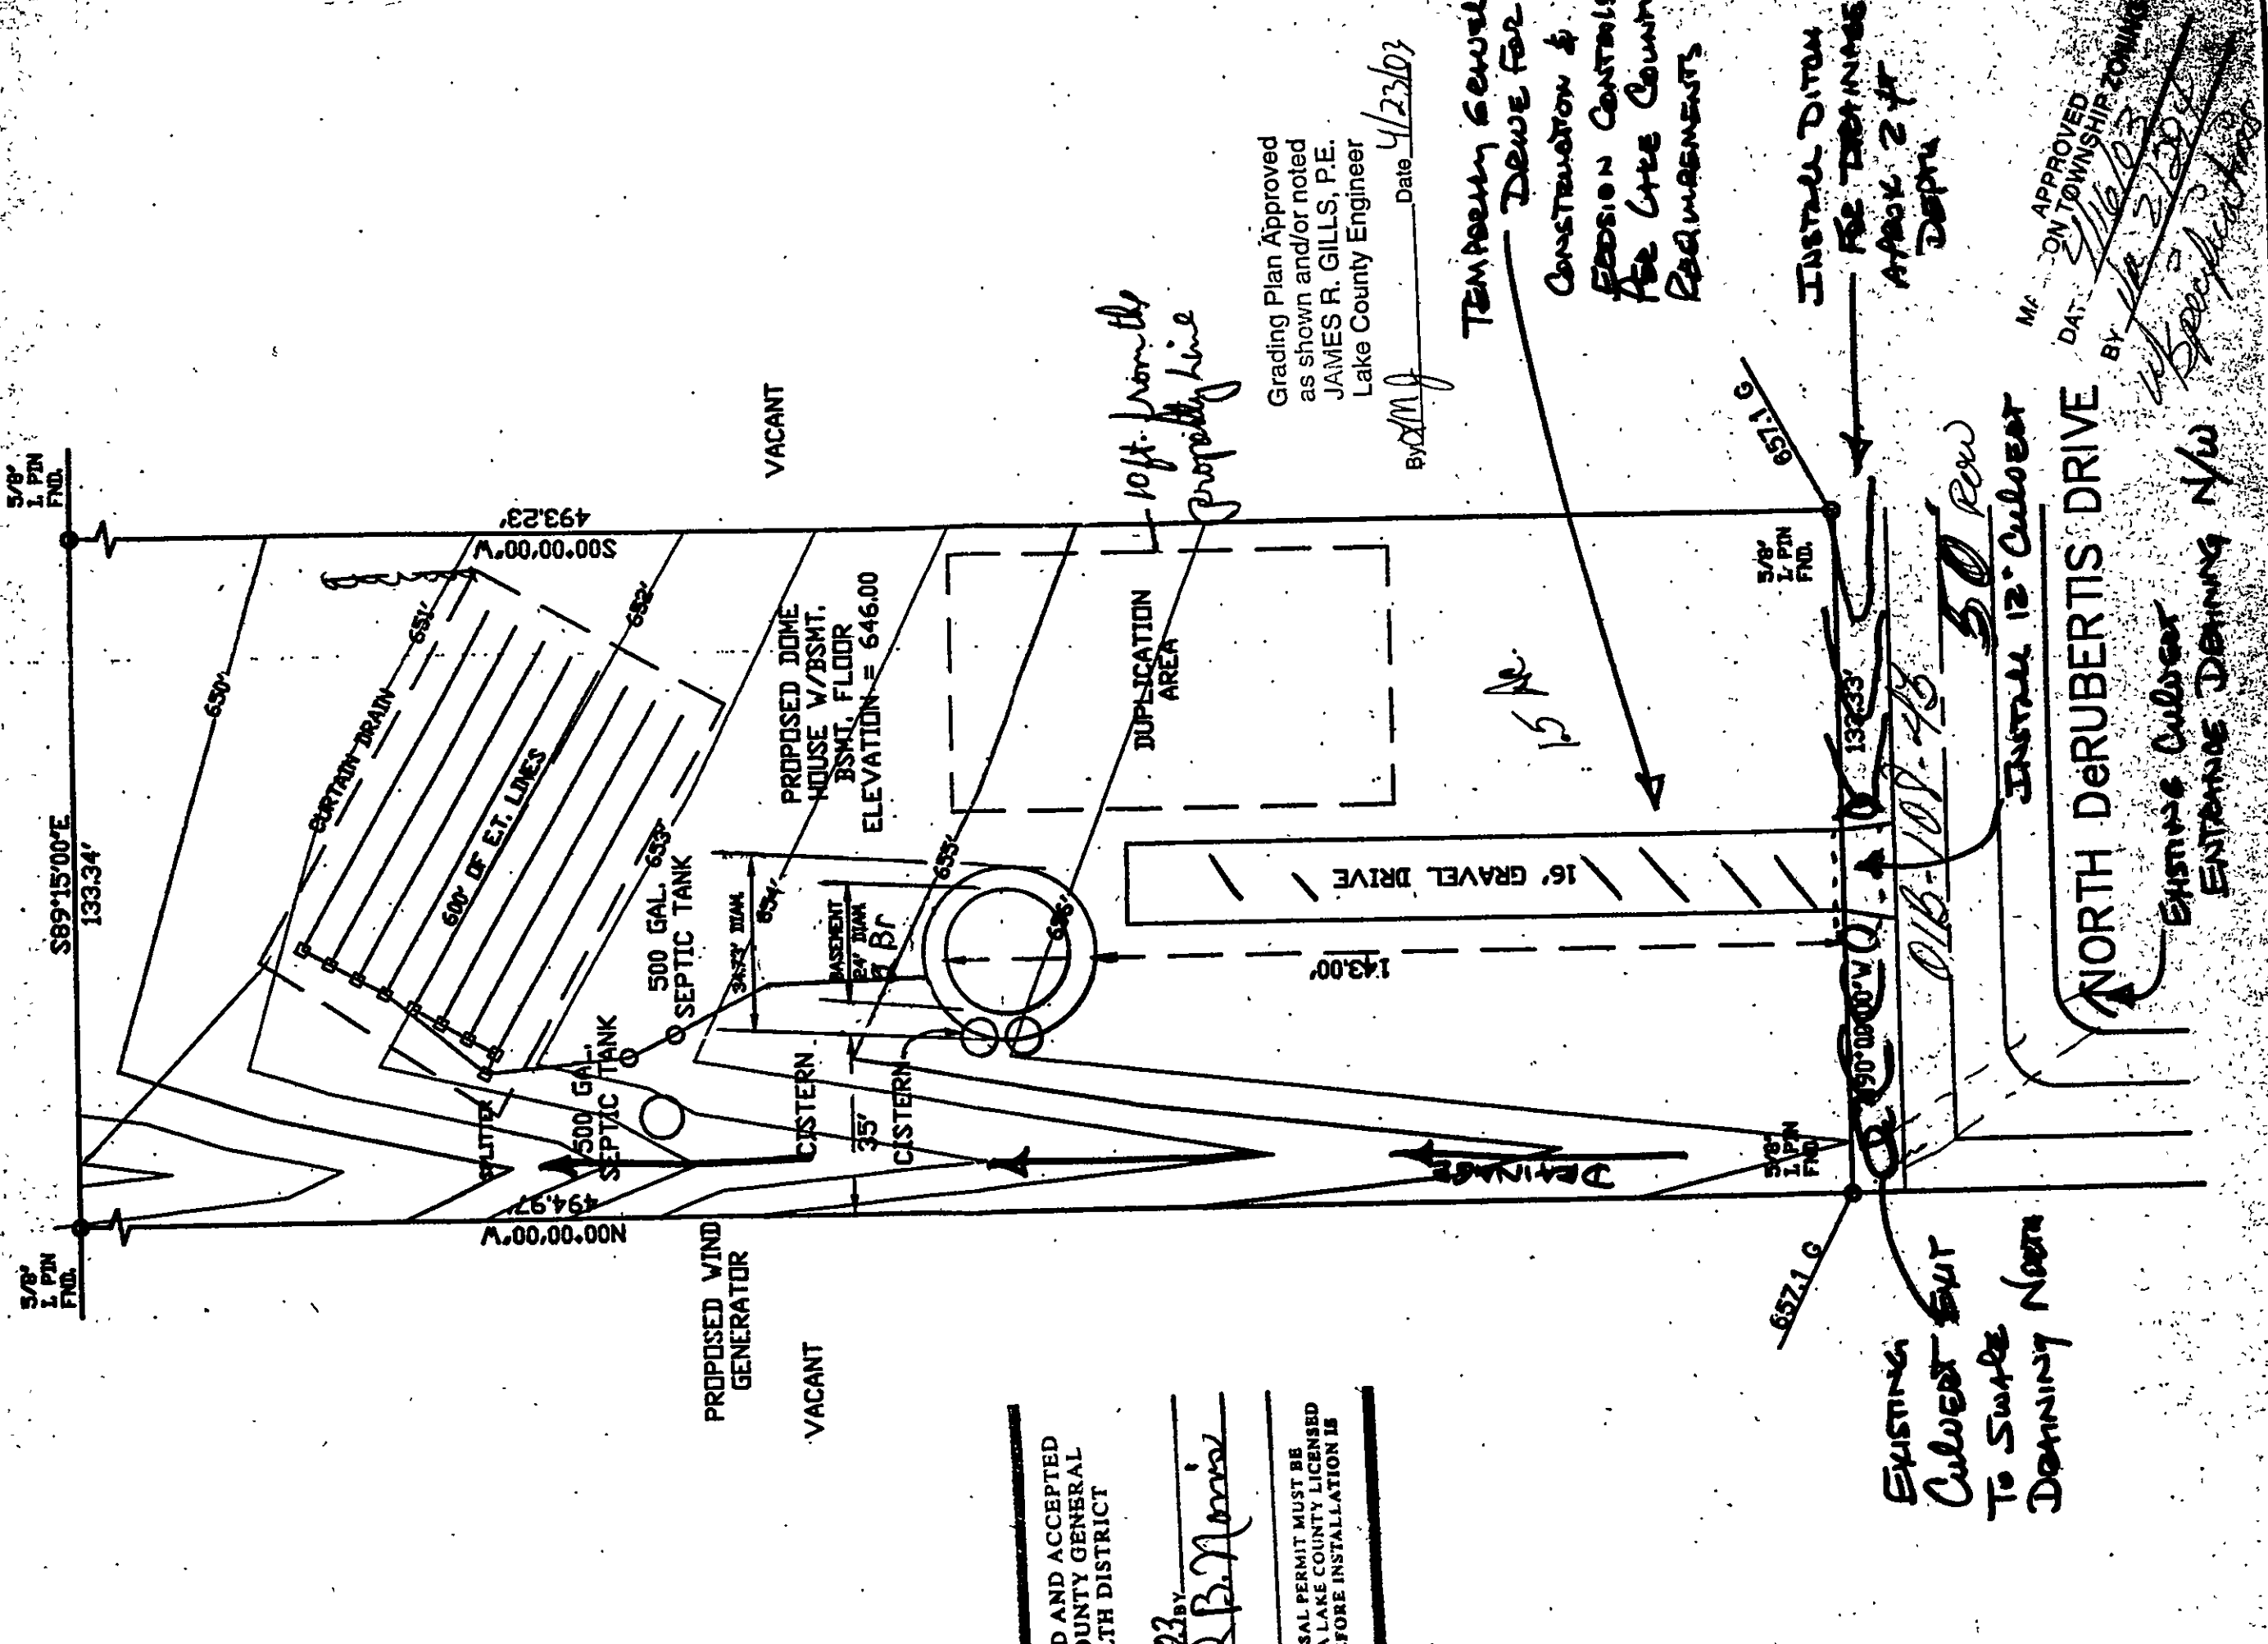

D AND ACCEPTED
UNTY GENERAL
TH DISTRICT

23 BY
B. Morris

SAL PERMIT MUST BE
LAKE COUNTY LICENSED
FORE INSTALLATION IS

Grading Plan Approved
as shown and/or noted
JAMES R. GILLS, P.E.
Lake County Engineer

By *JMG* Date *4/23/03*

TEMPORARY GULCH
DEWE FOR
CONSTRUCTION &
EROSION CONTROLS
FOR LAKE COUNTY
REQUIREMENTS

EXISTING
CULVERT BUT
TO SWALE
DRAINING NORTH

INSTALL DITCH
FOR DRAINAGE
APPROX 2 ft
Depth

INSTALL 12" CULVERT

NORTH DERUBERTIS DRIVE

EXISTING CULVERT
ENTRANCE DRAINING N/W

APPROVED
ON TOWNSHIP ZONING
DATE *5/16/03*
BY *JMG*
4/23/03
Speculation