

EXIST. SHED.

Grading Plans Approved
as shown and/or noted
THOMAS P. GILLES, P.E.
Lake County Engineer


By 611+ Date 10 1894

NOTE:

SETBACKS OF EXISTING HOMES ON EAST SIDE DIVISION ROAD

12'
19.5'
20'
20'
60.5'
20'
25'
24.7'
21.5'
17.5'

AVG. = 24 ft.

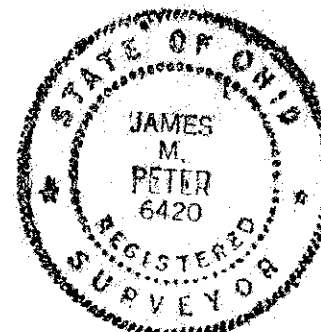

JM Peter

SITE PLAN

FOR
DONALD GESDORF

LOT 27 SHORE ACRES ALLOT.
TRACT 1 LOT 17 MADISON TWP.
LAKE CO. O.

26 SEPT. 1994

SCALE 1" = 10 ft

JIM PETER LAND SURVEY
4759 CROSBY-COOK Rd.
ROME, OHIO 44085

DWG NO. 940914