
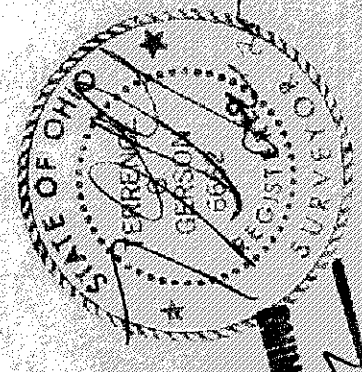


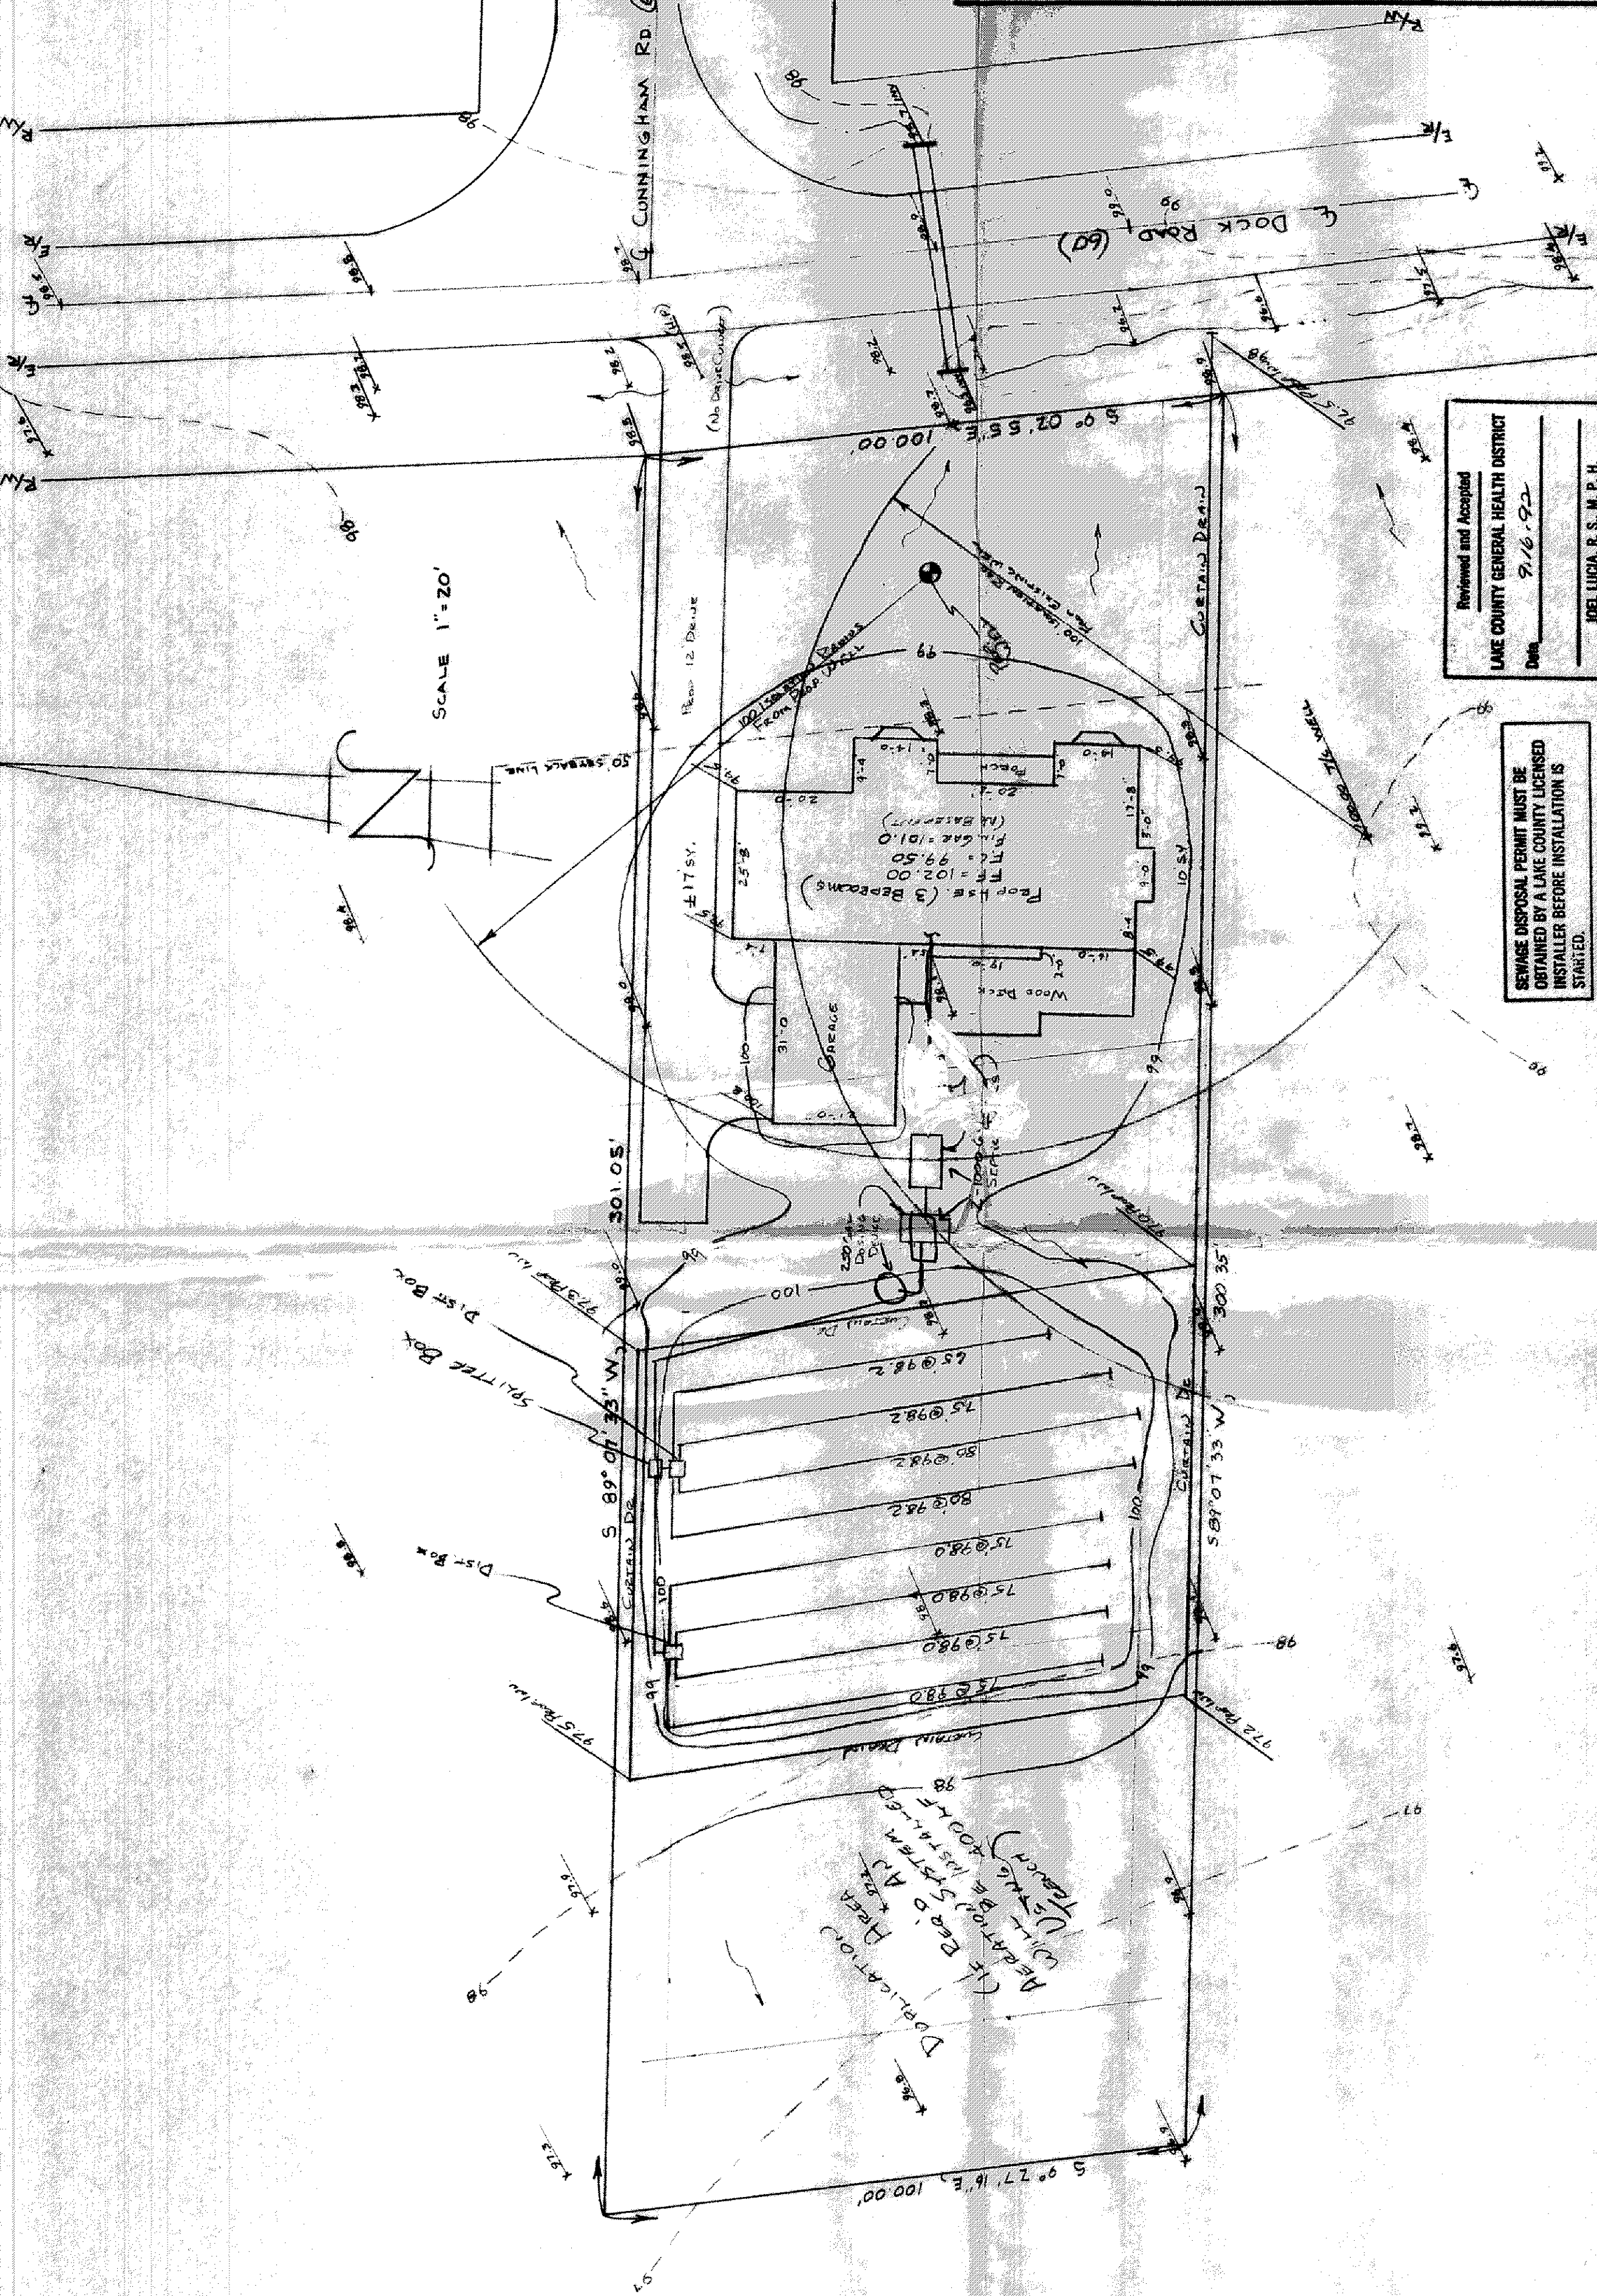

APPROVED
HARRISON TWP. ENGINEER
DATE: 9/16/92
BY: [Signature]
SEPT 21 1992 SITE PLAN, TOWN & SEWAGE SYSTEM BY Wm R Gray
Assoc. Boundary Survey
By R.C. Dillworth, C.E.B.S.
SURVEYING SERVICE

Reviewed and Accepted
LAKE COUNTY GENERAL HEALTH DISTRICT
Date: 9/16/92
BY: JOEL LUCIA, R.S., M.P.H.
Health Commissioner
BY: [Signature]

SEWAGE DISPOSAL PERMIT MUST BE OBTAINED BY A LAKE COUNTY LICENSED INSTALLER BEFORE INSTALLATION IS STARTED.

- LOW YIELD WATER FIXTURES REQUIRED ON ALL:
- Shower Head
 - Toilet

- A. To be brought to finished grade
1. Septic tank manhole covers
 2. Splitter box cover
 3. Distribution box cover
- B. No footer drains or downspouts to be discharged into septic tanks
- C. All waste water to be discharged into septic tanks

"I, the undersigned hereby certify that the topography shown herein, indicated by one foot contours and elevations represents an actual field topographic survey made by me on the 10th day of August, 1992, and that the elevations were taken at appropriate intervals and that as of that date they existed as indicated herein."

Thomas P. Gilles
Registered Surveyor
PS 14616 Z
Reg. No.

Grading Plan Approved as shown and/or noted
THOMAS P. GILLES, P.E.
Lake County Engineer
By: [Signature] Date: 12/2/92