


Seeding Dates	Species	Lb./1,000 ft. <sup>2</sup>	Per Ac.
March 1 to August 15	Oats Tall Fescue Annual Ryegrass	3 · 1 1	4 bushel 40 lb. 40 lb.
	Perennial Ryegrass Tall Fescue Annual Ryegrass	1 1 1	40 lb. 40 lb. 40 lb.
August 16 to November 1	Rye Tall Fescue Annual Ryegrass	3 1 1	2 bushel 40 lb. 40 lb.
	Wheat Tall Fescue Annual Ryegrass	3 1 1	2 bushel 40 lb. 40 lb.
	Perennial Ryegrass Tell Fescue Annual Ryegrass	1 1 1	40 lb. 40 lb. 40 lb.



NATURE CONSERVANCY VOL. 897 - PG. 182 1A-89-37

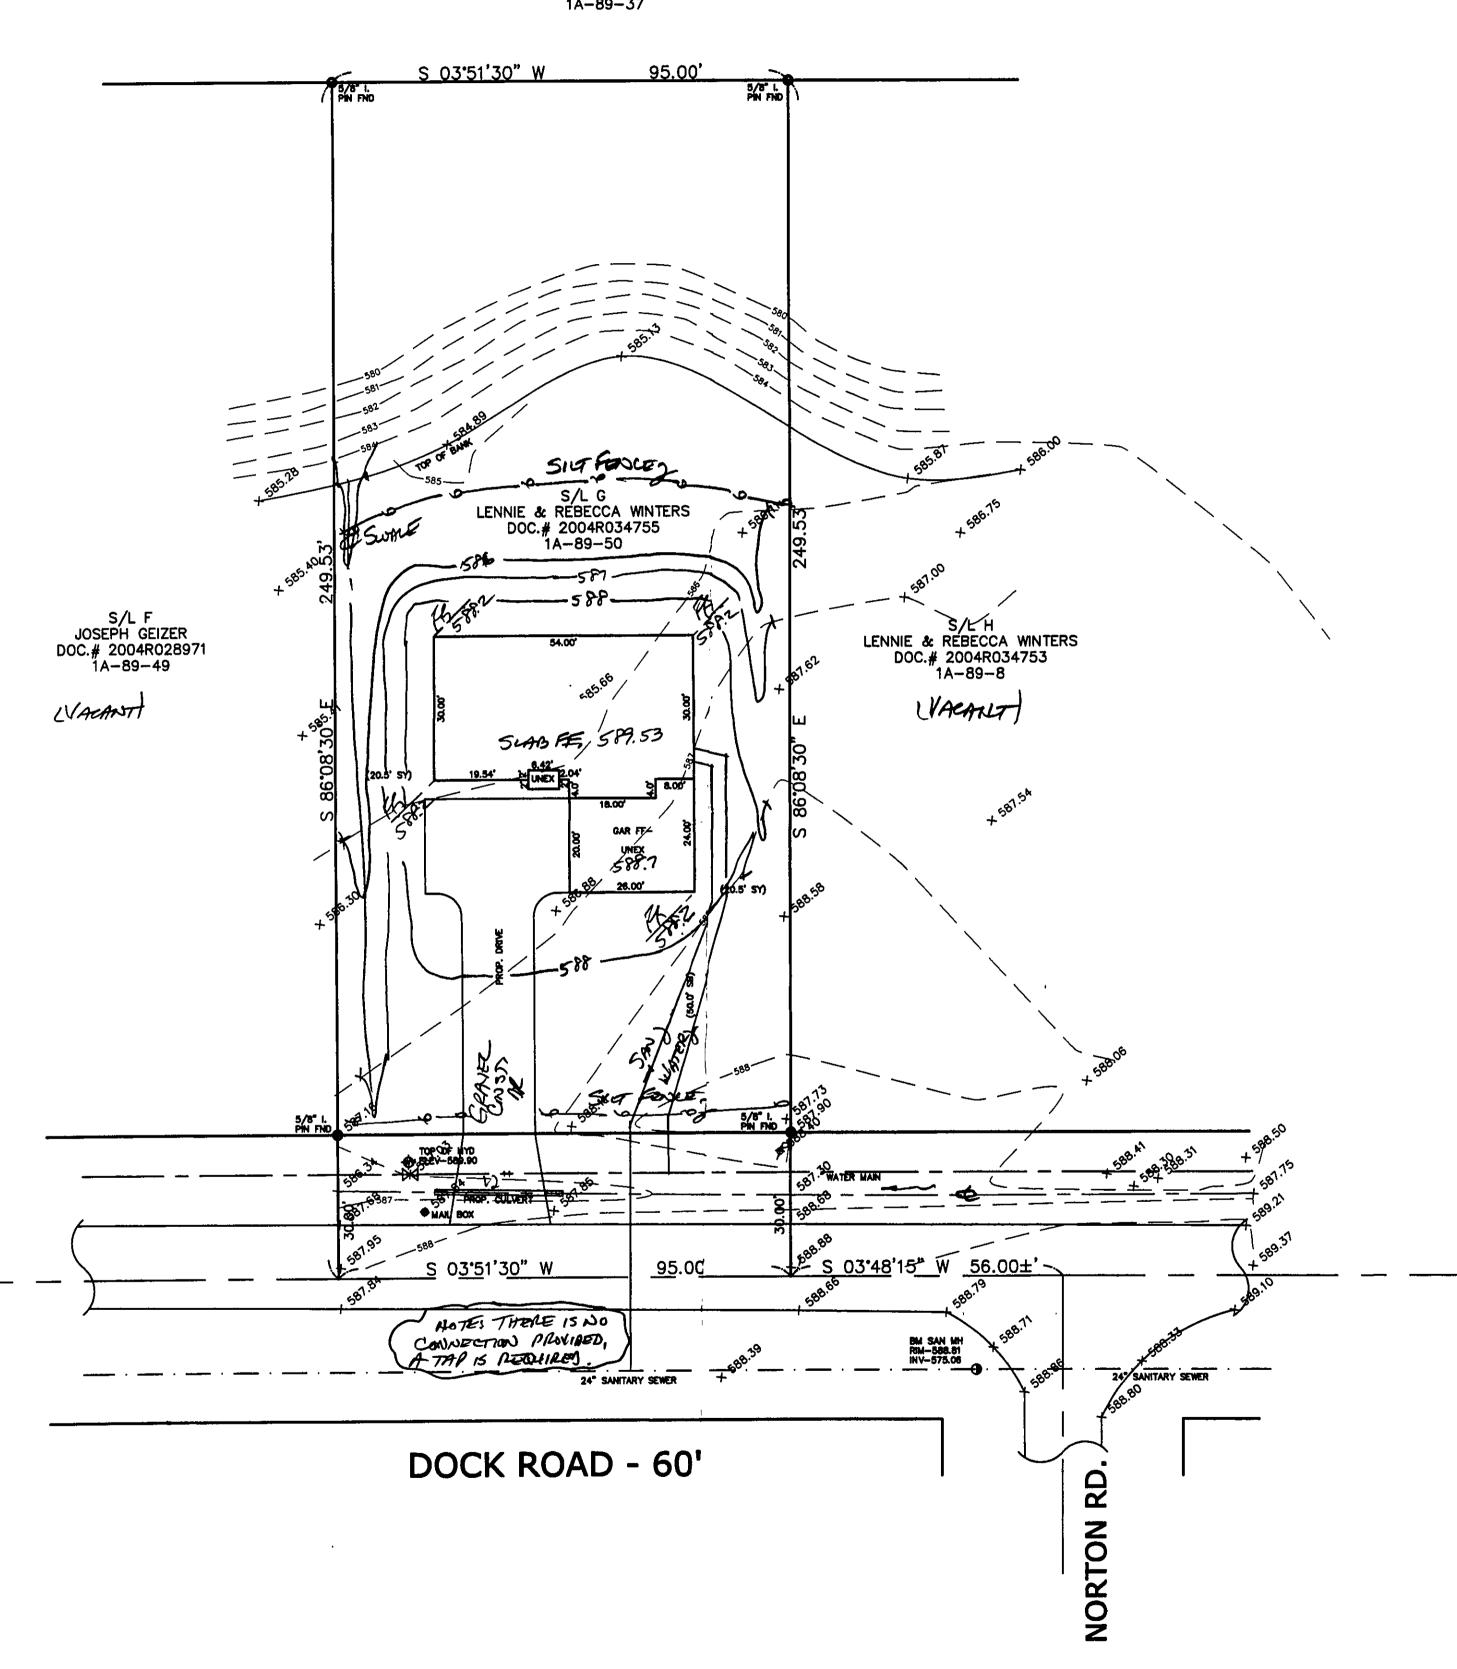

# Erosion and Sediment Control Schedule

Ingress—Egress
A stone access drive complete with under lying geo—textile fabric (20 feet wide and 50 feet long) for ingress and egress at the site shall be installed. This drive shall be only entrance and exit to the site.

Silt Fence
A silt fence shall be installed prior to any earthwork activities at the site in the locations shown on the site plan as well as along the front of any lot that slopes towards the street.

Temporary Seeding
Disturbed areas of the site that are to remain idle for more than thirty(30) days shall be properly seeded and straw mulched within seven(7) days of completion of initial grading.
Temporary seeding and mulching over a thirty(30) foot stirp of the entire front of the lot shall be maintained on the site once initial grading is complete.

Stabilization of critical areas within fifty(50) feet of any stream or wetland shall be complete within two(2) days of the disturbance if the site is to remain inactive for longer than fourteen(14) days.

Mulching
Straw—mulch shall be applied at a rate of 1 bale per every ten
(10) feet of curb, at a width of thirty(30) feet to the entire
length of the lot. Wood chips may also be used but must be
spread at a minimum depth of four inches over the thirty—foot
width and must be accompanied by a properly installed silt

Erosion and sediment controls shall be inspected every seven(7) days with 24 hours of a 0.5" or greater rainfall event.

Necessary repairs shall be made at this time.

"I, the undersigned hereby certify that this topography indicated by 6", 1', or 2' contours, and elevations shown hereon represent an actual field survey made by me on the //12 day of 105,2004 and that the elevations were taken at appropriate intervals and that as of that date they existed as indicated hereon."

Stormwater Management Plan Approved as shown and/or noted JAMES R. GILLS, P.E. County Drainage Engineer By 6.14 Date 9.3.4

☐ Zoning Department
☐ 17 Conoral Health District Section 16. A compression District ROOF DRAINS
SHALL DISCHARGE
TO SPLASH BLOCKS.

STATE OF OHIO

BM SANITARY MANHOLE 588.81

EXISTING UTILITIES NOTE:
THE SIZE AND LOCATION, BOTH HORIZONTAL AND VERTICAL
OF THE UNDERGROUND UTILITIES SHOWN HEREON, HAVE BEEN
OBTAINED BY A SEARCH OF AVAILABLE RECORDS.
VERIFICATION BY FIELD OBSERVATION HAS BEEN CONDUCTED
WHERE PRACTICAL, HOWEVER, BABCOCK, JONES AND ASSOCIATES
MADIBON TOWNSHIP ZINGLES NOT GUARANTEE THE COMPLETENESS NOR ACCURACY
THEREOT.

REV NO.	DESCRIPTION	DATE	BY	CHK'D

BABCOCK, JONES AND ASSOCIATES, INC CIVIL ENGINEERS - SURVEYORS - LAND PLANNERS

> PAINESVILLE OHIO 44077 PHONE: 440-357-1811 FAX: 440-357-9173

_	DATE	8/13/04	
_	DESIGN BY	HJ	
	DRAWN BY	NS	
	APPROVED BY	HJ	

BY DU ZDOW

MADISON TOWNSHIP

SITE PLAN FOR

LENNIE & REBECCA WINTERS S/L G DOCK ROAD PARCEL NO. 1A-89-50

LAKE COUNTY

1"=20' 04-200