

SITE PLAN HIGHSIDE MECHANICAL
SUBLOT 120 MADISON BEACH SUBDIVISION
VOL. F - PG. 47 MADISON TWP.


12/4/95

B.M. TOP STORM INLET
145' SOUTH OF SOUTH LINE OF
SUBLOT 120 - 20' EAST OF
CENTERLINE = 100.00

● IRON PIN

Planning Plan Approved
THOMAS P. GILLES, P.E.
Storm and/or Road
Design Engineer
6 JH
12 795

EXTEND SWALES TO DORCHESTER ROAD

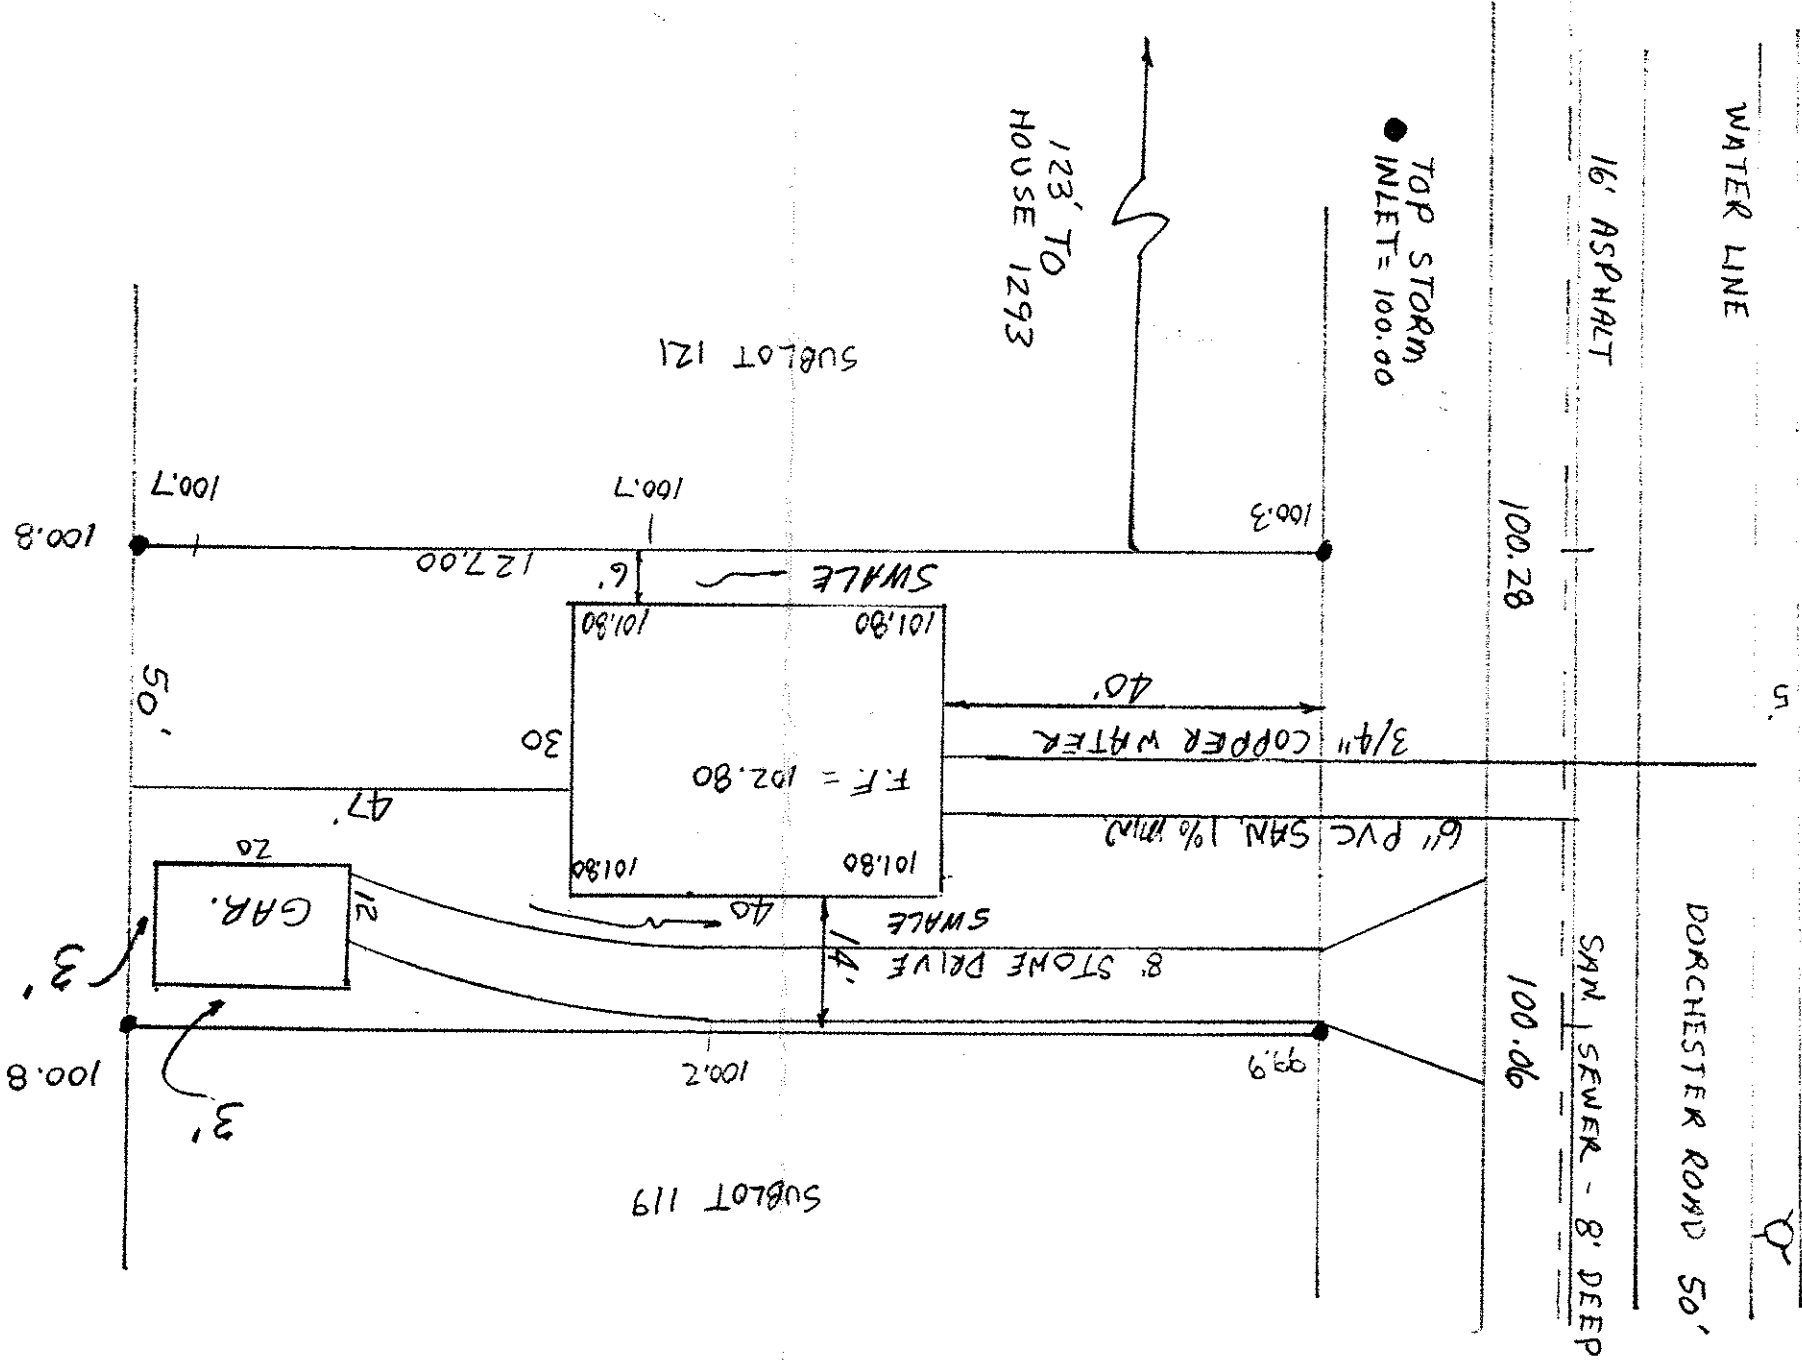

APPROVED
MADISON TOWNSHIP ZONING
DEC 05 1995
PERMIT # 14806
ZONING INSPECTOR