


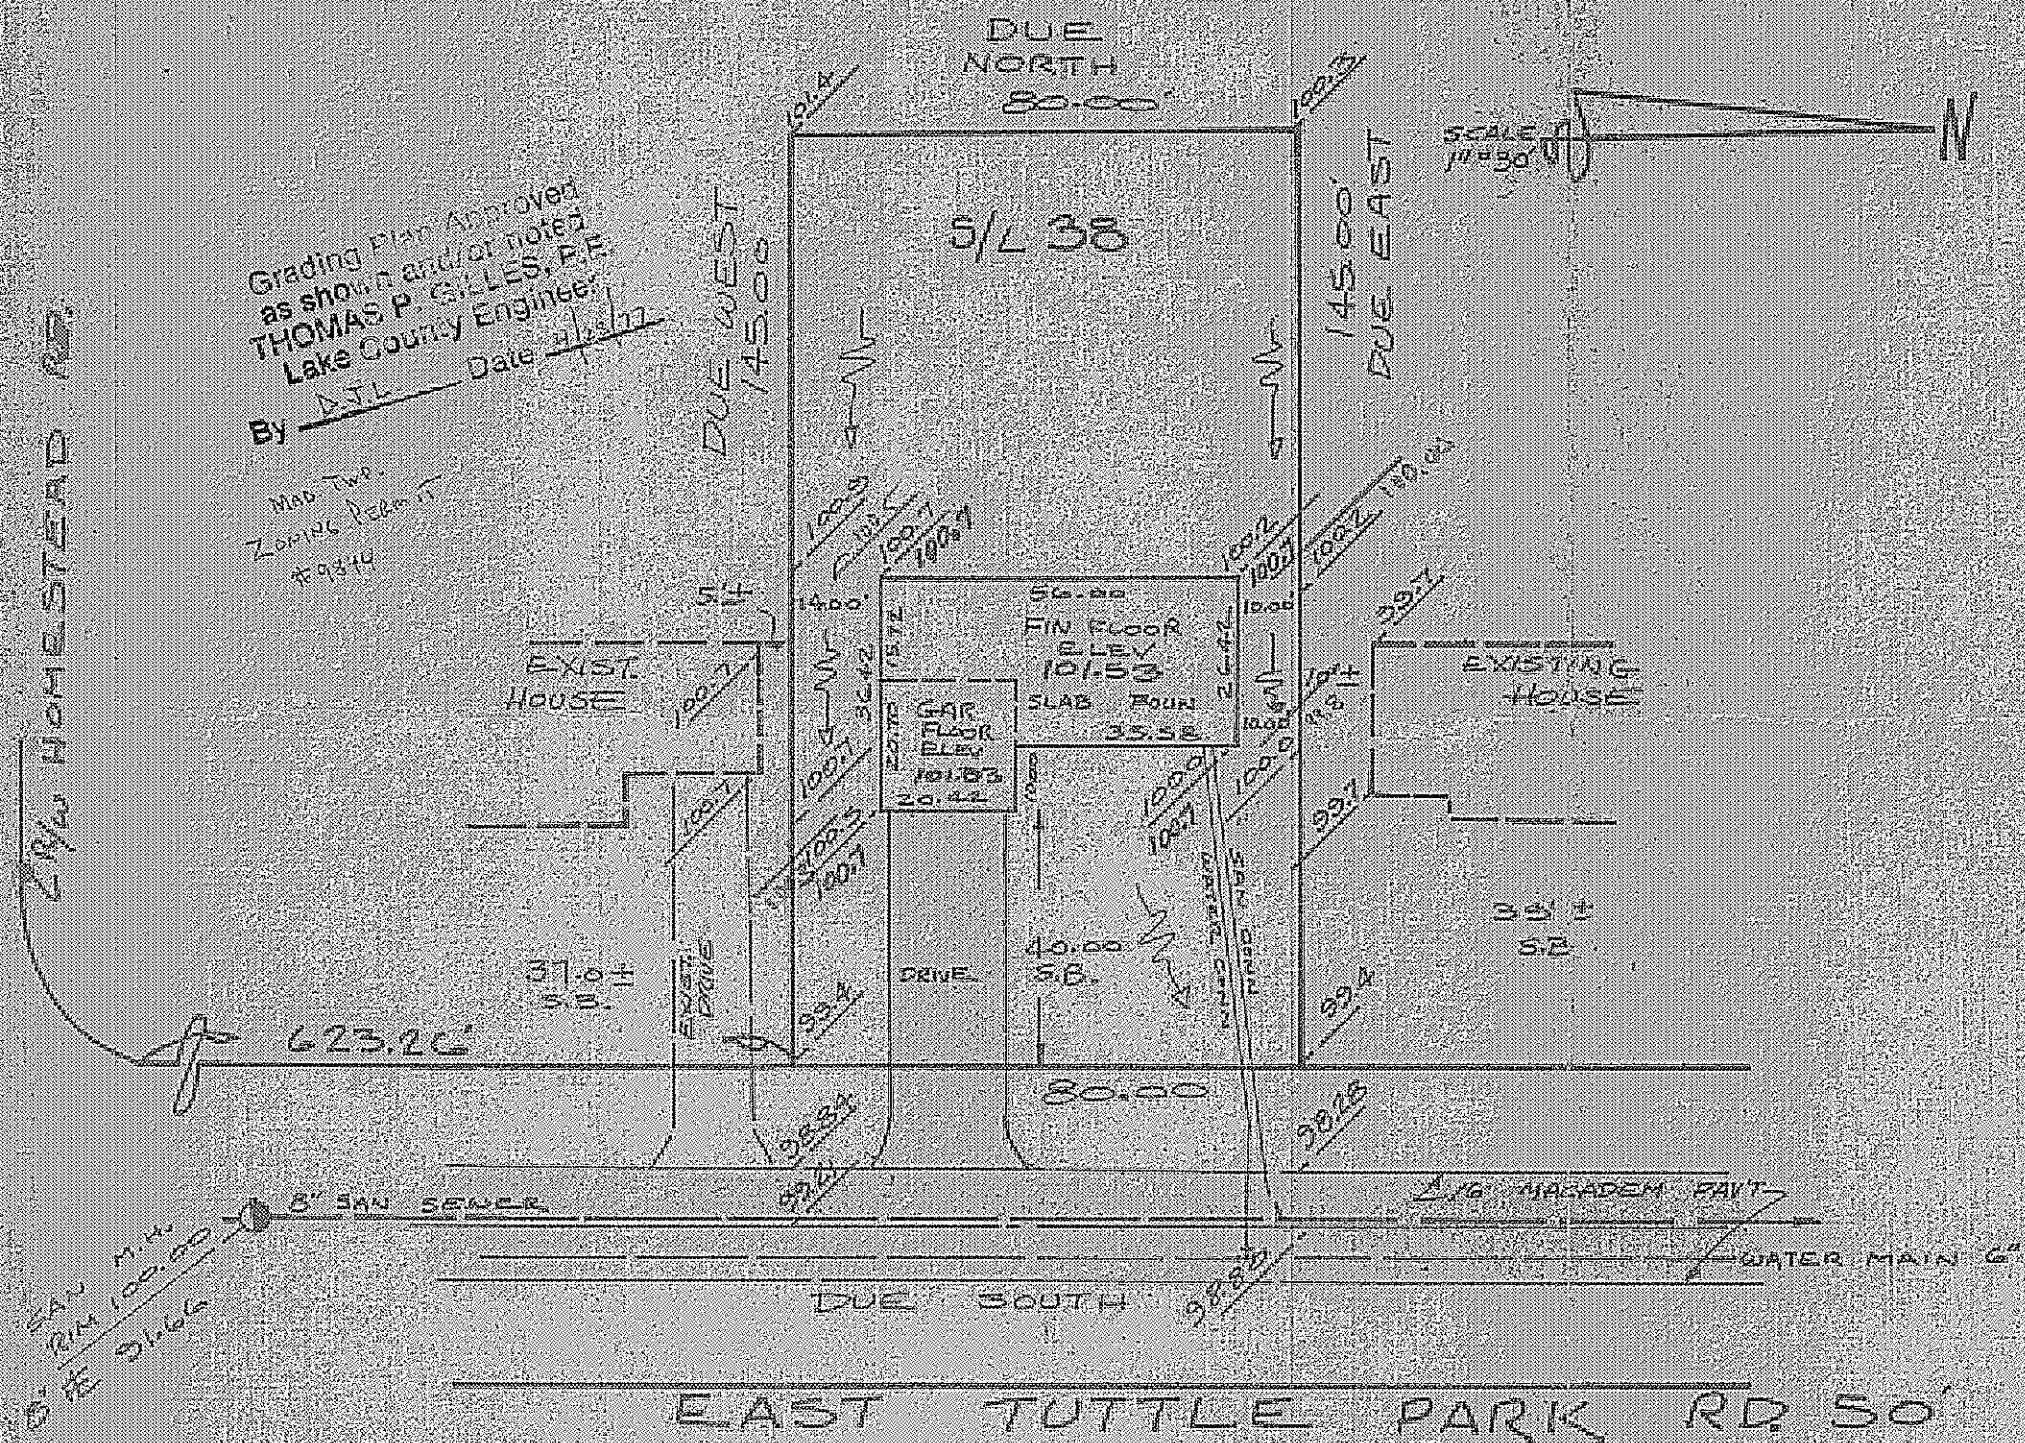

Grading Plan Approved
as shown and/or noted
THOMAS P. GILLES, P.E.
Lake County Engineer
By D.J.L. Date 4/16/17
Map Two
Zoning Permit
#9340

SITE PLAN

MADISON LAKE COUNTY, OHIO

TOWNSHIP

for: NAUGHTON ELDERS, INC.

CLIENT OWNER

691 W. MAIN ST. MADISON, OH

ADDRESS STREET CITY ZIP

NORTHERN LIGHTS SUBD

SUBDIVISION 6-80 NAME

38 VOL.-PG. EAST TUTTLE

SUBLOT NO. STREET

LOT

TRACT

VOLUME

PAGE

PERM. PARCEL NO.

STREET

LEGEND

SANITARY MANHOLE

STORM MANHOLE

INLET OR CATCH BASIN

HYDRANT

EXISTING CONTOURS

PROPOSED CONTOURS

EXIST. ELEV. 100.0

100.0 PROP. ELEV.

WATER VALVE (GAS)

WATER METER (GAS)

AS-BUILT ELEVATION

INDICATES DIRECTION OF SURFACE DRAINAGE

REMARKS

ALL BOUNDARY DATA SHOWN WAS OBTAINED FROM IDEEDS, RECORDED SUBDIVISION PLAT OR OTHER PUBLIC RECORDS)

LOCATIONS AS SHOWN OF ADJACENT WELLS AND SEPTIC TANKS OBTAINED FROM LAKE COUNTY HEALTH DEPARTMENT

DESIGN CERTIFICATION

THIS PLAT WAS PREPARED BY ME, AND IS CORRECT TO THE BEST OF MY KNOWLEDGE AND BELIEF.

Rafael M. Brooks P.E. # 6166

NAME SURVEYOR REGISTRATION NO.

CHECK LIST

NO. OF BEDROOMS

DIMENSIONS

BEARINGS

TIE TO NEAREST STREET

SUBLOT NO. PARCEL NO.

SURROUNDING OWNERS

BLDG. DIMENSIONS FIN. GR.

BLDG. TIES FL'R. GRADES

APRON TYPE WIDTH THICKNESS

SIDEWALK TYPE WIDTH THICKNESS

CULVERT TYPE DIA. LENGTH

ROCK OUTCROPPINGS

WATER MAIN SIZE, LOCATION

SAN. SEWER SIZE % GR. LOC.

SAN. MH. CAST. ELEV. INV. ELEV.

SAN. CONN. SIZE LOC. DEPTH

STORM SEWER SIZE % GR. LOC.

STORM MH. CAST. ELEV. INV. ELEV.

PAV'T TYPE GRADE CURBS

GAS LINE LOC. SIZE PRESSURE

SEPTIC TANK LOCATION & DUPLICATION AREA

WELL LOCATION

ISOLATION RADIUS FROM WELL

REVISIONS

NO. DATE BY

1

2

3

4

5

DRAWN BY R.J.T.

SCALE 1"=30'

PHONE NO. 354-6040

CHK'D.

DATE 4/16/17

DRAWING NO.

CREW CHIEF H.W.

APP'D.

125