


Approved
Madison Township
Permit # 8314
Zoning Insp. OKB

Grade Plan Approved
as noted
Thomas P. Salas P.E.
Lake County Eng.
By TSB 19 April 72

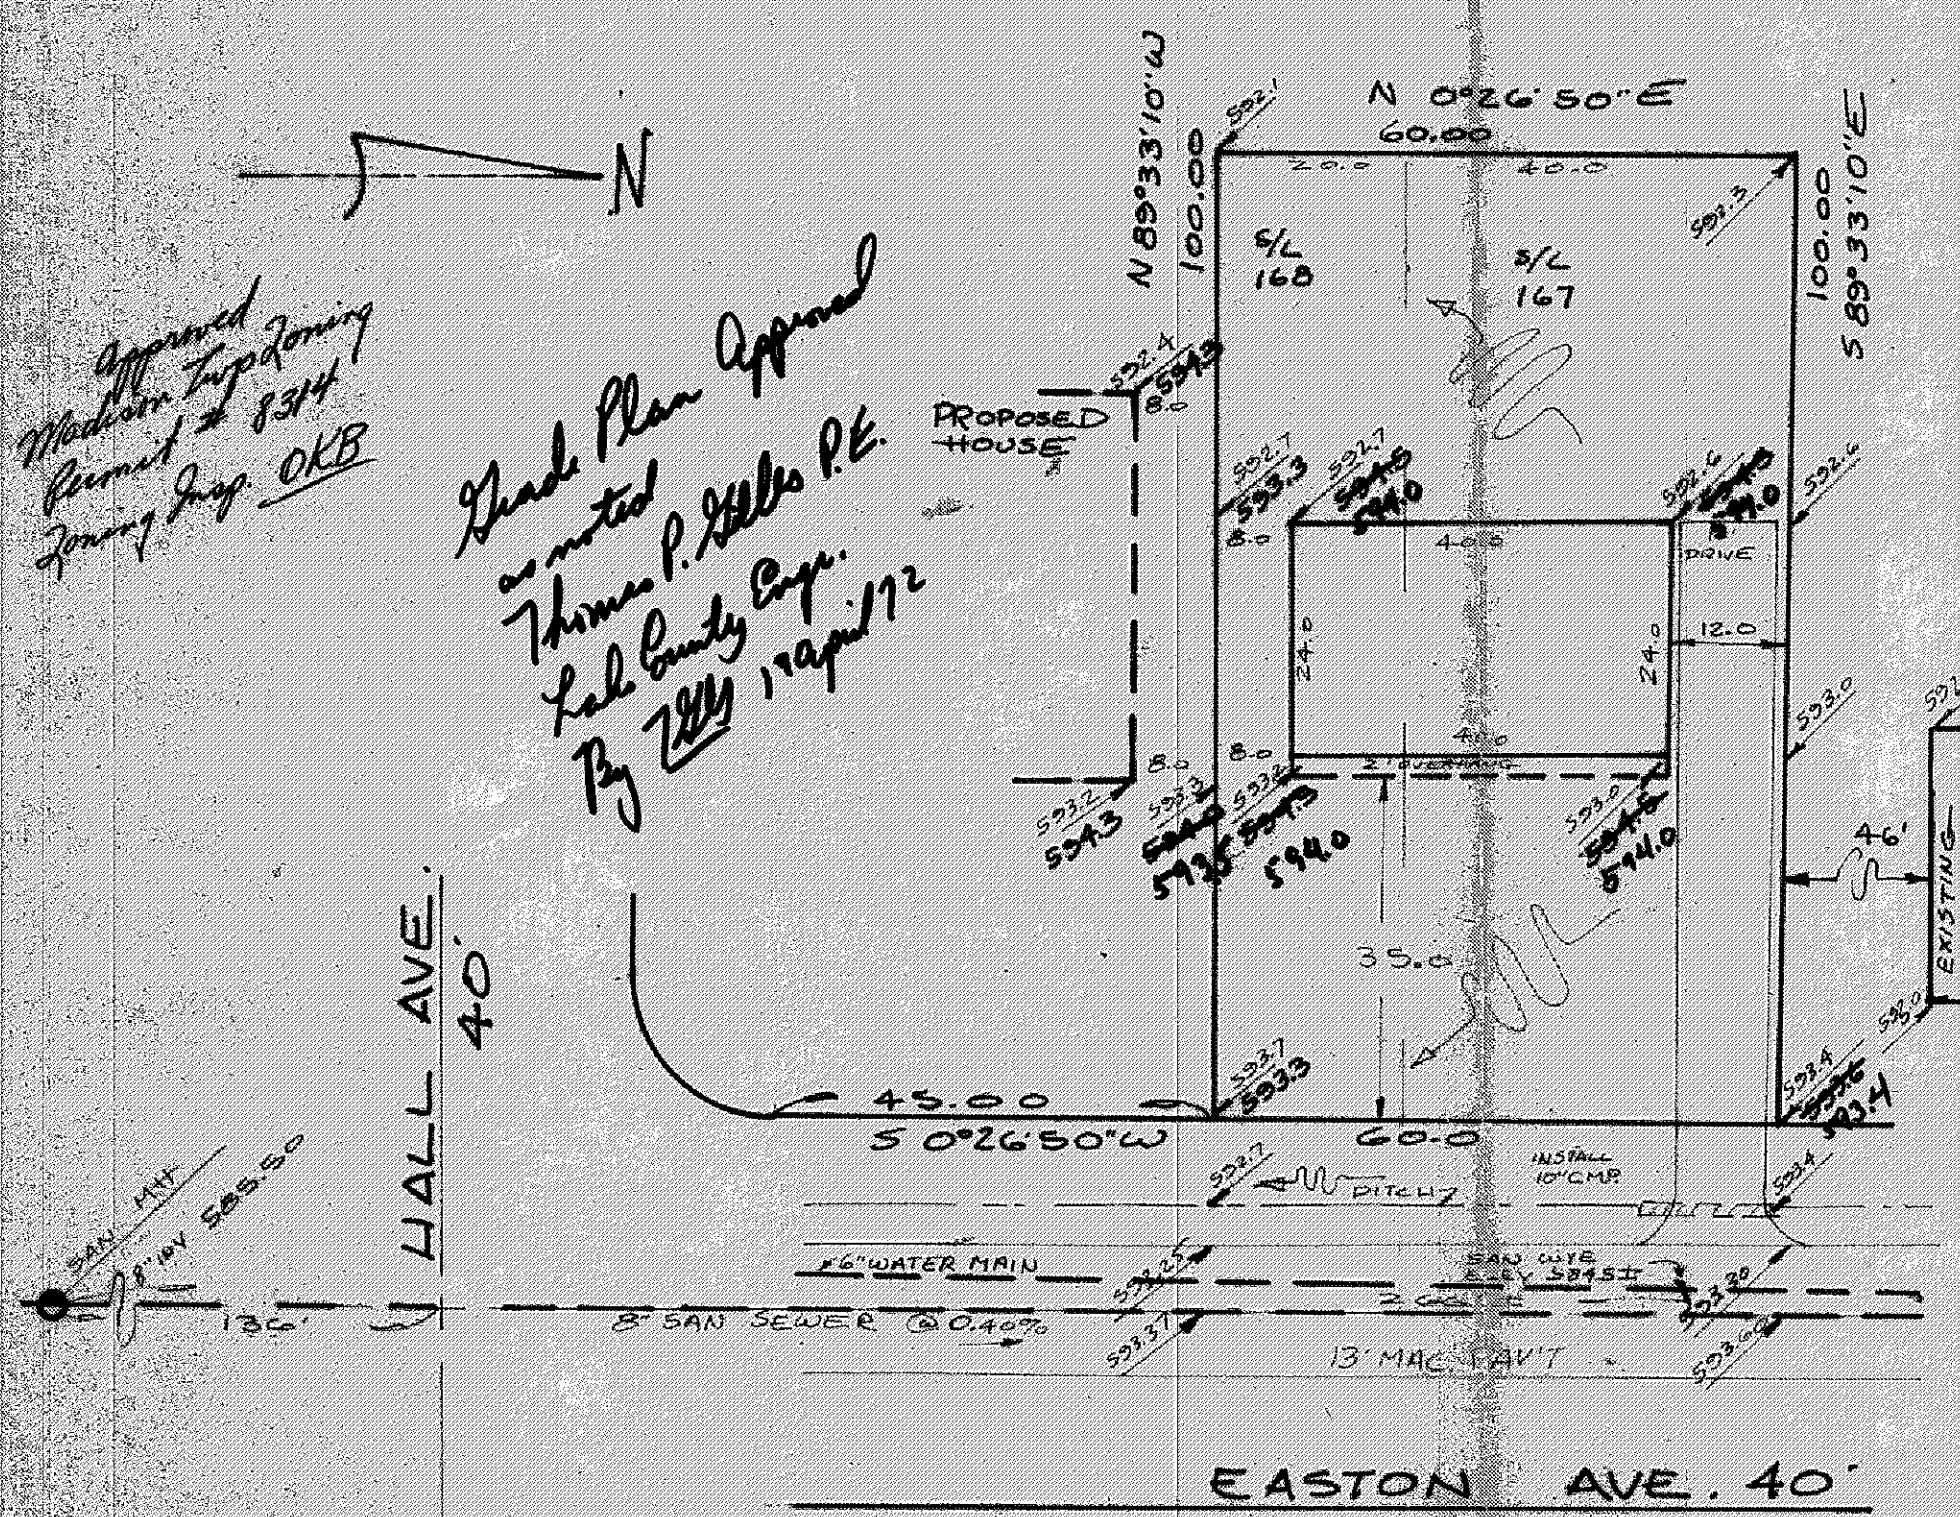

SITE PLAN

MADISON LAKE COUNTY, OHIO
TOWNSHIP
for: RYAN HOMES INC
1456 Easton Madison 44157
ADDRESS STREET CITY ZIP

MADISON LAKELANDS		LOT	TRACT
RECORD	SUBDIVISION		
D	27		
VOLUME	PAGE		
167-168	EASTON AVE		
SUBLOT NO	STREET		

LEGEND	
SANITARY MANHOLE	○
STORM MANHOLE	●
INLET OR CATCH BASIN	■
HYDRANT	◇
EXISTING CONTOURS	---
PROPOSED CONTOURS	---
EXIST ELEV	100.0
PROP ELEV	100.0
WATER VALVE (GAS)	+
WATER METER (GAS)	○
AS BUILT ELEVATION	○
DIRECTION OF SURFACE DRAINAGE	↓

REMARKS

ALL BOUNDARY DATA SHOWN WAS OBTAINED FROM (DEEDS, RECORDED SUBDIVISION PLAT, OR OTHER PUBLIC RECORDS)

DESIGN CERTIFICATION

THIS PLAT WAS PREPARED BY ME, AND IS CORRECT TO THE BEST OF MY KNOWLEDGE AND BELIEF.

Richard J. Bilek PS # 5244
NAME SURVEYOR REGISTRATION NO.

CHECK LIST	
DIMENSIONS	WATER MAIN SIZE LOCATION
BEARINGS	SAN SEWER SIZE % GR LOC
TIE TO NEAREST STREET	SAN METER EAST ELEV. BY ELEV.
SUBLOT NO. PARCEL NO.	SAN CONE SIZE LOC. DEPTH
SURROUNDING OWNERS	STORM SEWER SIZE % GR LOC
BLDG DIMENSIONS FIN OR	STORM METER EAST ELEV. BY ELEV.
BLDG TIES - FLR GRADES	PAVT TYPE GRADE CURVE
APRON TYPE WIDTH THICKNESS	GAS LINE LOC SIZE PRESSURE
SIDEWALK TYPE WIDTH THICKNESS	SEPTIC TANK SIZE LOC.
CULVERT TYPE DIA LENGTH	WELL LOCATION

"AS BUILT" CERTIFICATION

I, HEREBY CERTIFY THAT THE CIRCLED GRADES ARE EXISTING FINISH GRADES CHECKED IN FIELD ON 19 BY SURVEYING AND ARE CORRECT TO THE BEST OF MY KNOWLEDGE AND BELIEF

REGISTERED SURVEYOR NO

DIVISIONS			PLAN PREPARED BY:	
NO	DATE	BY	DEBEVEC, SALO & ASSOC, INC	NAME
1				
2				
3			DRAWN BY <u>RJB</u>	SCALE 1" = 20'
4			CHK'D	DATE MAR 15, 72
5			CHK'D	APPROVED
				3528-167