


APPROVED
MADISON TWP. ZONING
Permit: 8677
Zoning Inspector: 012B



Grading Plan Approved
as shown and/or noted
THOMAS P. GILLES, PE
Lake County Engineer

By 7/8/72 310472

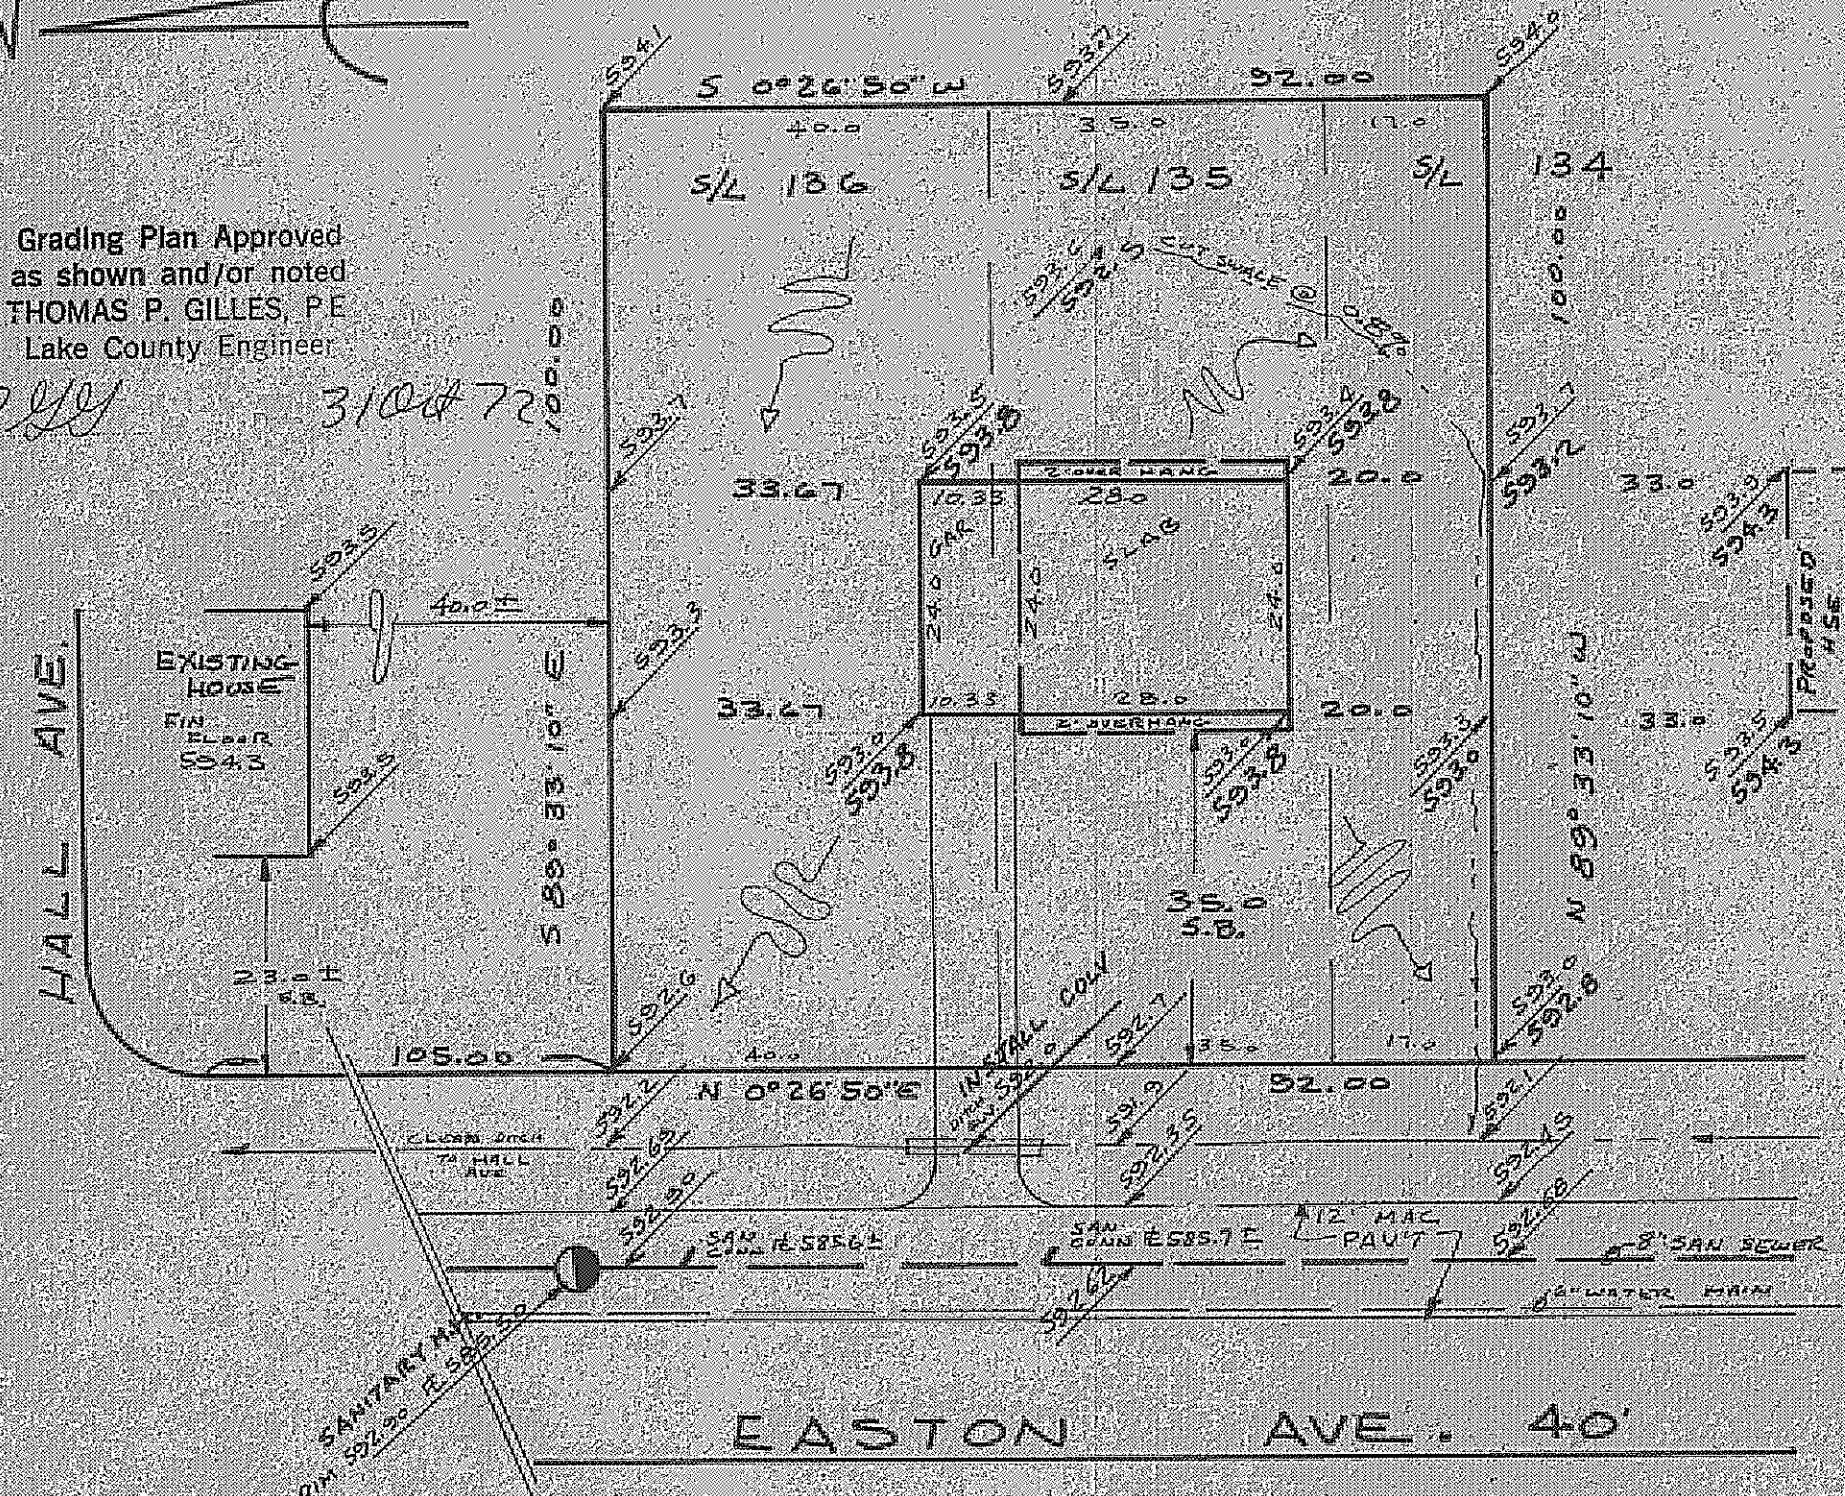

"AS BUILT" CERTIFICATION
I, HEREBY CERTIFY THAT THE CIRCLED GRADES ARE EXISTING FINISH
GRADES CHECKED IN FIELD ON 10/19/72 BY
SURVEYING AND ARE CORRECT TO THE BEST OF MY KNOWLEDGE AND BELIEF

REGISTERED SURVEYOR REG. NO.

SITE PLAN

MADISON LAKE COUNTY, OHIO
TOWNSHIP
for WINSLOW HOMES INC.
CLIENT OWNER
1479 Easton Ave. Madison Ohio
ADDRESS STREET CITY ZIP

MADISON LAKELAND
SUBDIVISION D-27 NAME
VOL. PG
136-135 PT. 134 EASTON AVE
SUBLOT NO. STREET

LEGEND

SANITARY MANHOLE - - - - -	WATER VALVE (GAS) - - - - -
STORM MANHOLE - - - - -	WATER METER (GAS) - - - - -
INLET OR CATCH BASIN - - - - -	AS BUILT ELEVATION
HYDRANT - - - - -	DIRECTION OF SURFACE DRAINAGE
EXISTING CONTOURS - - - - -	
PROPOSED CONTOURS - - - - -	
EXIST. ELEV. - 100.0	
100.0 - PROP. ELEV.	

REMARKS
ALL BOUNDARY DATA SHOWN WAS OBTAINED FROM (DEEDS, RECORDED
SUBDIVISION PLAT, OR OTHER PUBLIC RECORDS)

DESIGN CERTIFICATION
THIS PLAT WAS PREPARED BY ME, AND IS CORRECT
TO THE BEST OF MY KNOWLEDGE AND BELIEF
Richard J. DeBevec PS # 5244
NAME SURVEYOR REGISTRATION NO.

CHECK LIST			
DIMENSIONS	WATER MAIN SIZE	LOCATION	
BEARINGS	SAN SEWER SIZE	% GR LOC	
TIE TO NEAREST STREET	SAN MH CAST ELEV	INVELEV	
SUBLOT NO	SAN CONN SIZE	LOC. DEPTH	
PARCEL NO	STORM SEWER SIZE	% GR LOC	
SURROUNDING OWNERS	STORM MH CAST ELEV	INVELEV	
BLOG DIMENSIONS	PAVT TYPE	GRADE CURBS	
BLOG TIES	GASLINE LOC	SIZE PRESSURE	
APRON TYPE	SEPTIC TANK SIZE	LOC	
WIDTH THICKNESS	WELL LOCATION		
SIDEWALK TYPE			
WIDTH THICKNESS			
CULVERT TYPE			
DIA LENGTH			

REVISIONS			PLAN PREPARED BY:	
NO	DATE	BY	DE BEVEC, JALO & ASSOC, INC.	NAME
1			130 EAST JACKSON ST, PAINESVILLE	ADDRESS
2				
3			DRAWN BY <u>RJB</u>	SCALE 1"=20'
4			CHKD	DATE <u>OCT. 21, 72</u>
5			CREW CHIEF	PHONE NO. <u>3672-134</u>